


PLAN	DATE	
	BY	
	NOTED	
	NO.	

PROFILE	DATE	
	BY	
	NOTED	
	NO.	



RECORD DRAWING

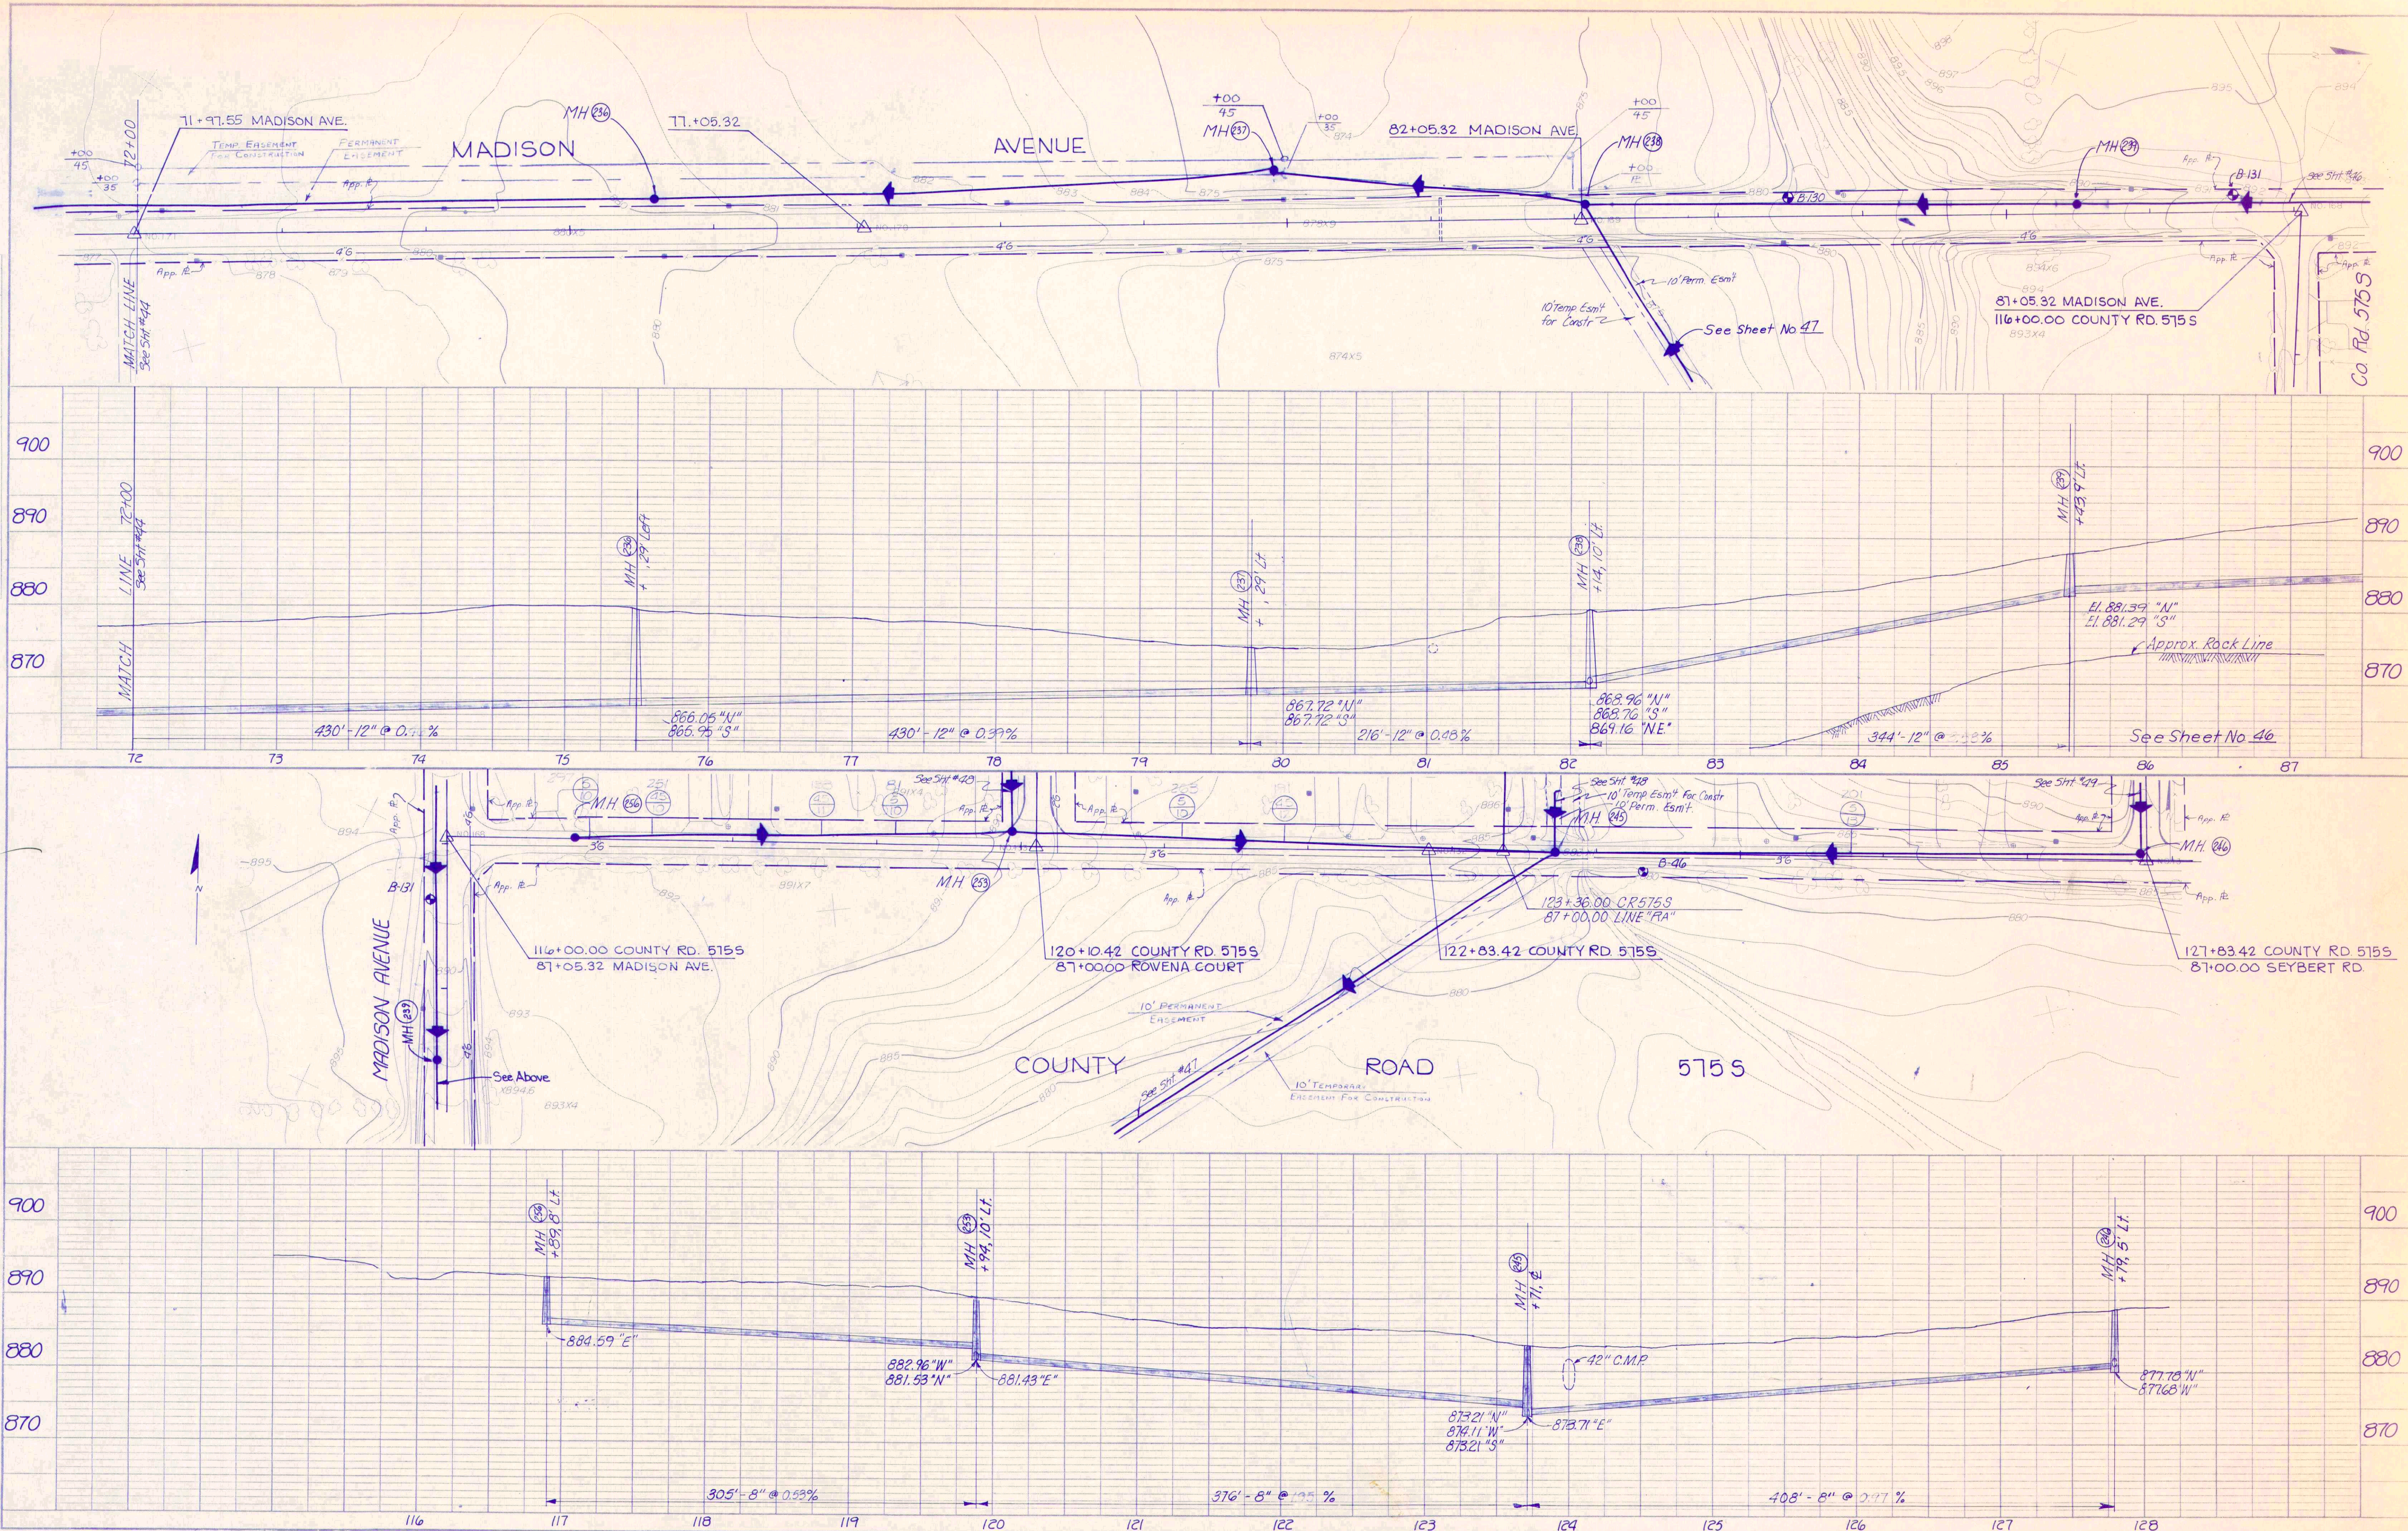