


DATE: _____
 BY: _____
 CHECKED: _____
 PLAN
 1"=50'
 NOTE: BOOK NO. 100-100000
 100-100000

DATE: _____
 BY: _____
 CHECKED: _____
 PROFILE
 1"=10' Vert.
 1"=50' Horiz.
 NOTE: BOOK NO. 100-100000
 100-100000

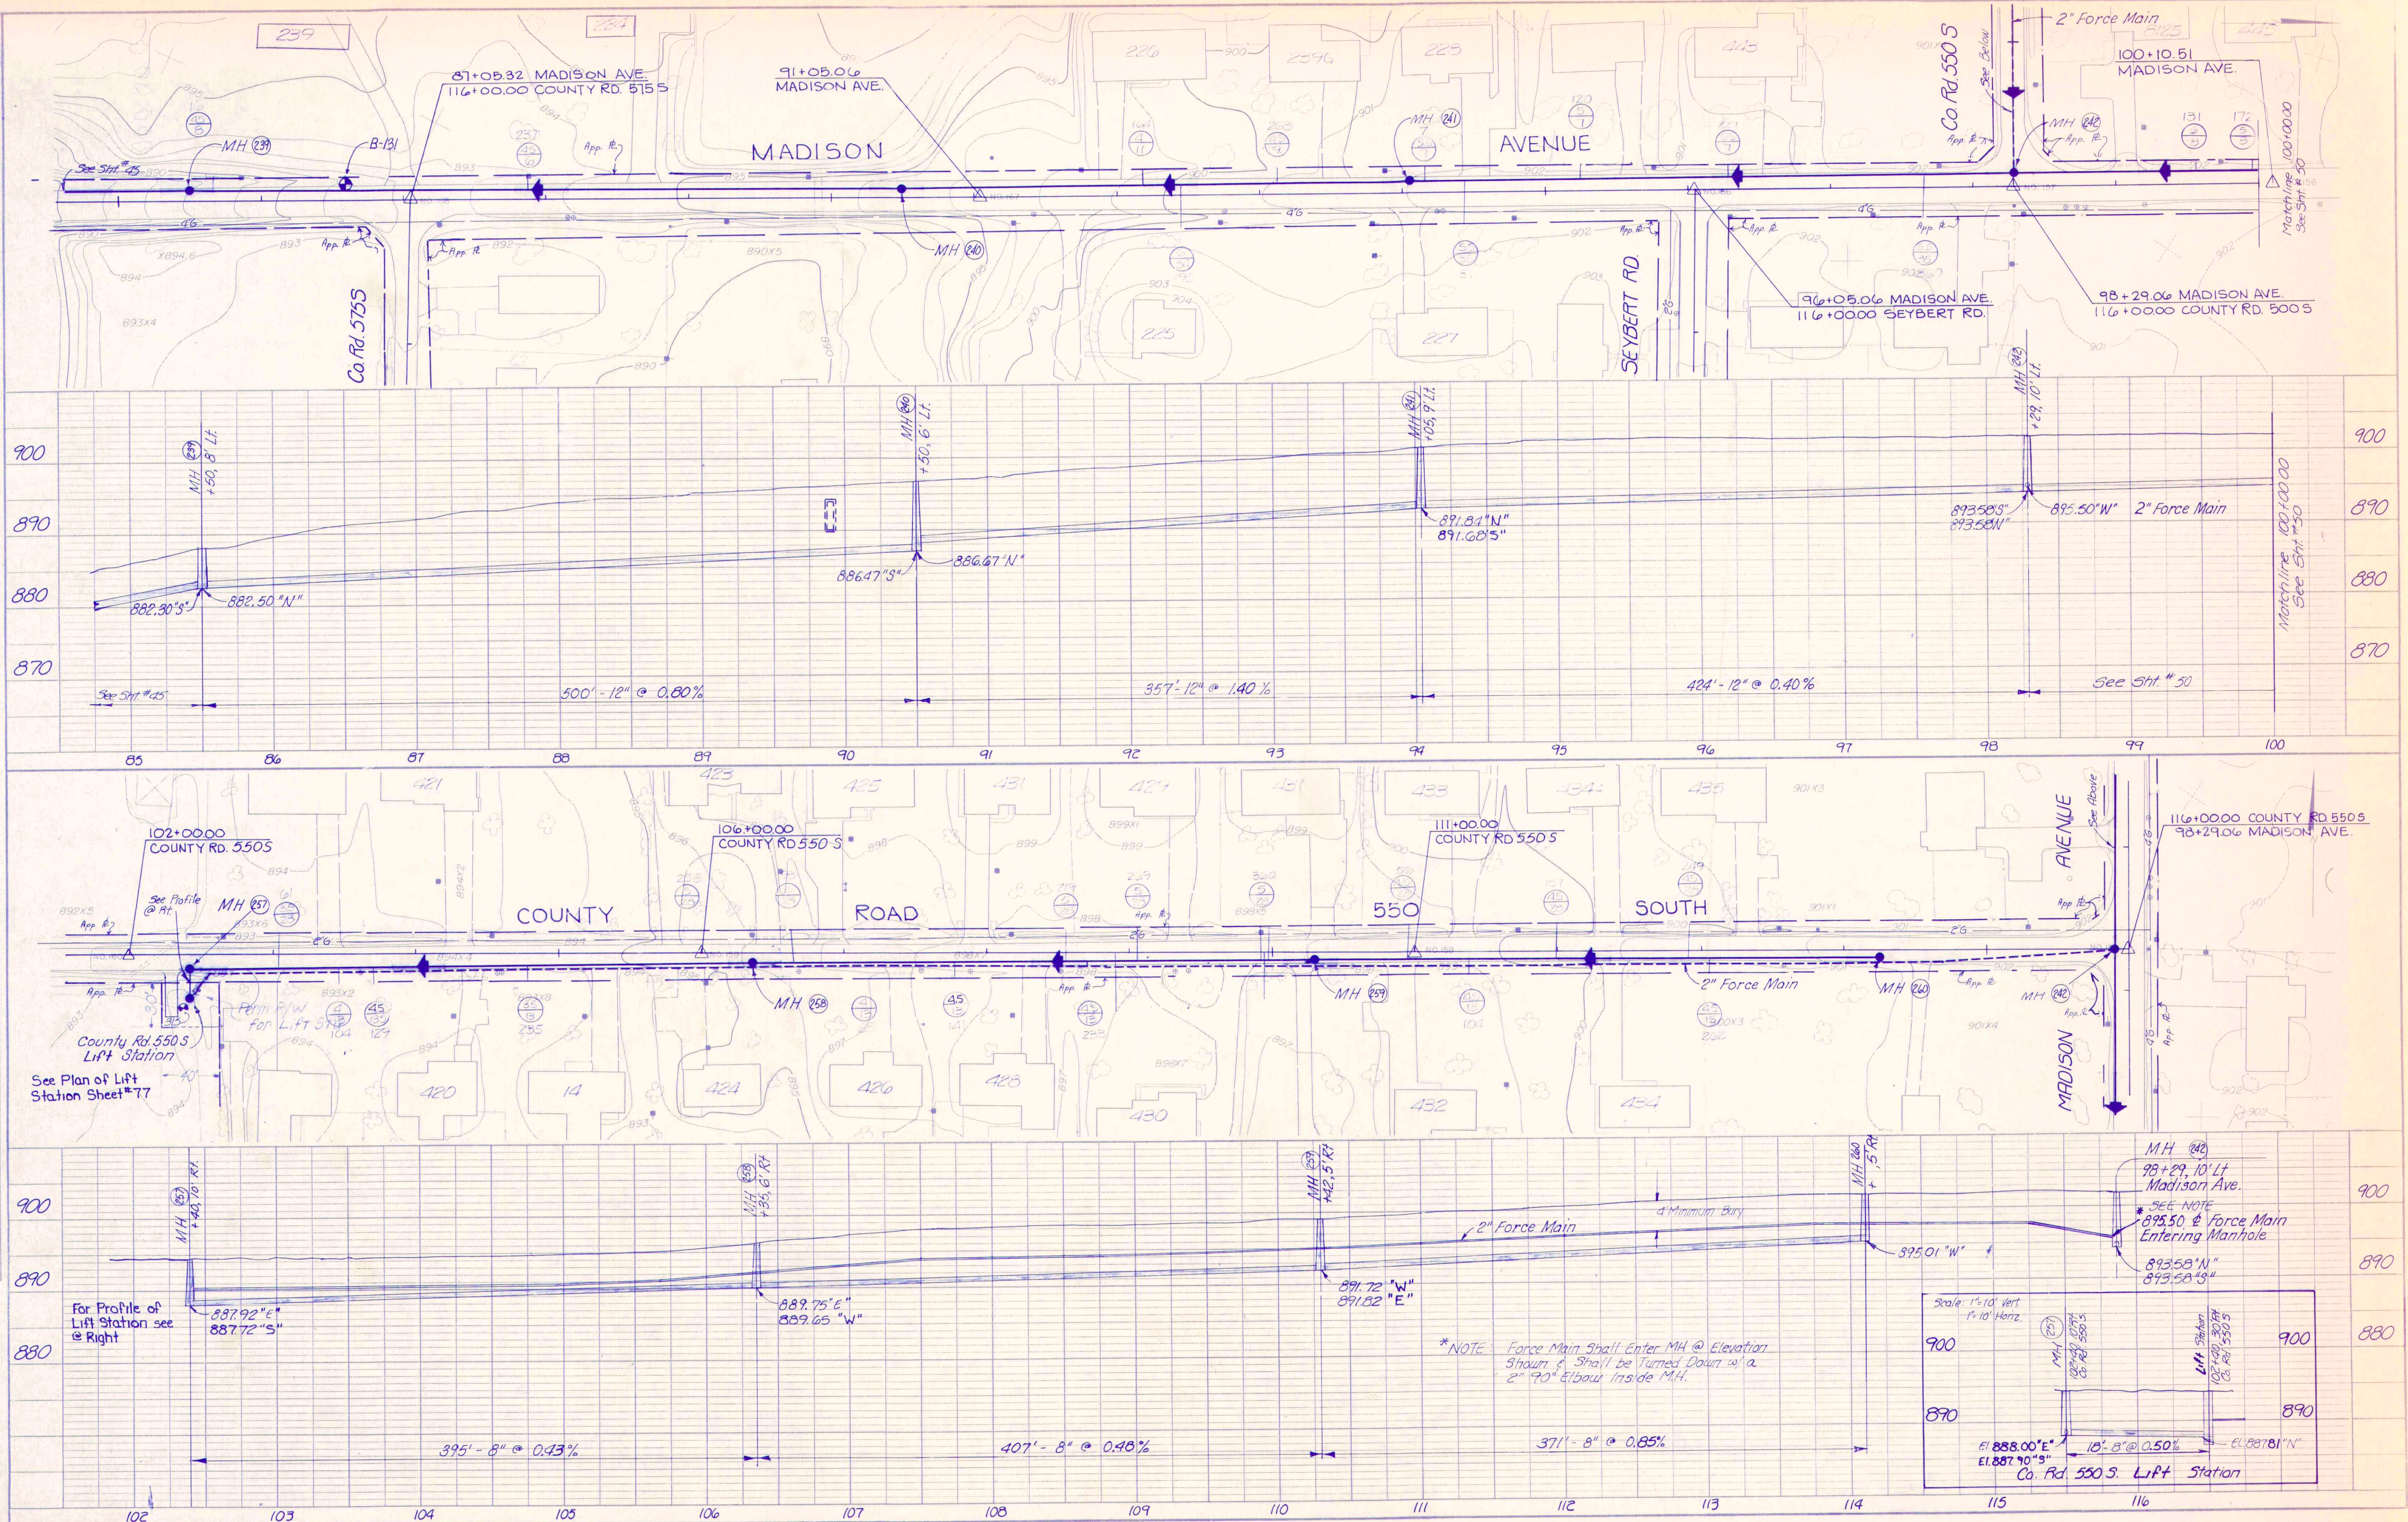

RECORD DRAWING