


PLAN	DATE	
	BY	
	REVIEWED	
	NOTE BOOK	
ALIGNMENT CHECKED		
RT. OF WAY CHECKED		
NO.		

PROFILE	DATE	
	BY	
	REVIEWED	
	NOTE BOOK	
GRADES CHECKED		
S.M. NOTED		
STRUCTURE NOTATIONS		
NO.		

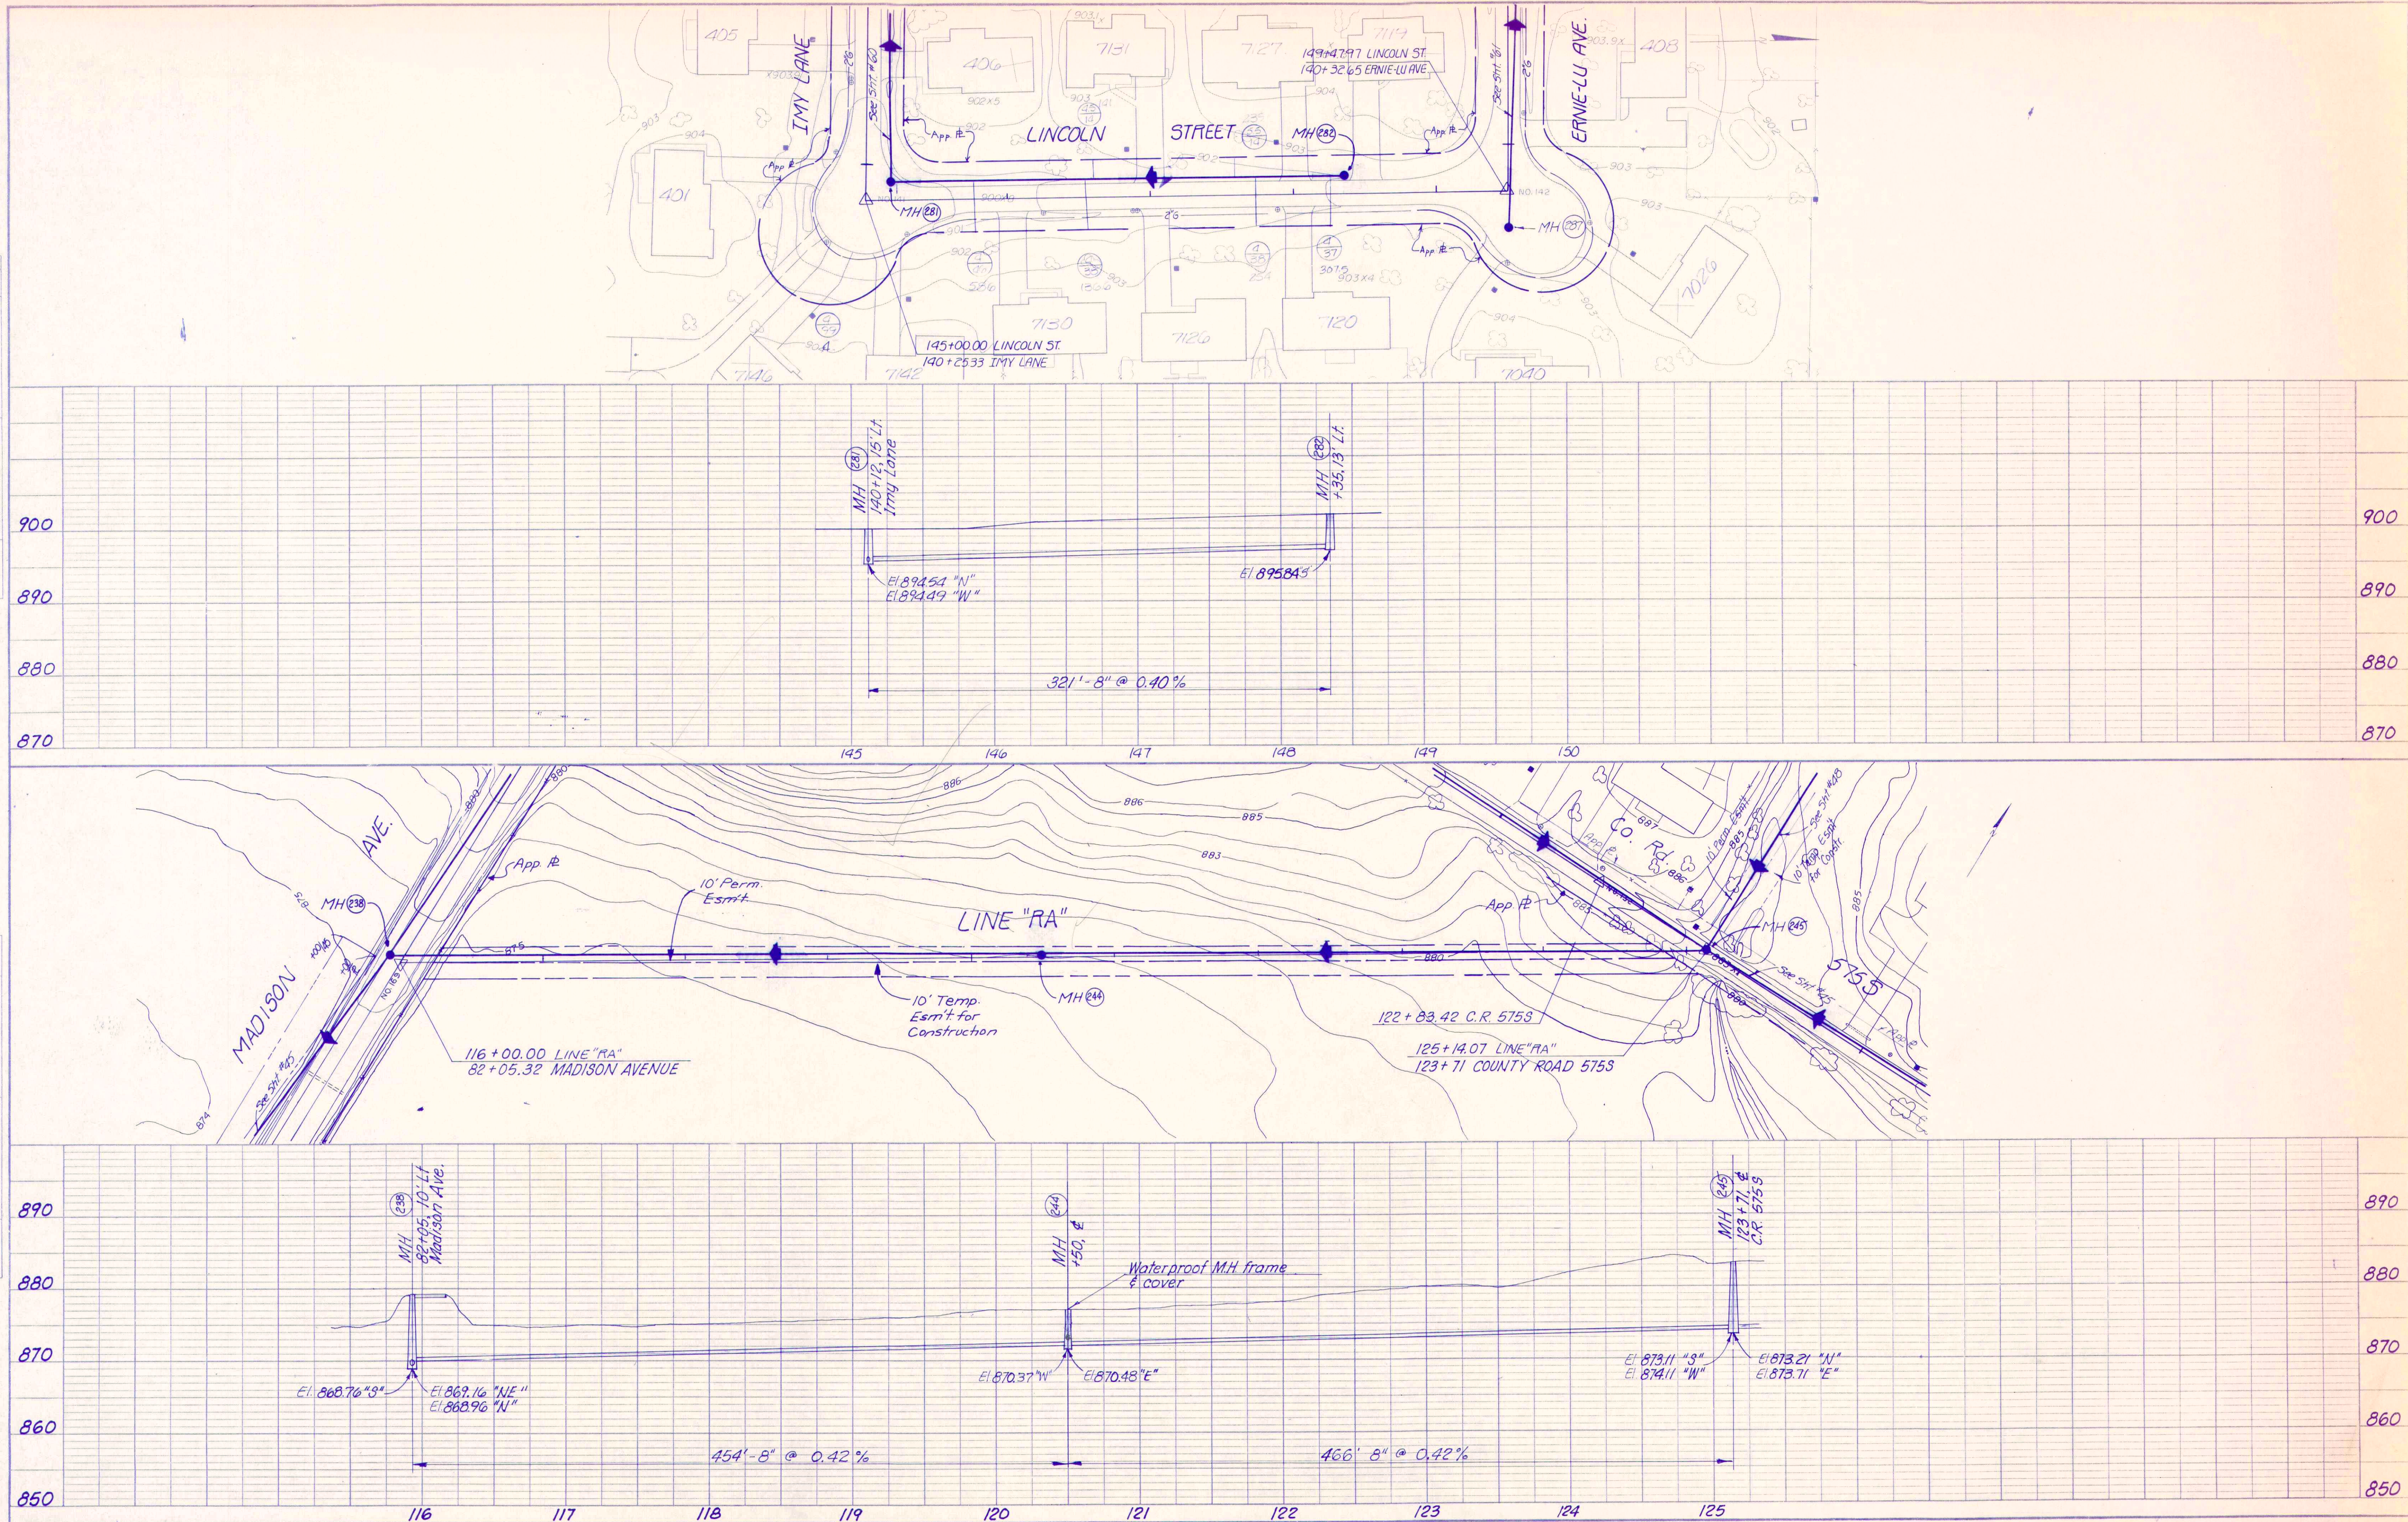

RECORD DRAWING

LINCOLN ST - LINE "RA"

FALL CREEK R.W.D. PLAN & PROFILE SHEET
HORIZ. 1"=50'
VERT. 1"=10'

BEAM, LONGEST & NEFF, INC.
CONSULTING ENGINEERS
INDIANAPOLIS, INDIANA

47