
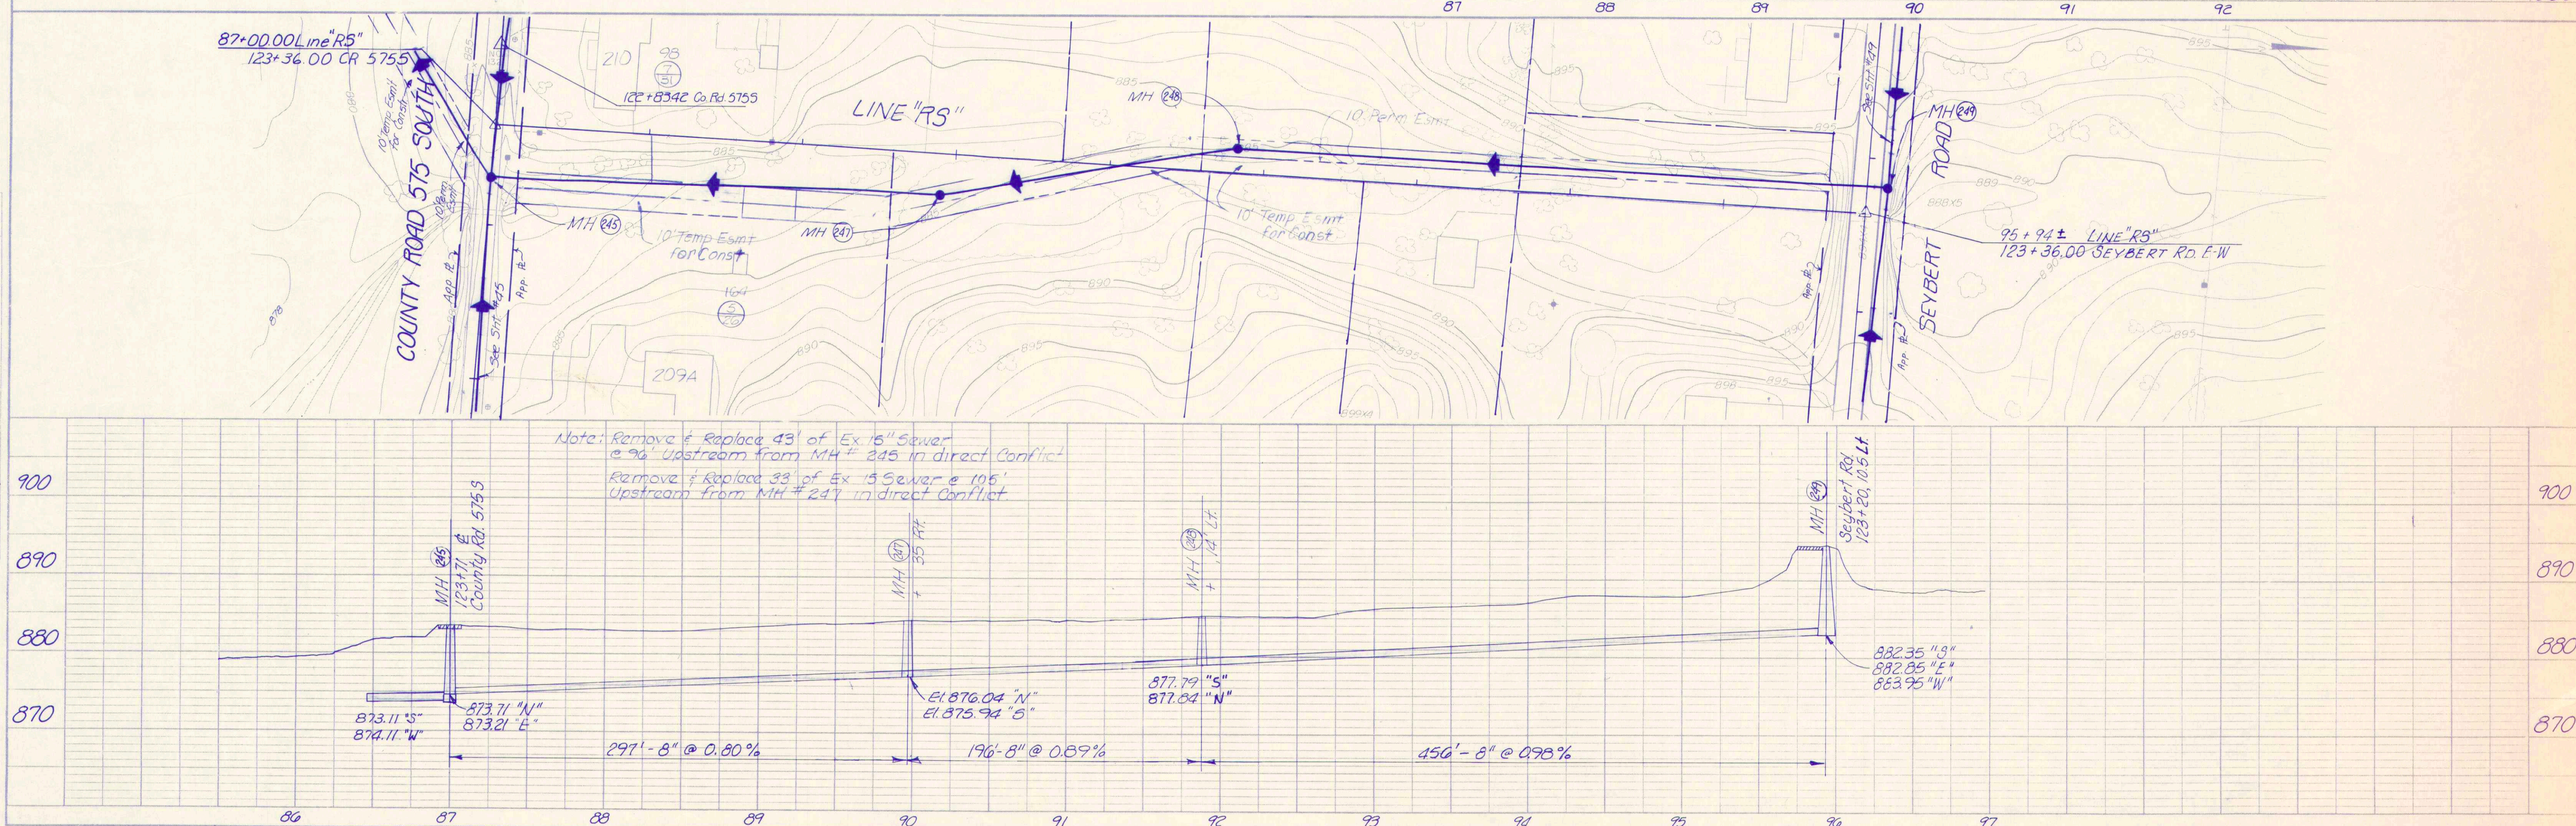
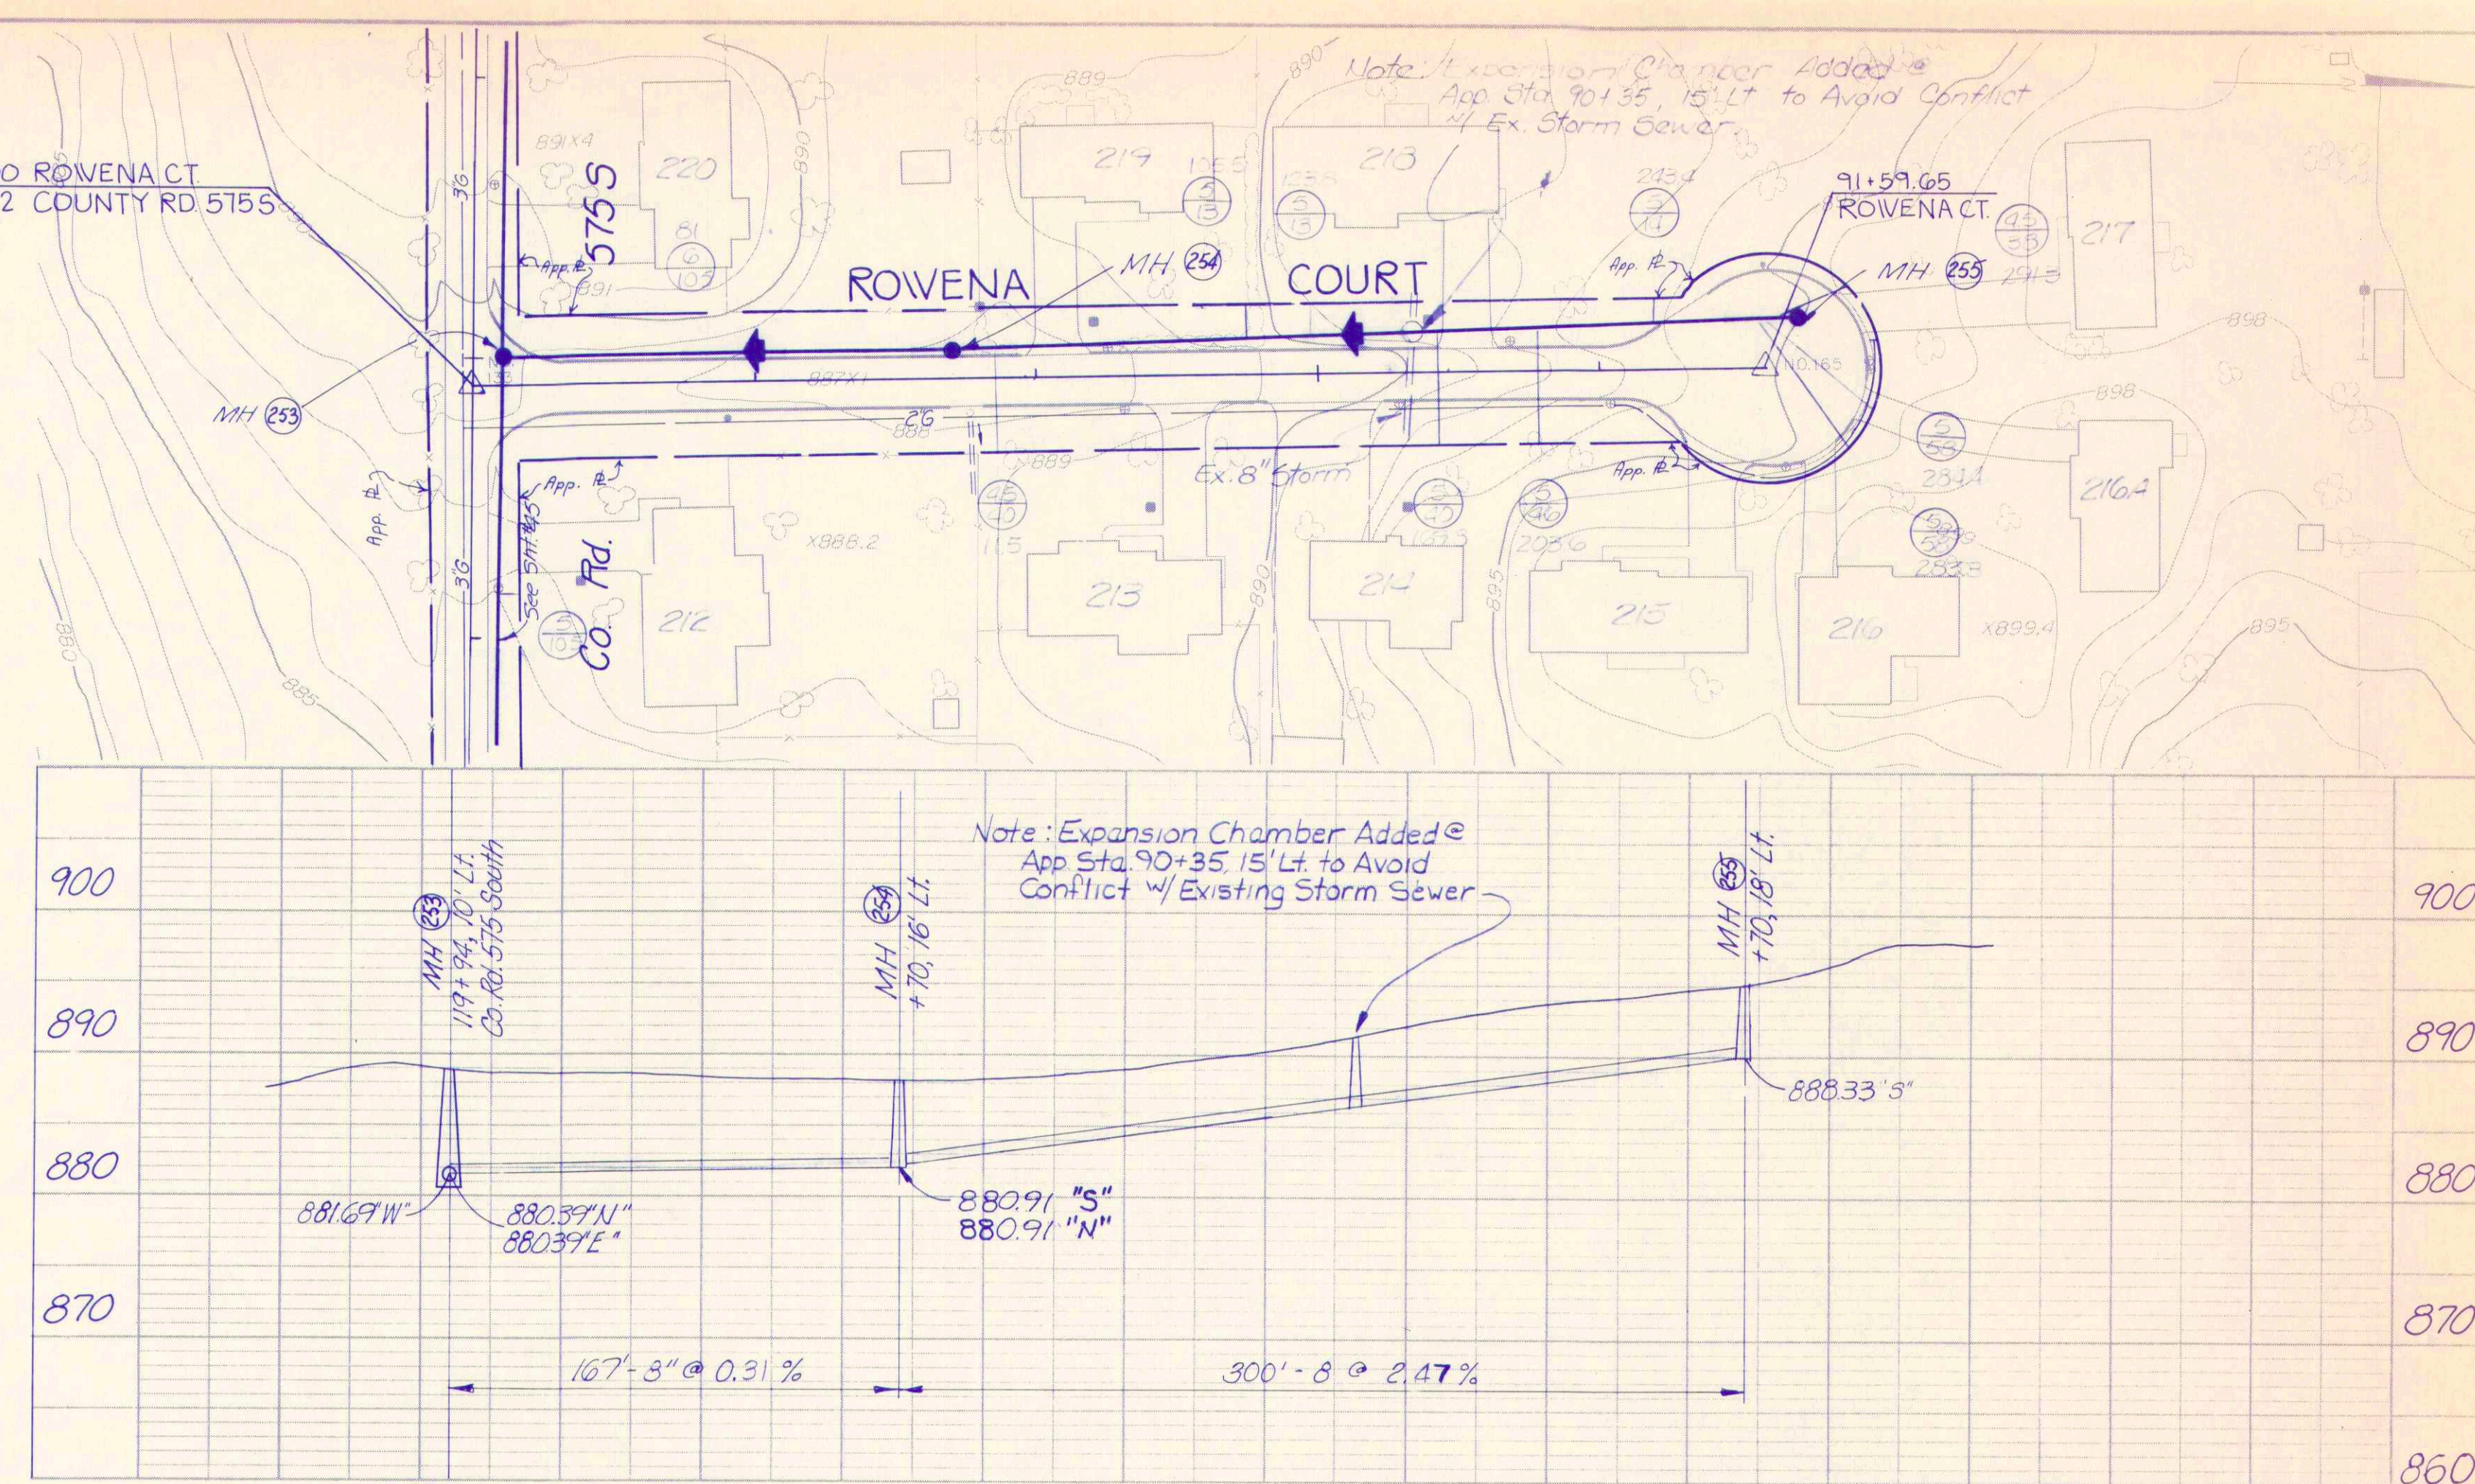


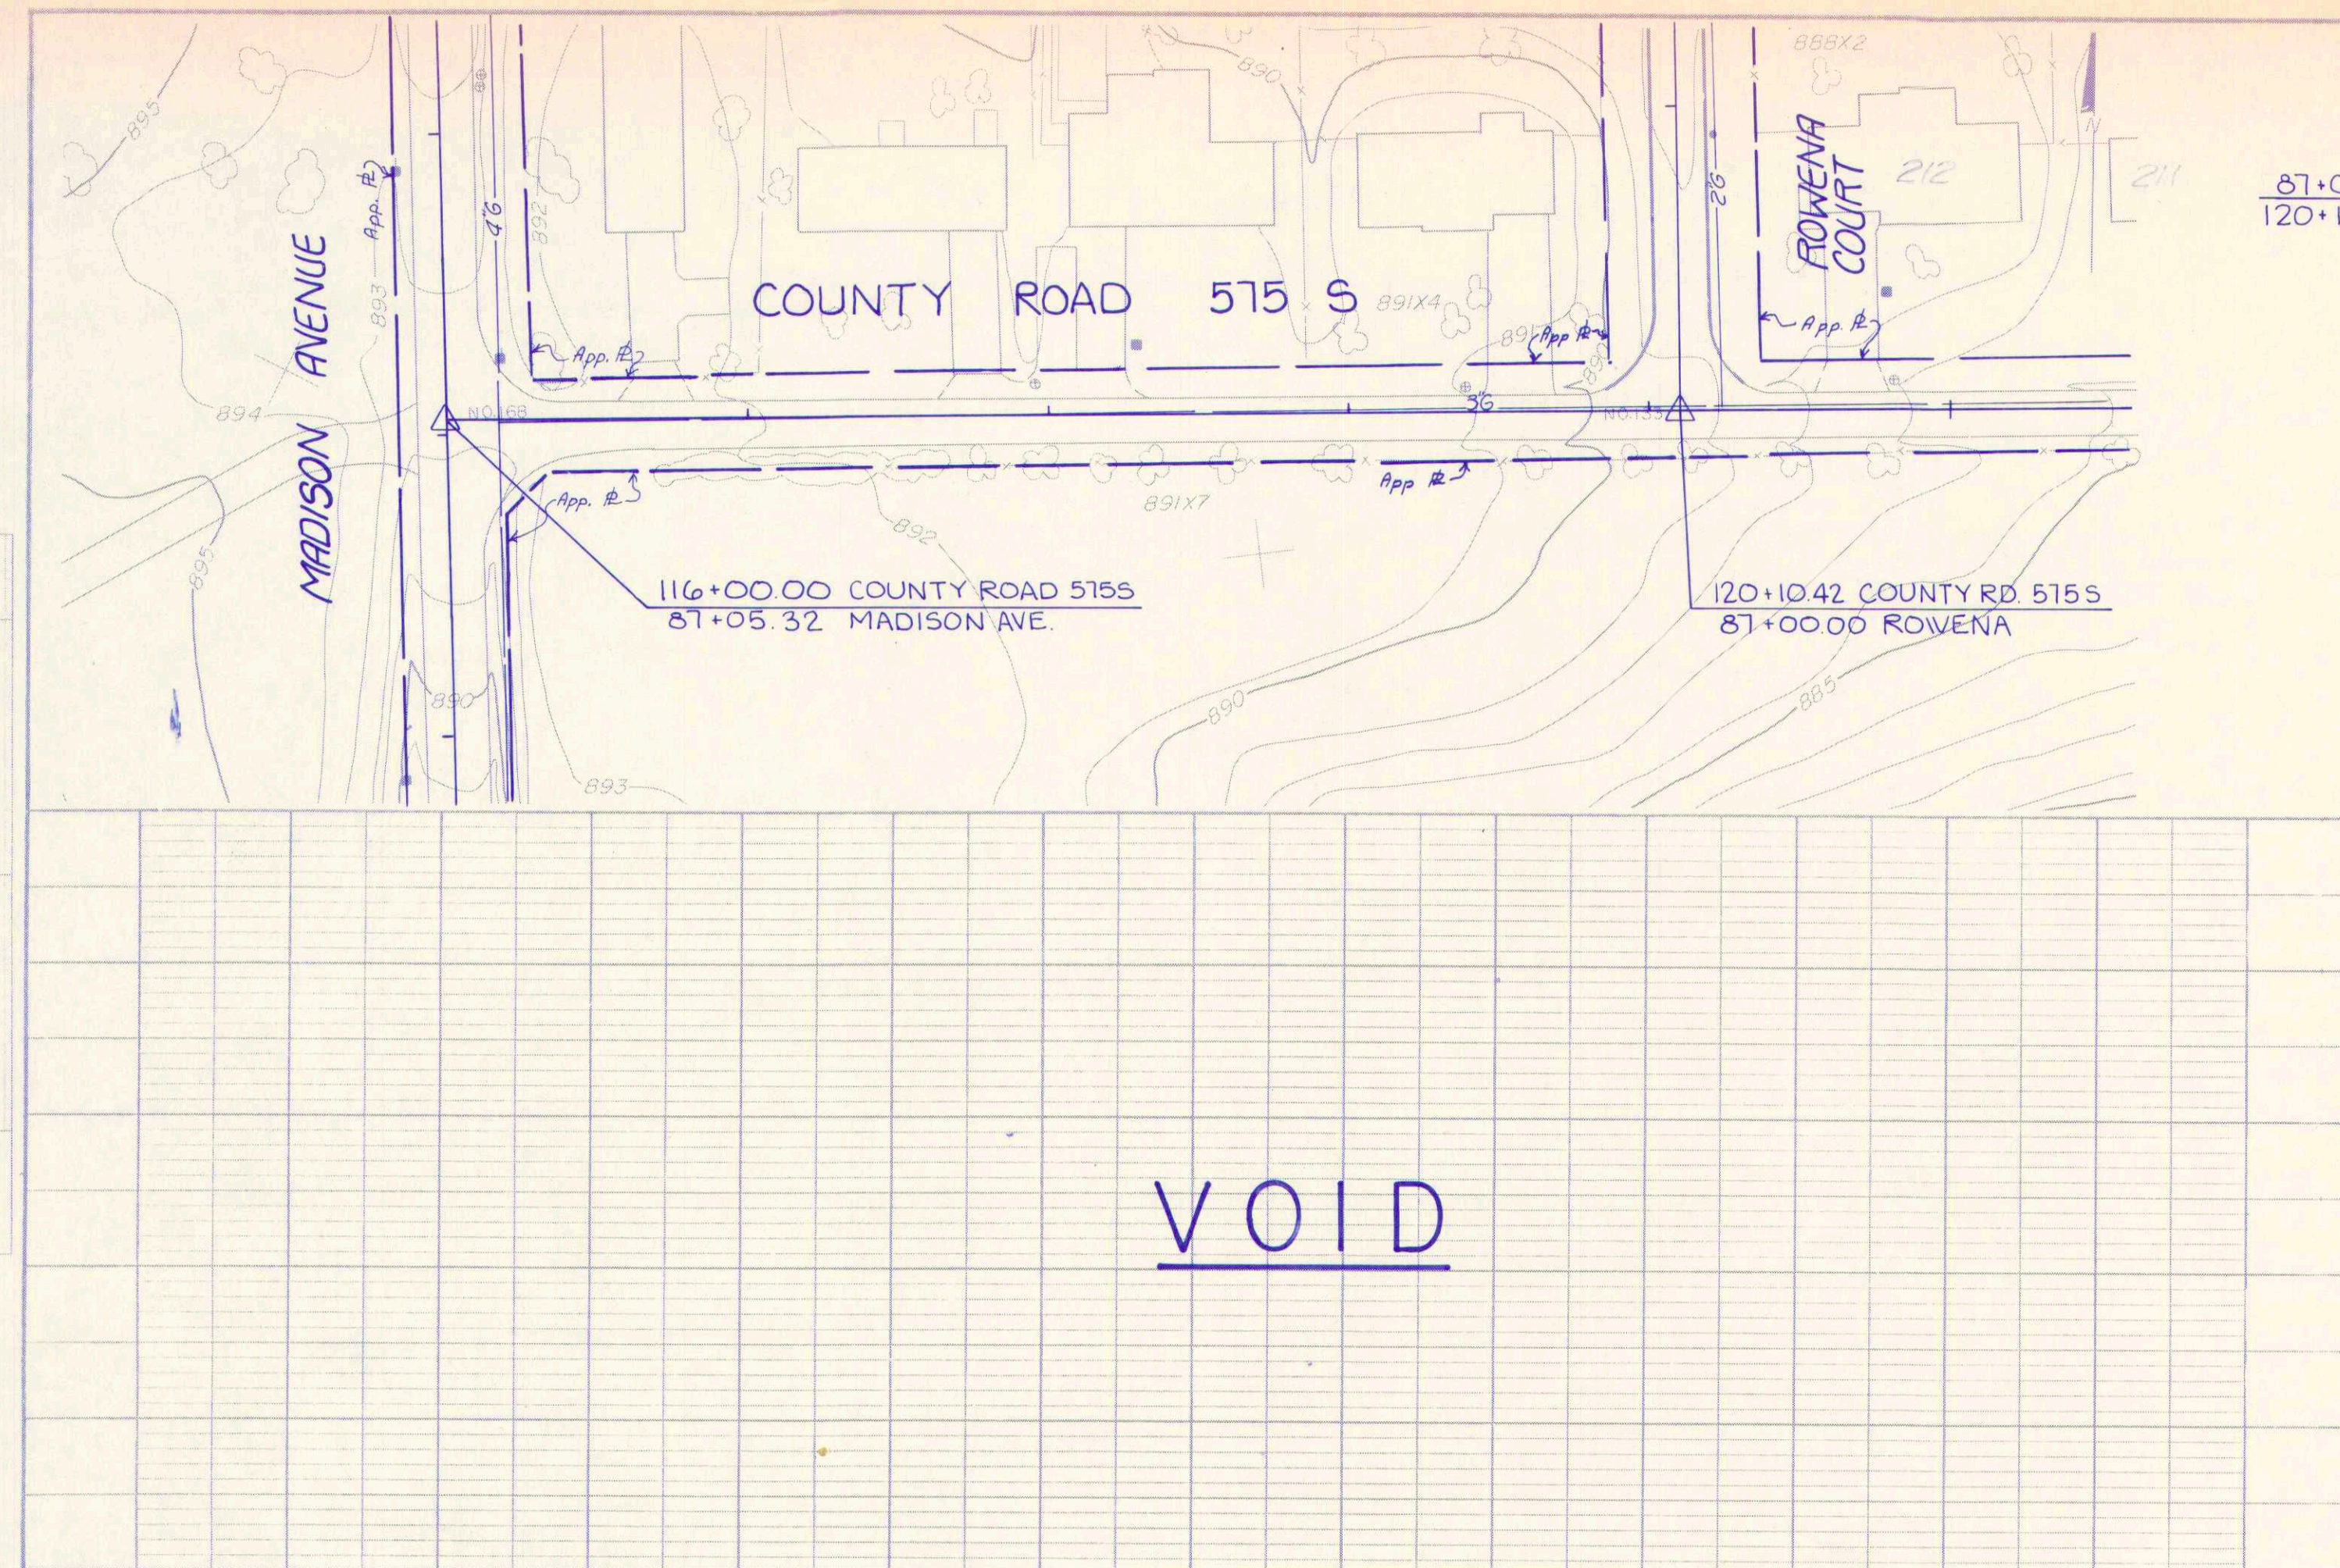

RECORD DRAWING

Co. Rd. 5755/ ROWENA CT. LINE "RS"		
FALL CREEK R.W.D. PLAN & PROFILE		SHEET
HORIZ. 1"=50'	BEAM, LONGEST & NEFF, INC. CONSULTING ENGINEERS INDIANAPOLIS, INDIANA	48
VERT. 1"=10'		