



PLAN	DATE	
	BY	
	REVISION	
	NO.	
NOTE BOOK ALIGNMENT CHECKED ET. OF WAY CHECKED		

PROFILE	DATE	
	BY	
	REVISION	
	NO.	
NOTE BOOK GRADES CHECKED STRUCTURE NOTATIONS CHECKED		

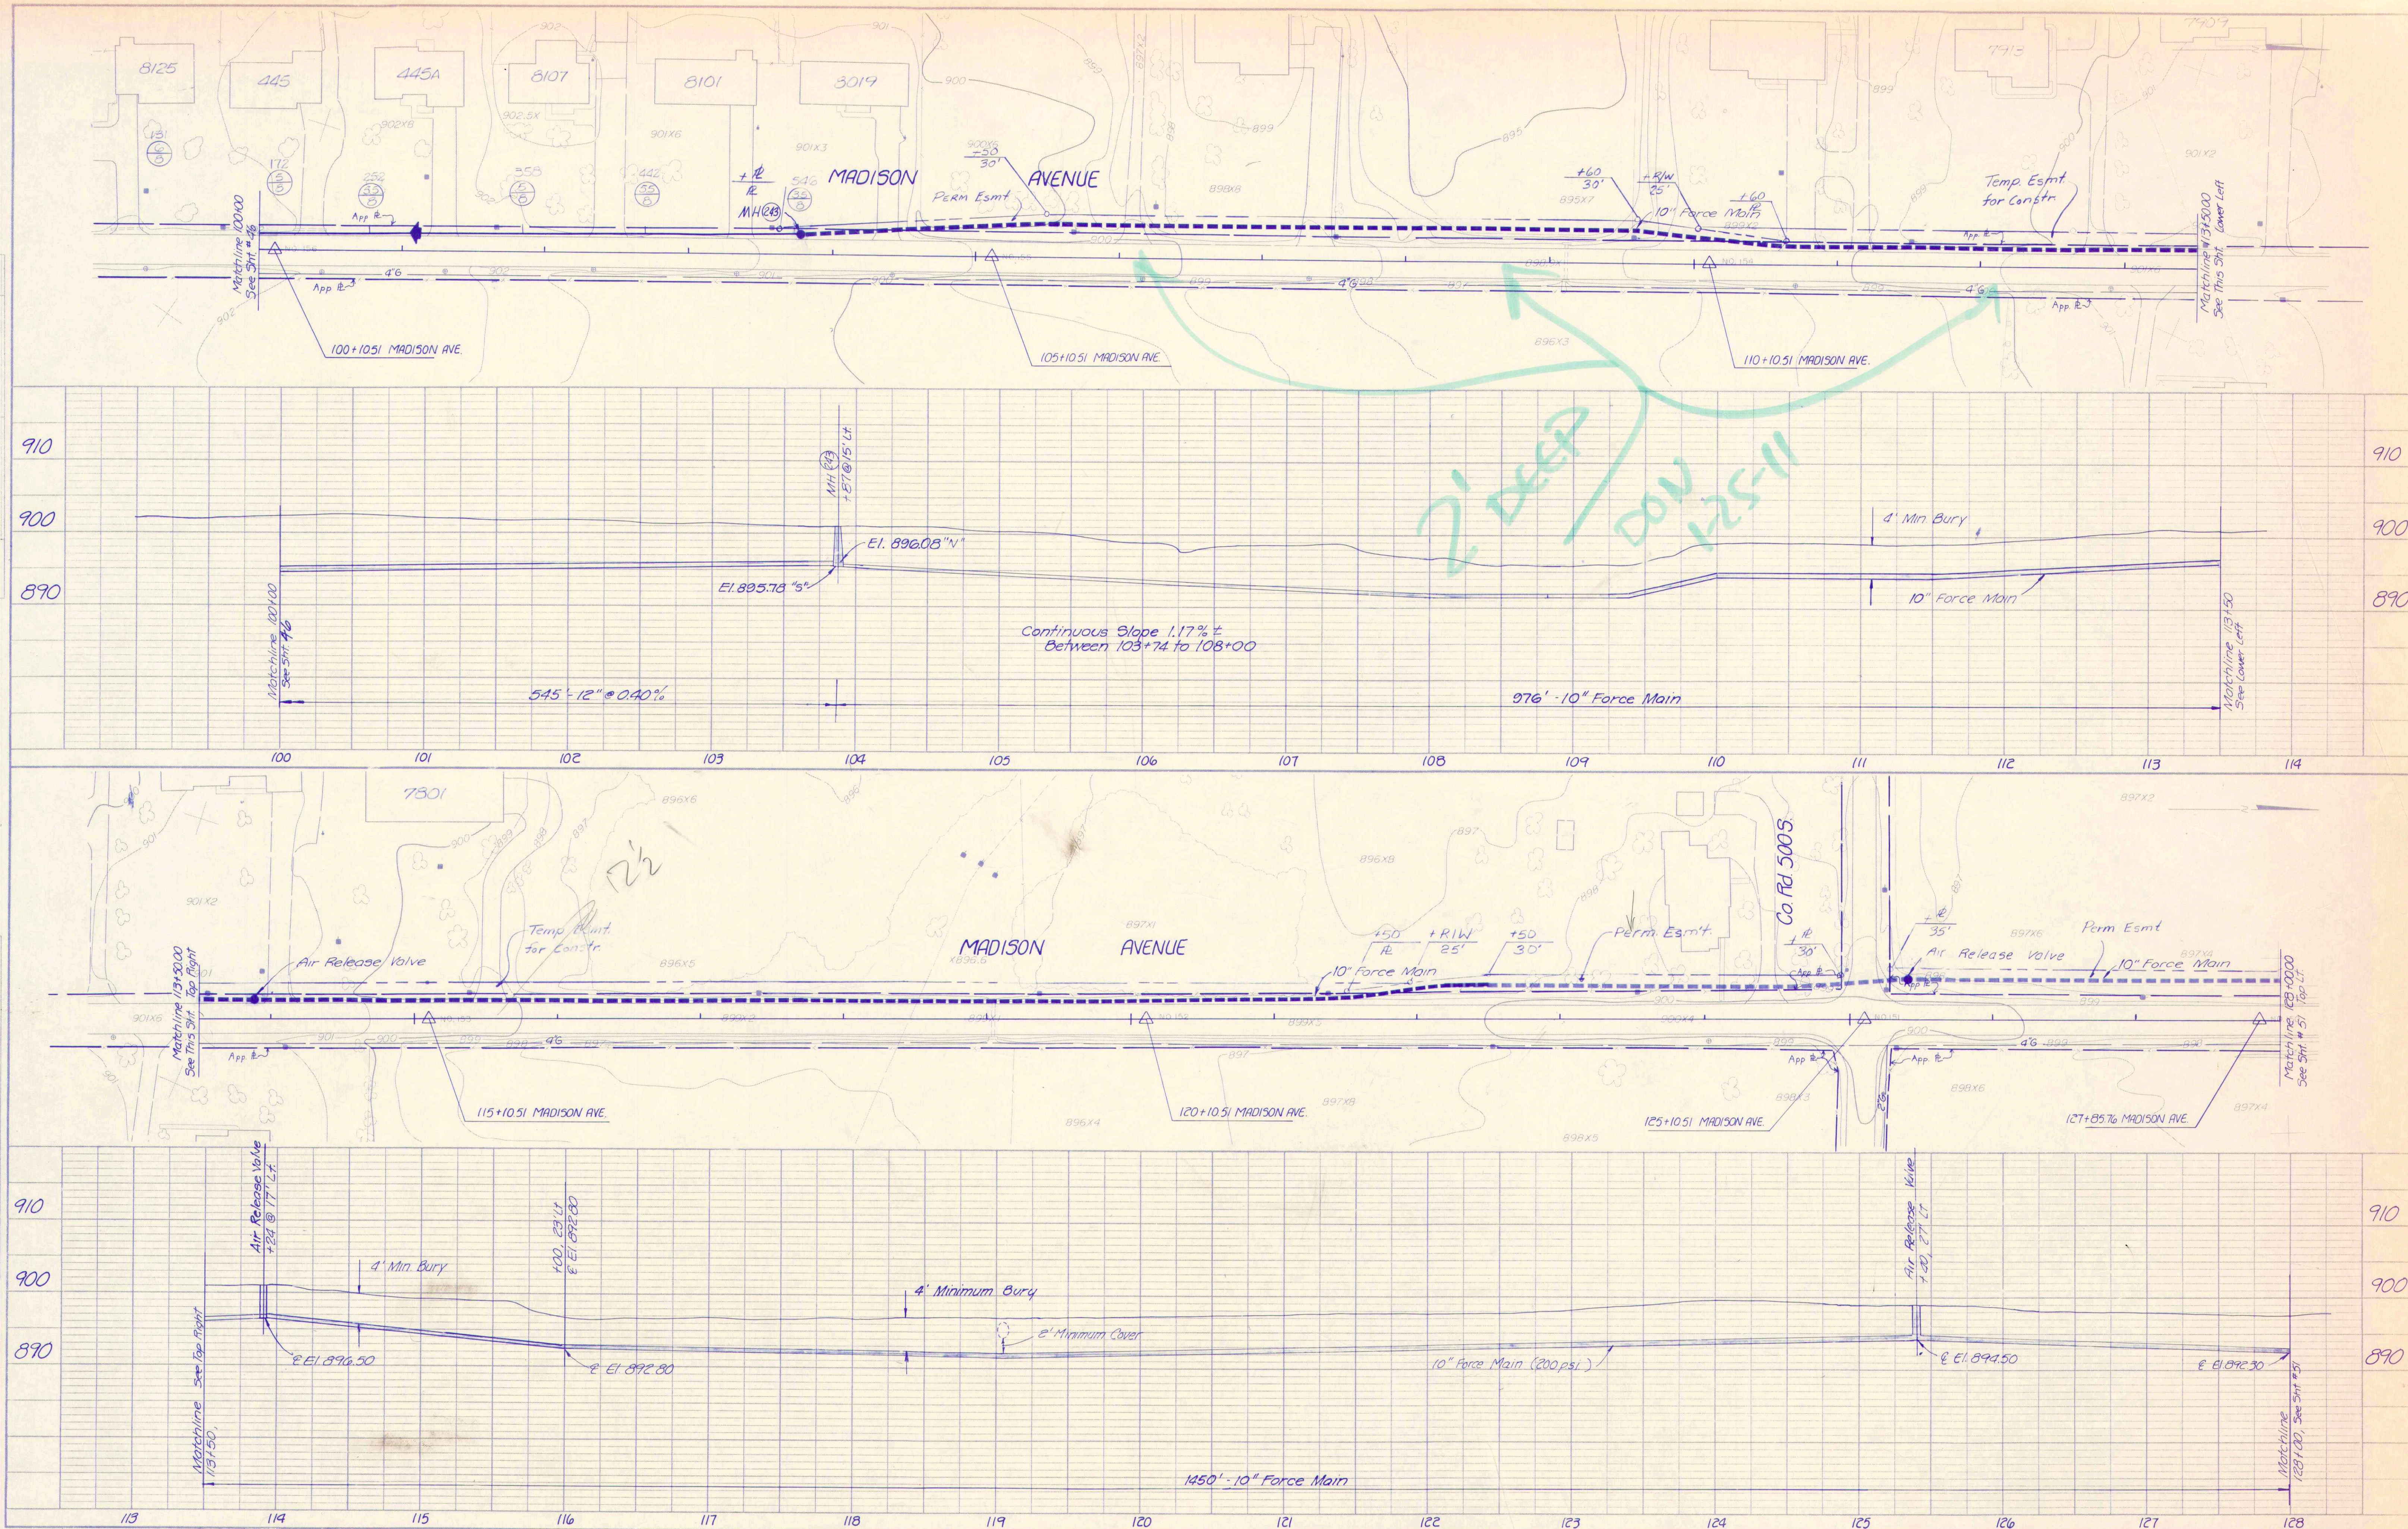

RECORD DRAWING

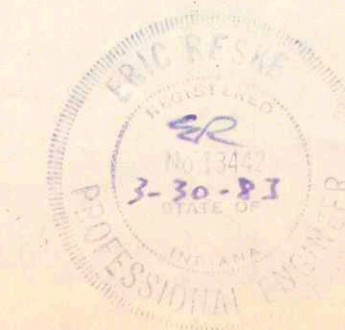

MADISON AVENUE		SHEET 50
FALL CREEK R.W.D. PLAN & PROFILE		
HORIZ. 1"=50'	BEAM, LONGEST & NEFF, INC.	
VERT. 1"=10'	CONSULTING ENGINEERS INDIANAPOLIS, INDIANA	