


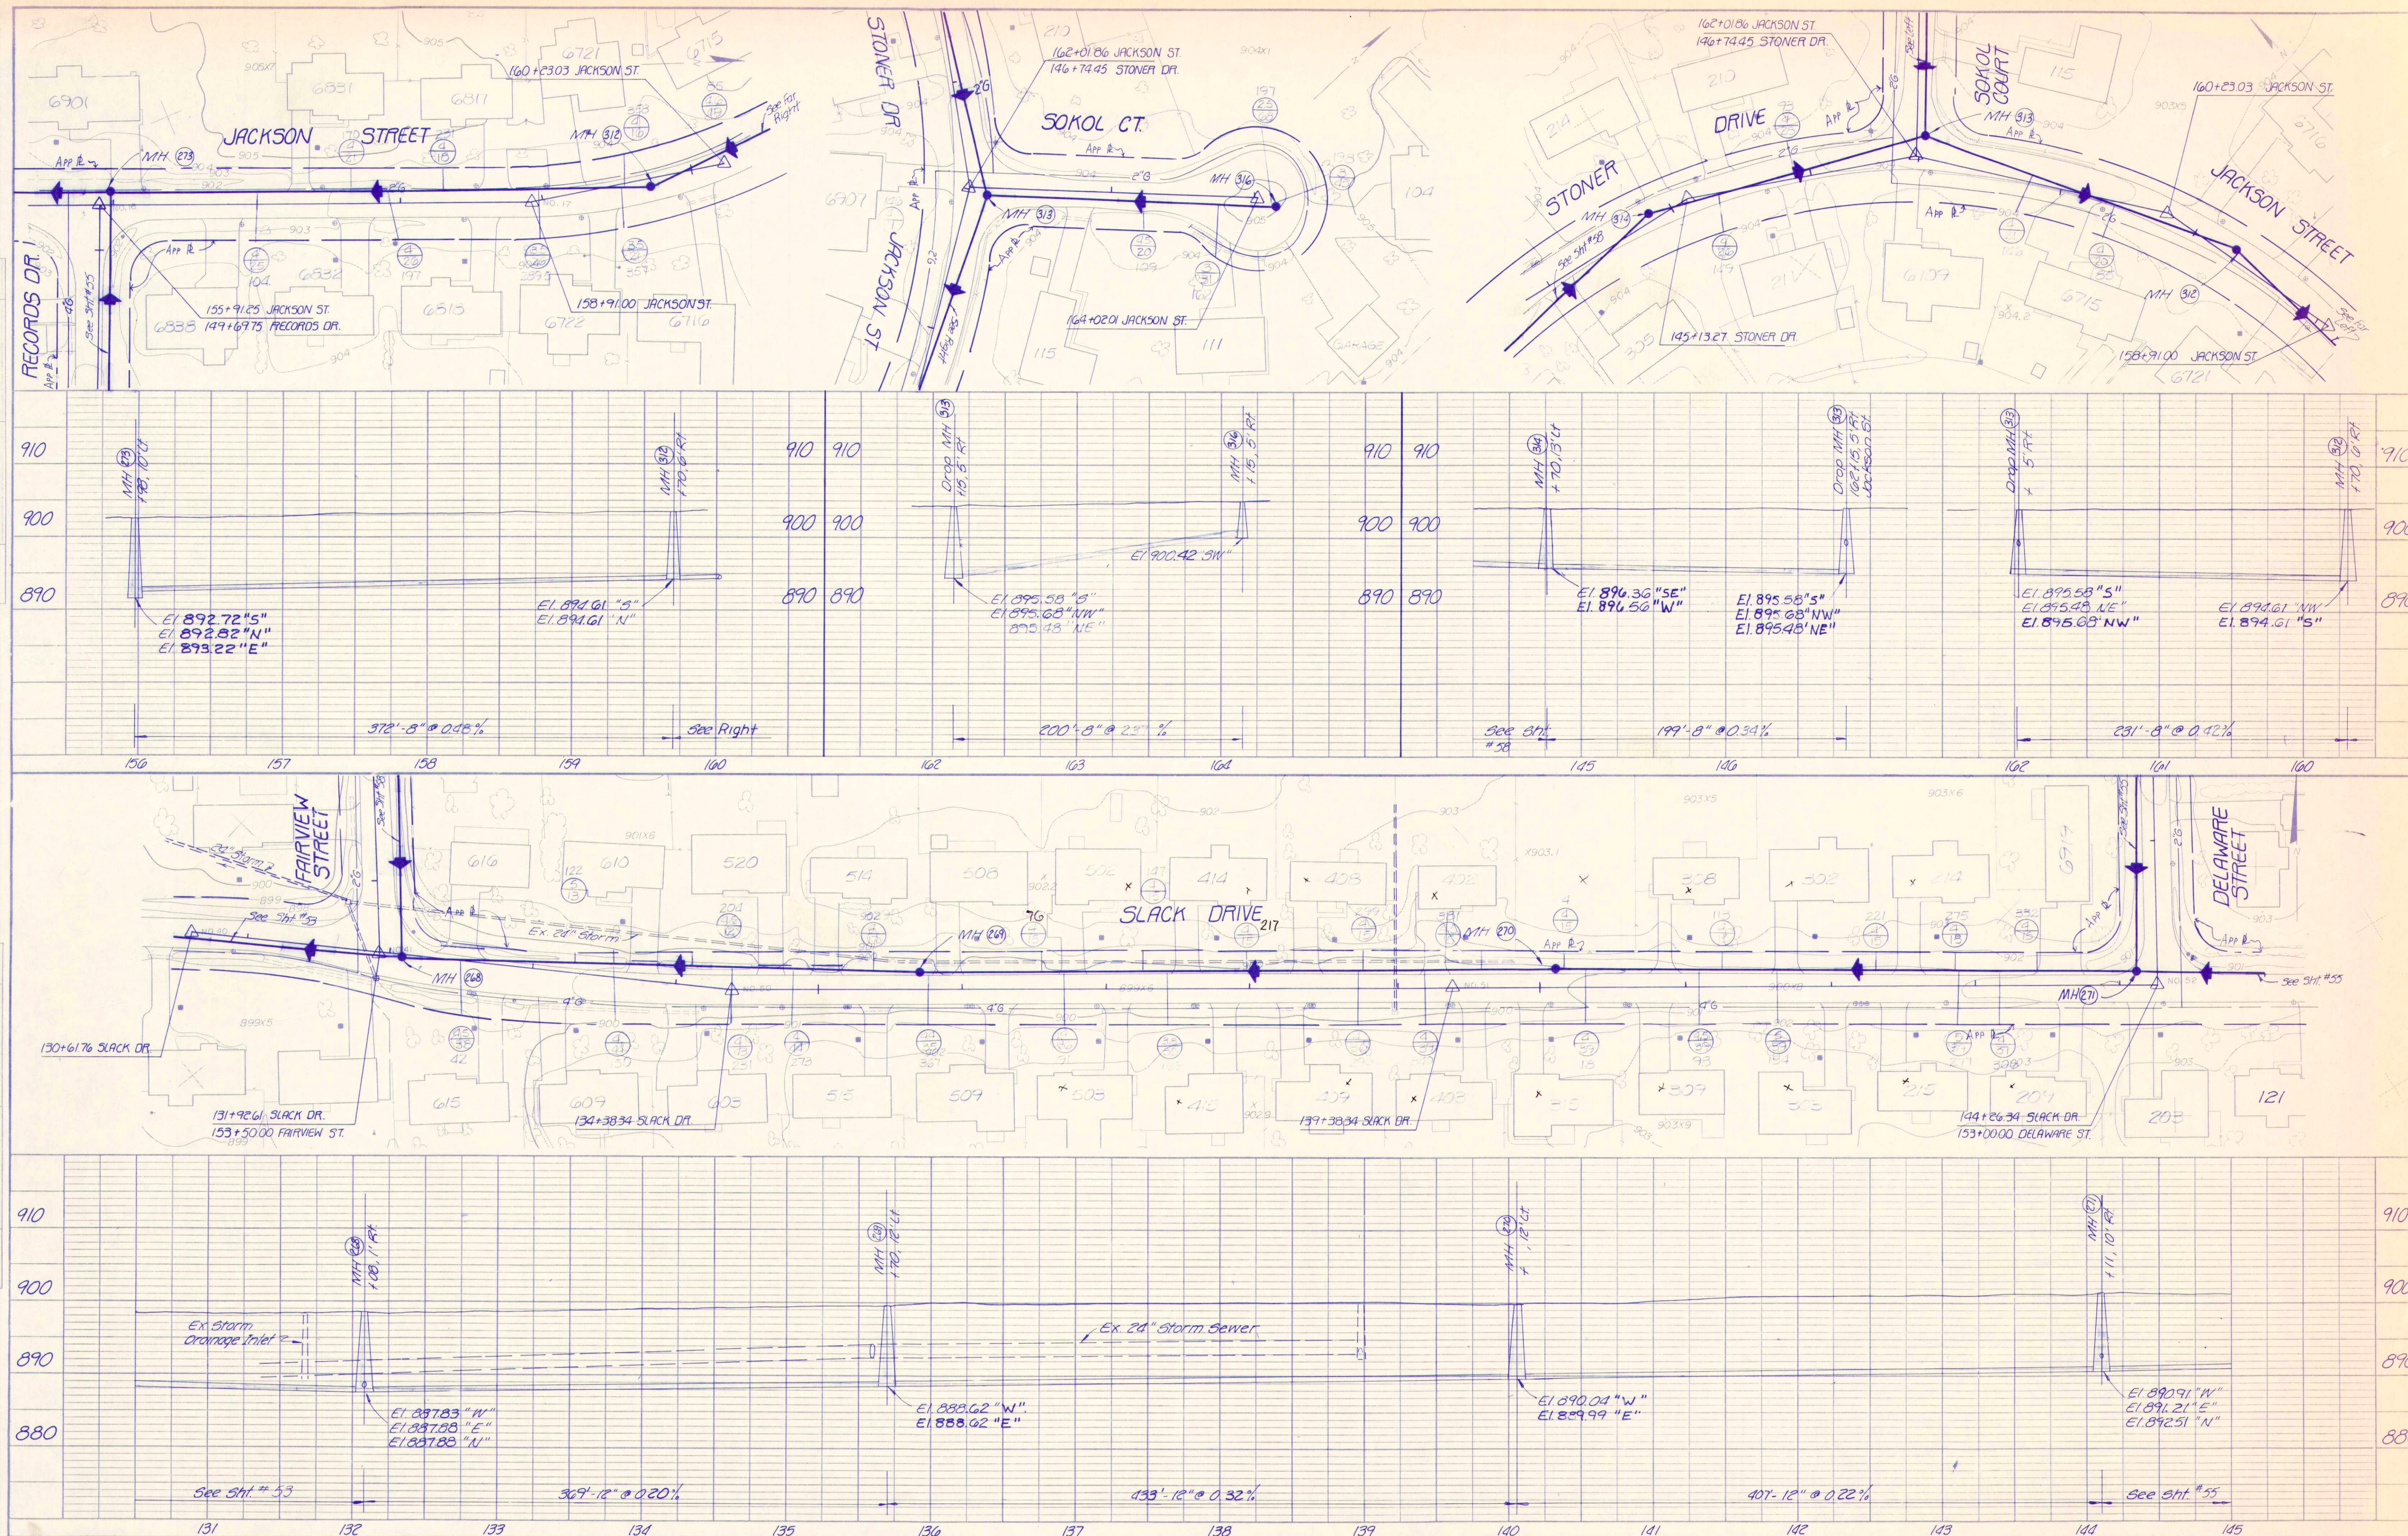

RECORD DRAWING

JACKSON ST / STONER DR. SLACK DR.		
FALL CREEK R.W.D. PLAN & PROFILE		SHE
HORIZ. 1"=50'	BEAM, LONGEST & NEFF, INC.	
VERT. 1"=10'	CONSULTING ENGINEERS INDIANAPOLIS, INDIANA	5