


PLAN	DATE	
	BY	
	SURVEYED	
	NOTED	

PROFILE	DATE	
	BY	
	SURVEYED	
	NOTED	



RECORD DRAWING

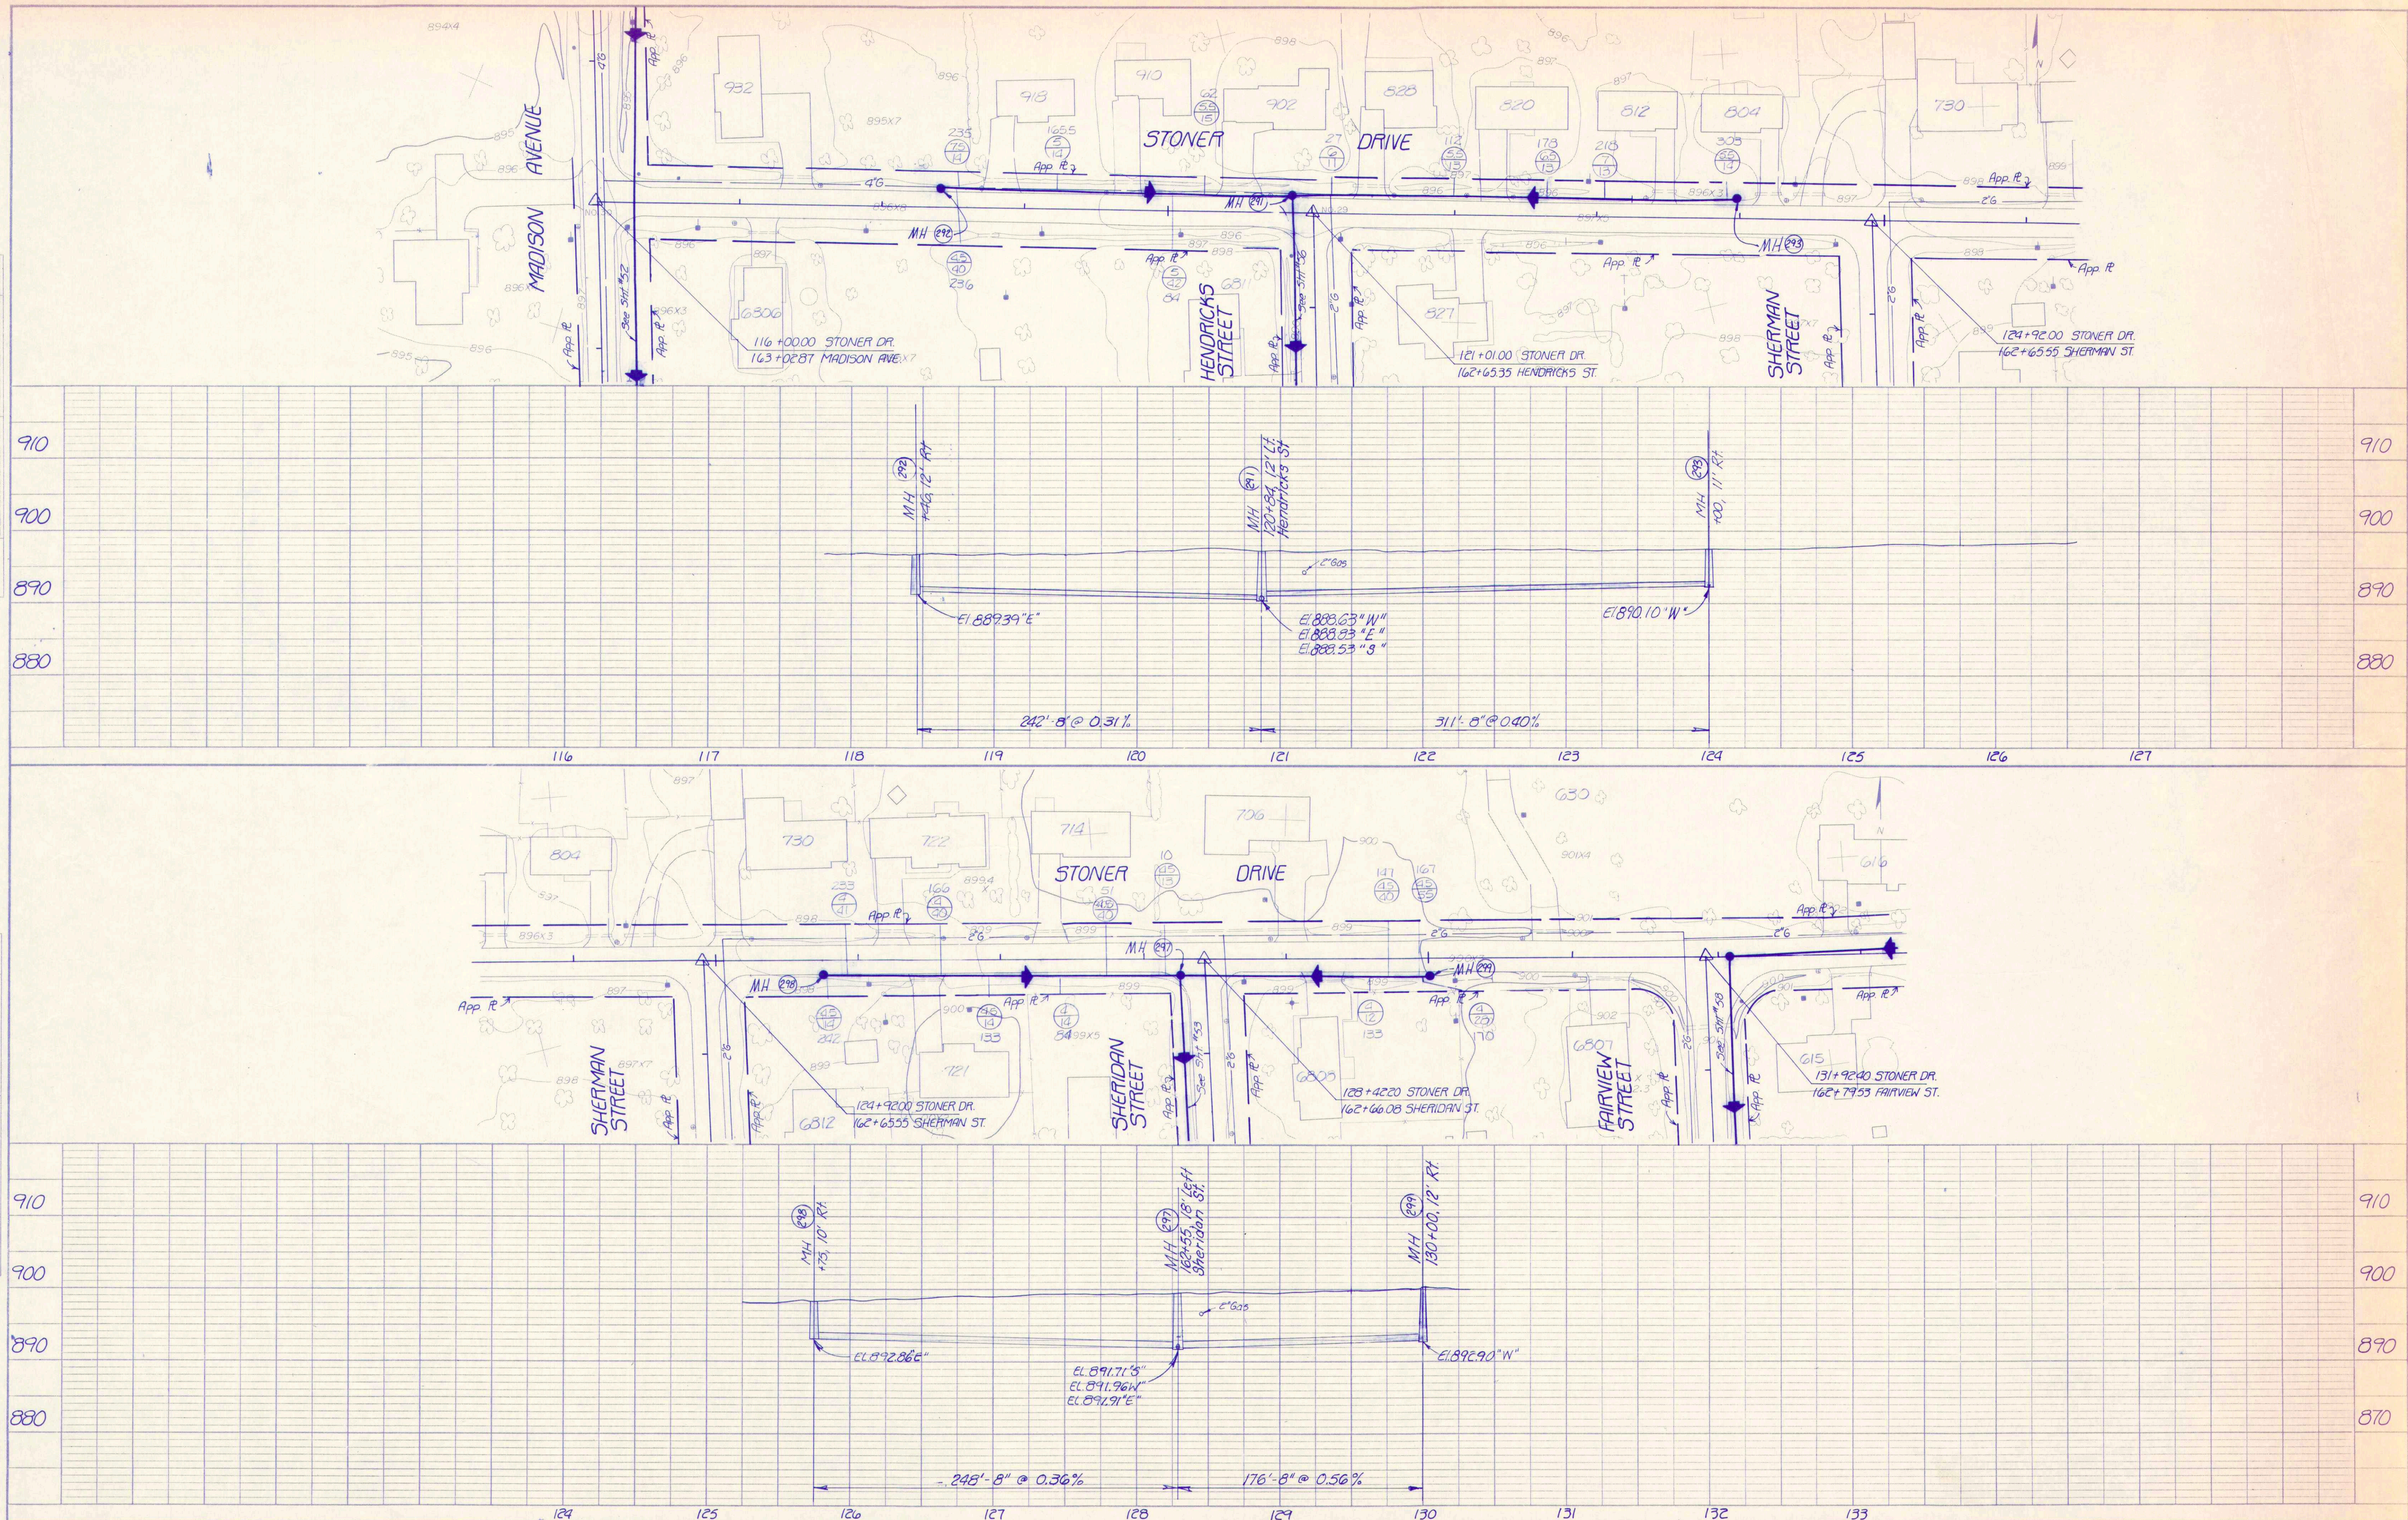

STONER DRIVE
FALL CREEK R.W.D. PLAN & PROFILE SHEET
HORIZ. 1"=50'
VERT. 1"=10'

BEAM, LONGEST & NEFF, INC.
CONSULTING ENGINEERS
INDIANAPOLIS, INDIANA

57