


PLAN	DATE	
	BY	
	CHECKED	
	NOTED	

PROFILE	DATE	
	BY	
	CHECKED	
	NOTED	

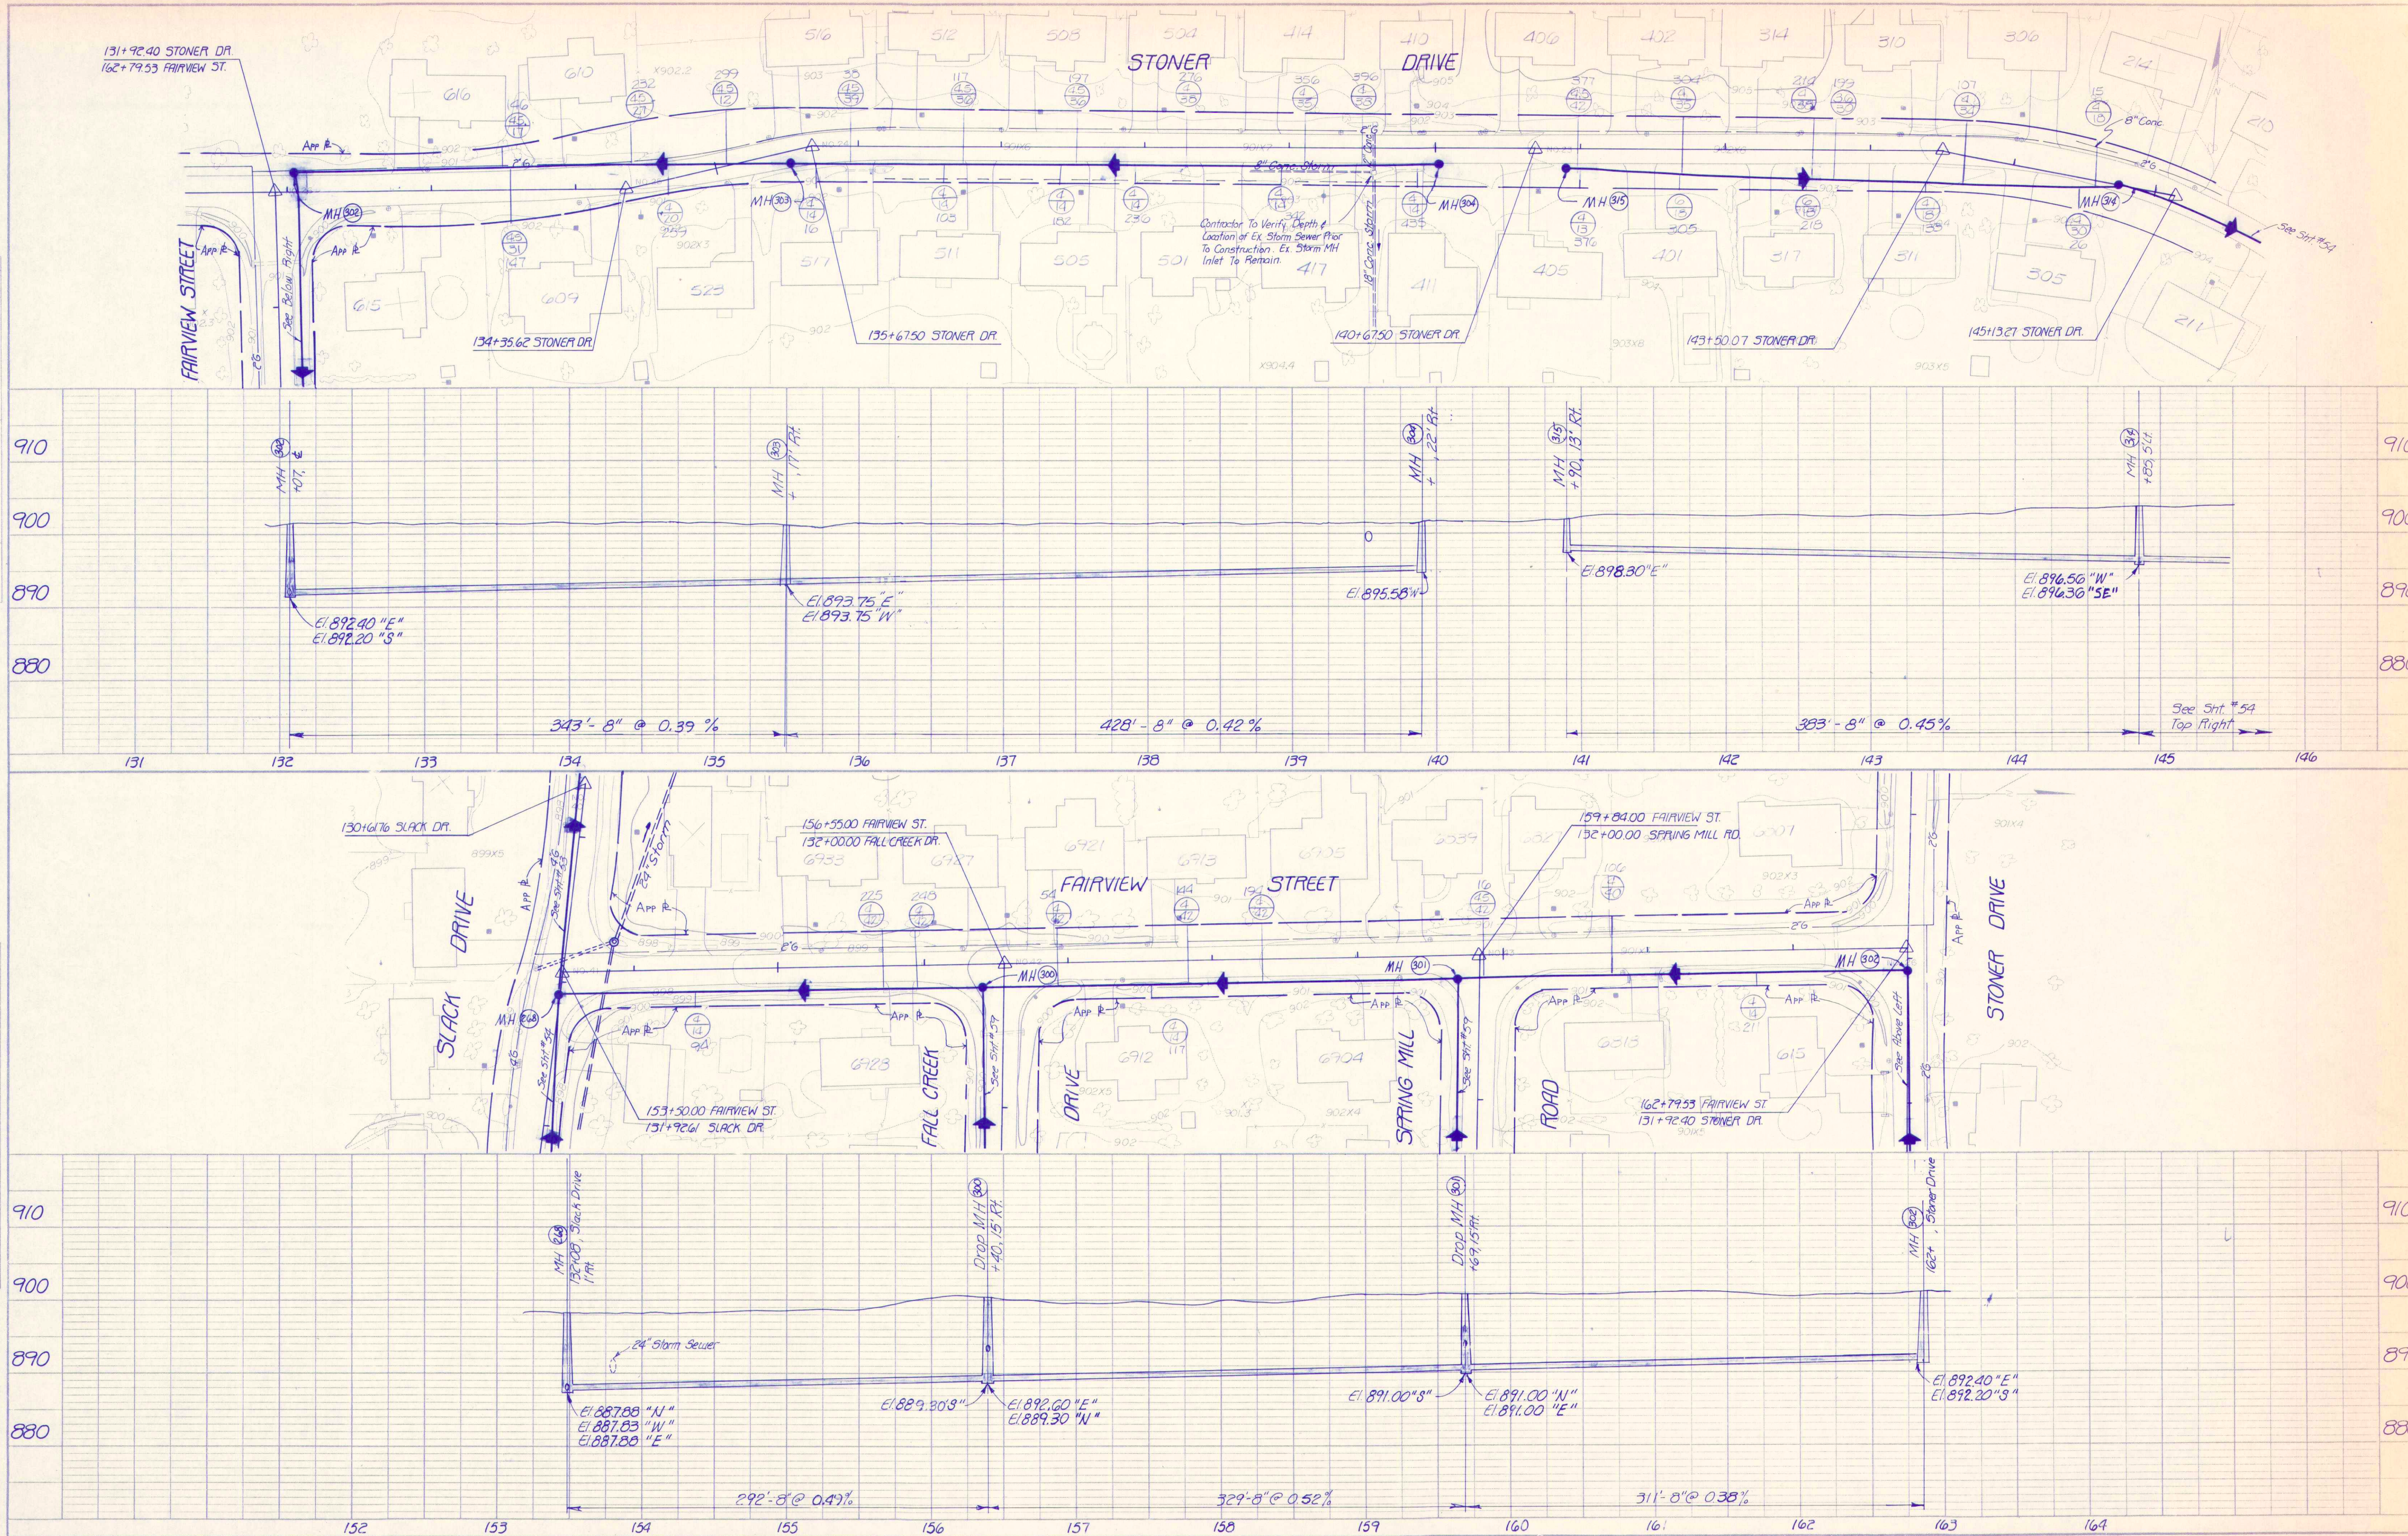

RECORD DRAWING

STONER DR./ FAIRVIEW ST.
 FALL CREEK R.W.D. PLAN & PROFILE
 HORIZ. 1"=50'
 VERT. 1"=10'
 BEAM, LONGST & NEFF, INC.
 CONSULTING ENGINEERS
 INDIANAPOLIS, INDIANA