


PLAN	DATE	
	BY	
	CHECKED	
	NO. OF SHEETS	

PROFILE	DATE	
	BY	
	CHECKED	
	NO. OF SHEETS	

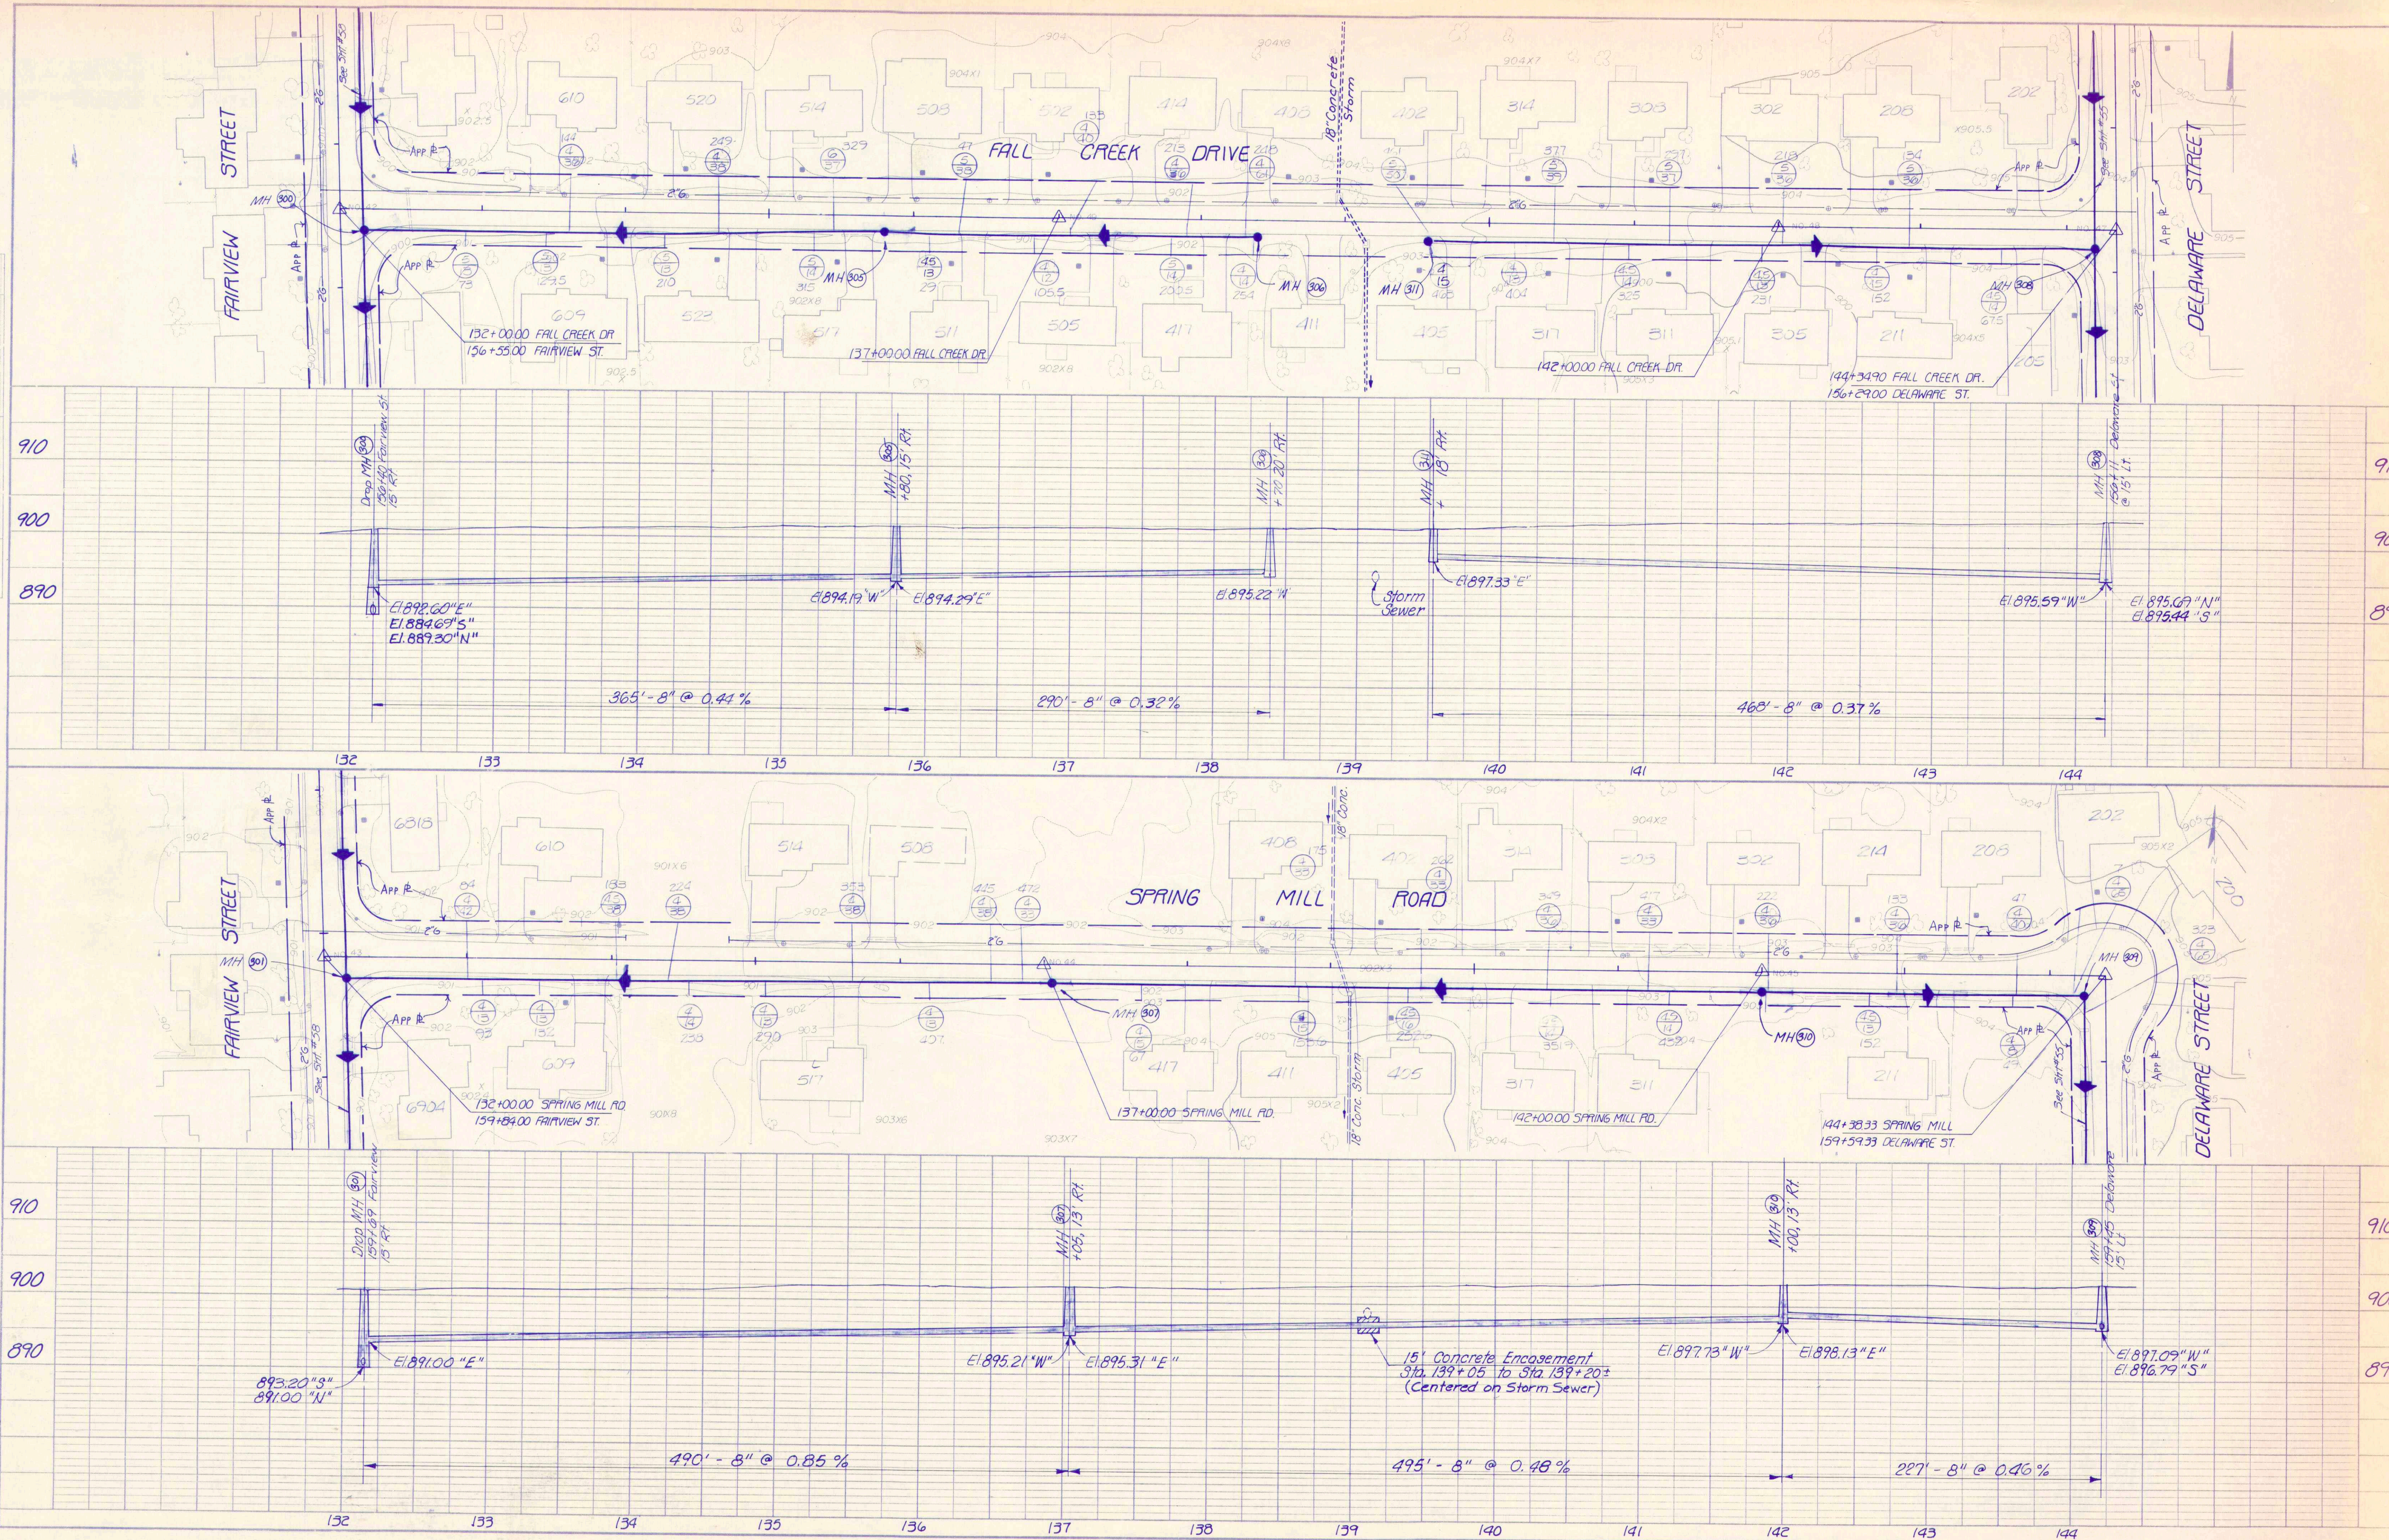

RECORD DRAWING