


PLAN	SUPPLEMENT	DATE
	NO.	BY
	NOTE BOOK	ALIGNED CHECKED
	NO.	RT. OF WAY CHECKED

PROFILE	SUPPLEMENT	DATE
	NO.	BY
	NOTE BOOK	GRADES CHECKED
	NO.	STRUCTURE NOTATIONS CHECKED

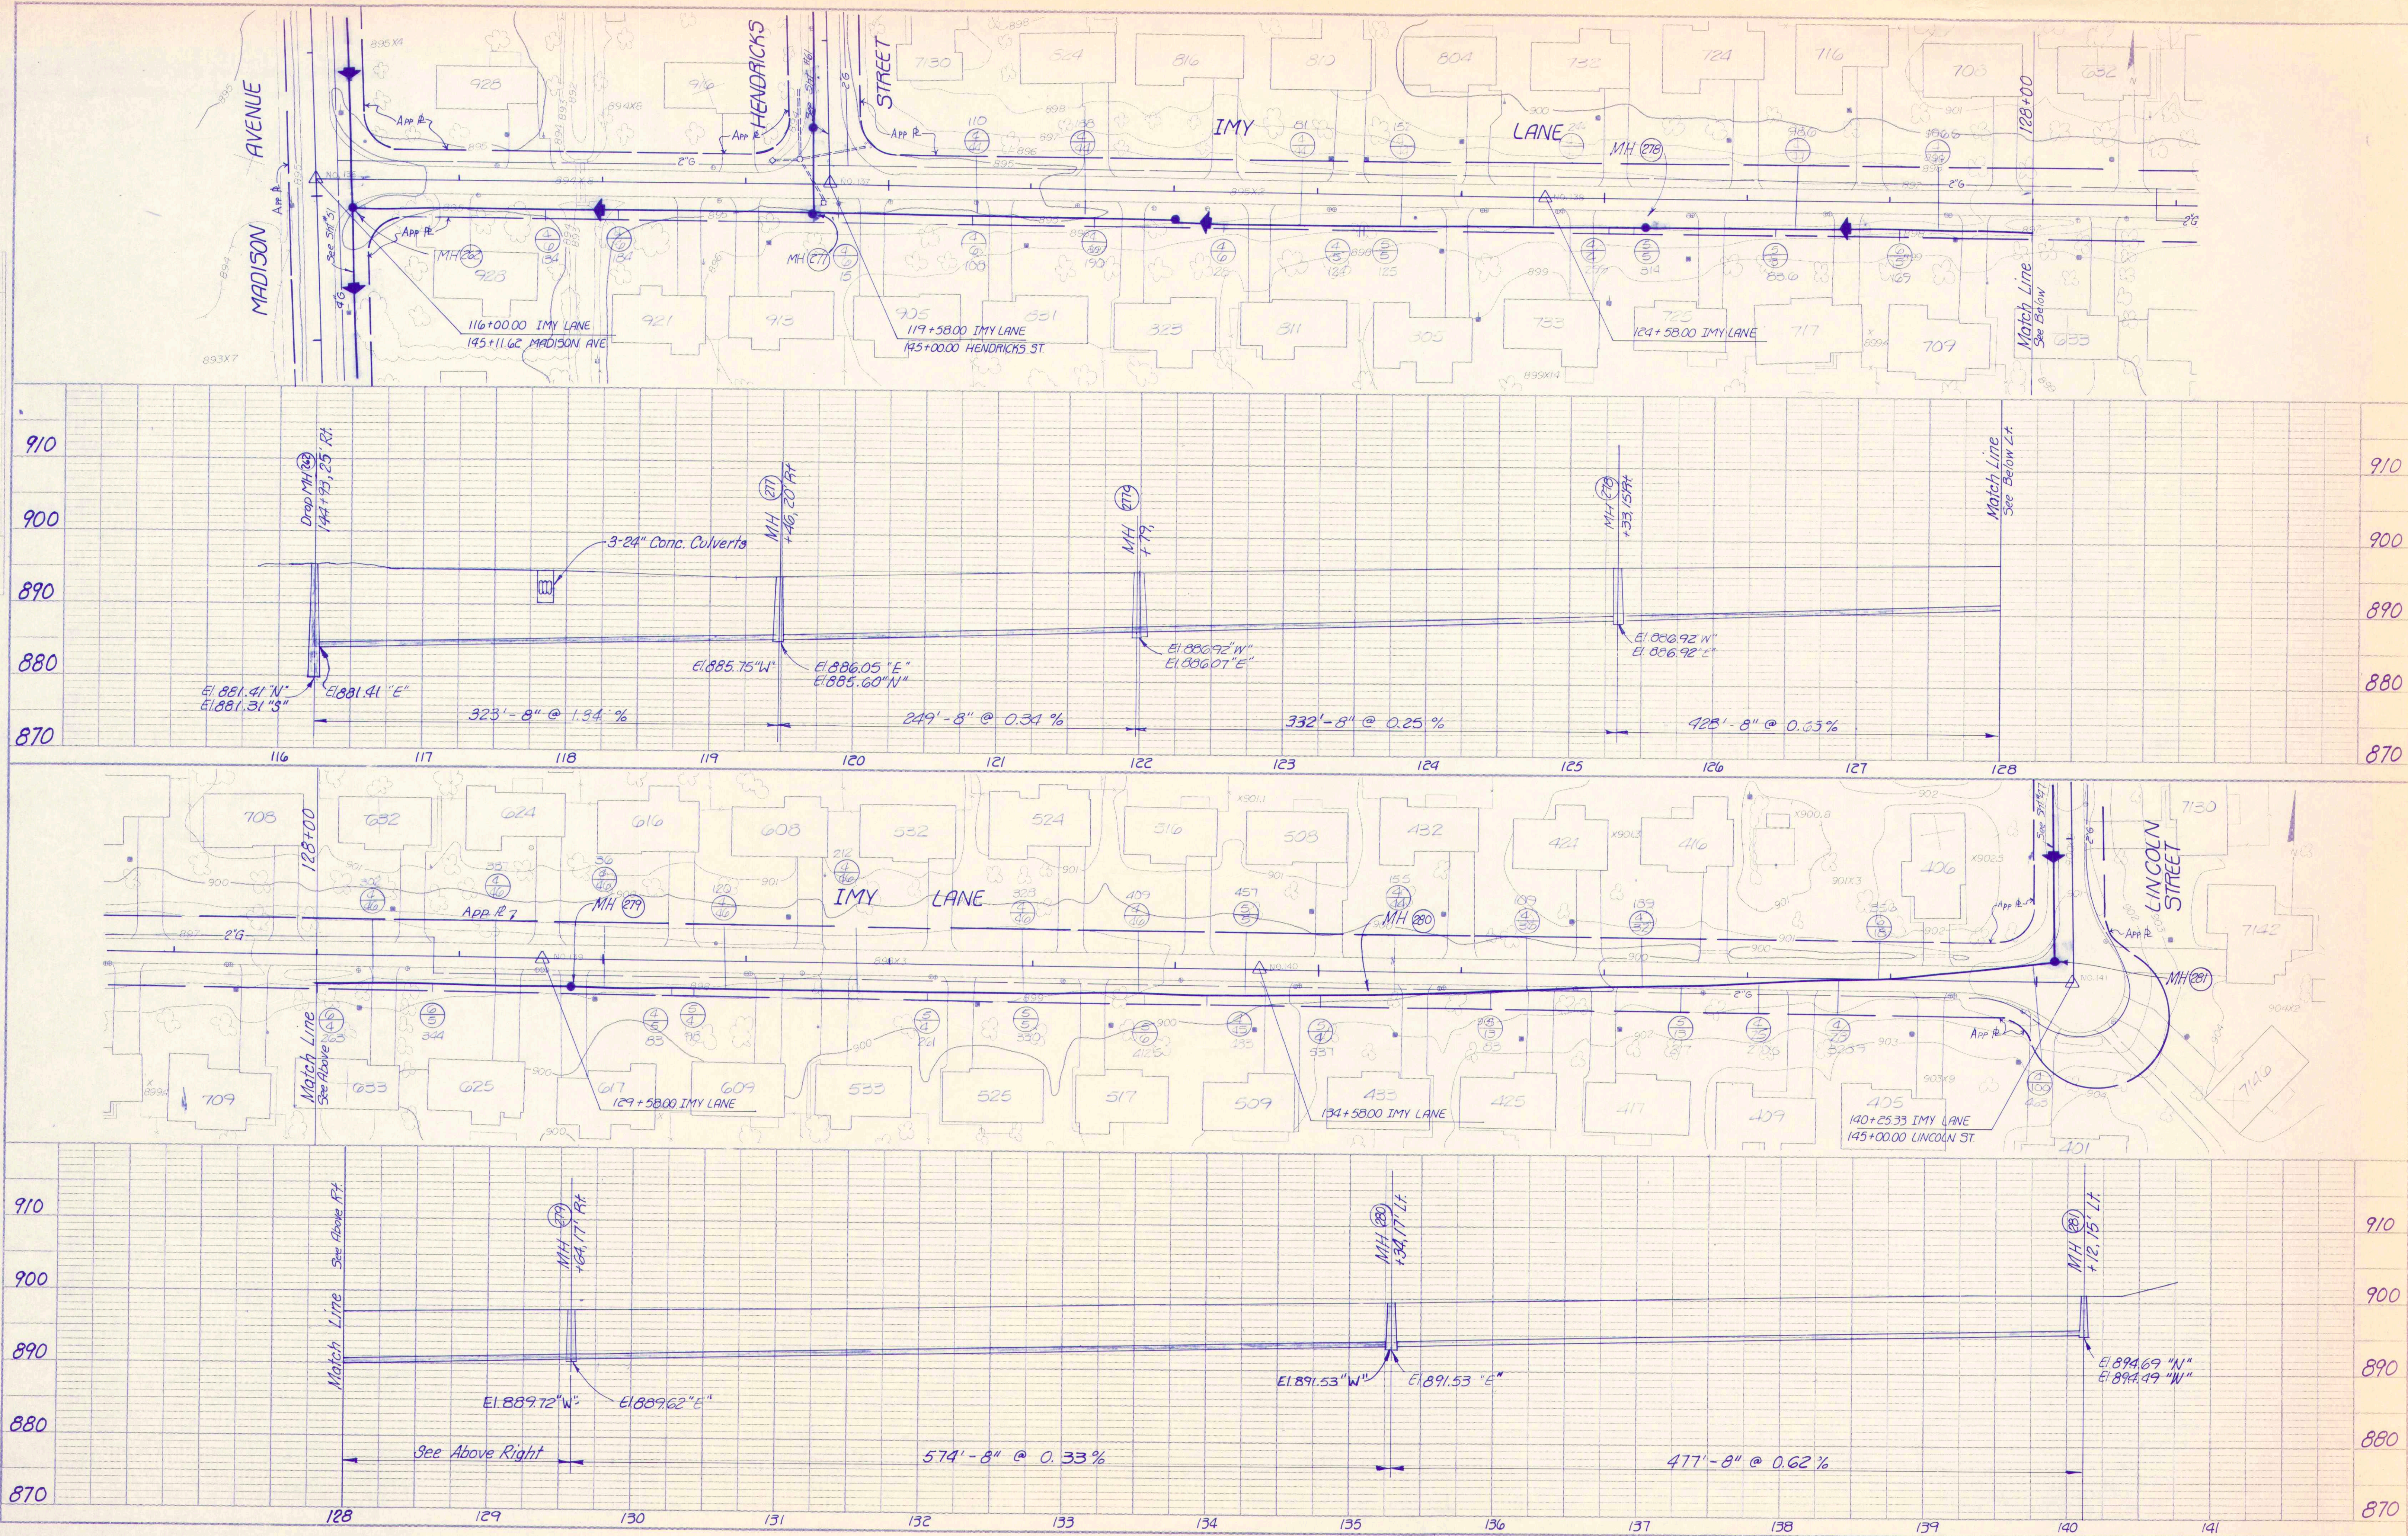

RECORD DRAWING