


PLAN
NOTES:
1. ALL DIMENSIONS ARE IN FEET AND INCHES.
2. ALL ELEVATIONS ARE IN FEET ABOVE SEA LEVEL.
3. ALL DISTANCES ARE IN FEET.
4. ALL ANGLES ARE IN DEGREES.
5. ALL CURVES ARE CIRCULAR.
6. ALL SLOPES ARE IN PERCENTS.
7. ALL GRADES ARE TO BE MAINTAINED.
8. ALL EROSION CONTROL MEASURES ARE TO BE INSTALLED.
9. ALL UTILITIES ARE TO BE PROTECTED.
10. ALL STRUCTURES ARE TO BE CONSTRUCTED TO MEET ALL APPLICABLE CODES AND STANDARDS.

PROFILE
NOTES:
1. ALL DIMENSIONS ARE IN FEET AND INCHES.
2. ALL ELEVATIONS ARE IN FEET ABOVE SEA LEVEL.
3. ALL DISTANCES ARE IN FEET.
4. ALL ANGLES ARE IN DEGREES.
5. ALL CURVES ARE CIRCULAR.
6. ALL SLOPES ARE IN PERCENTS.
7. ALL GRADES ARE TO BE MAINTAINED.
8. ALL EROSION CONTROL MEASURES ARE TO BE INSTALLED.
9. ALL UTILITIES ARE TO BE PROTECTED.
10. ALL STRUCTURES ARE TO BE CONSTRUCTED TO MEET ALL APPLICABLE CODES AND STANDARDS.



RECORD DRAWING

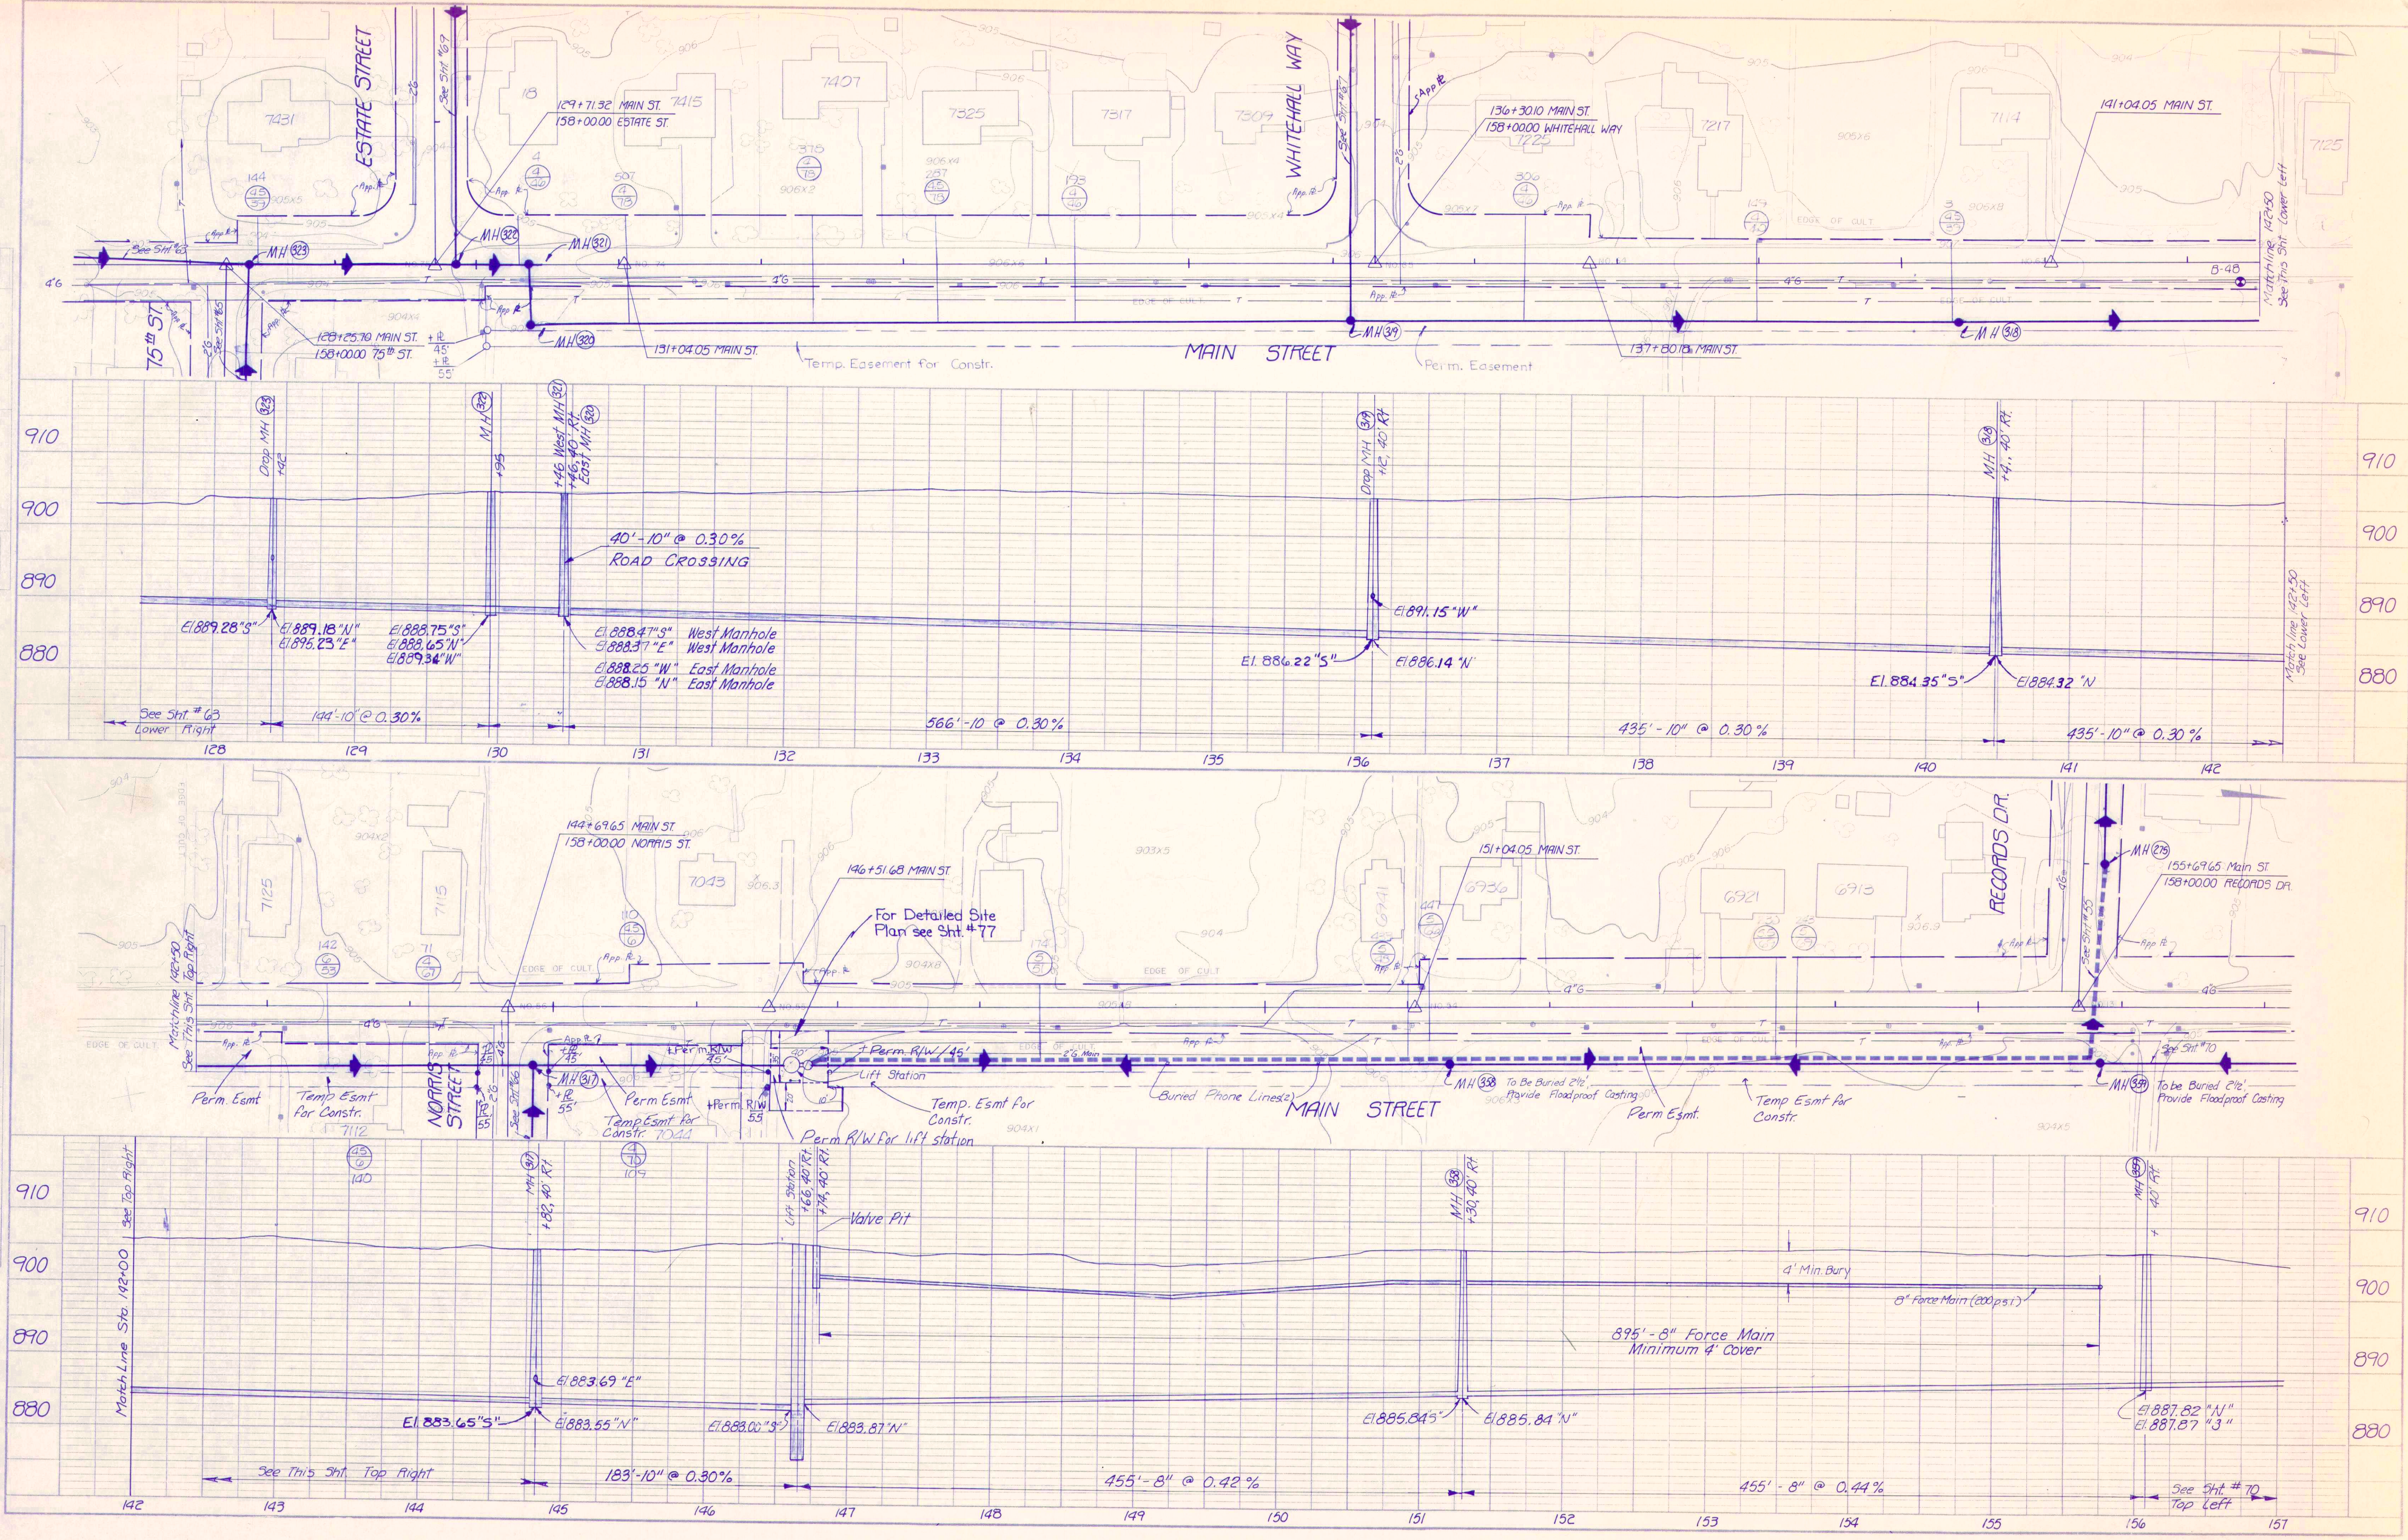

MAIN STREET
FALL CREEK R.W.D. PLAN & PROFILE SHEET
HORIZ. 1"=50'
VERT. 1"=10'
BEAM, LONGEST & NEFF, INC.
CONSULTING ENGINEERS
INDIANAPOLIS, INDIANA
62