


PLAN
 SHEET NO. 1
 DATE: 10/1/10
 PROJECT: FALL CREEK R.W.D. PLAN 8 & PROFILE
 DRAWN BY: [Signature]
 CHECKED BY: [Signature]
 IN CHARGE: [Signature]

PROFILE
 SHEET NO. 2
 DATE: 10/1/10
 PROJECT: FALL CREEK R.W.D. PLAN 8 & PROFILE
 DRAWN BY: [Signature]
 CHECKED BY: [Signature]
 IN CHARGE: [Signature]



RECORD DRAWING

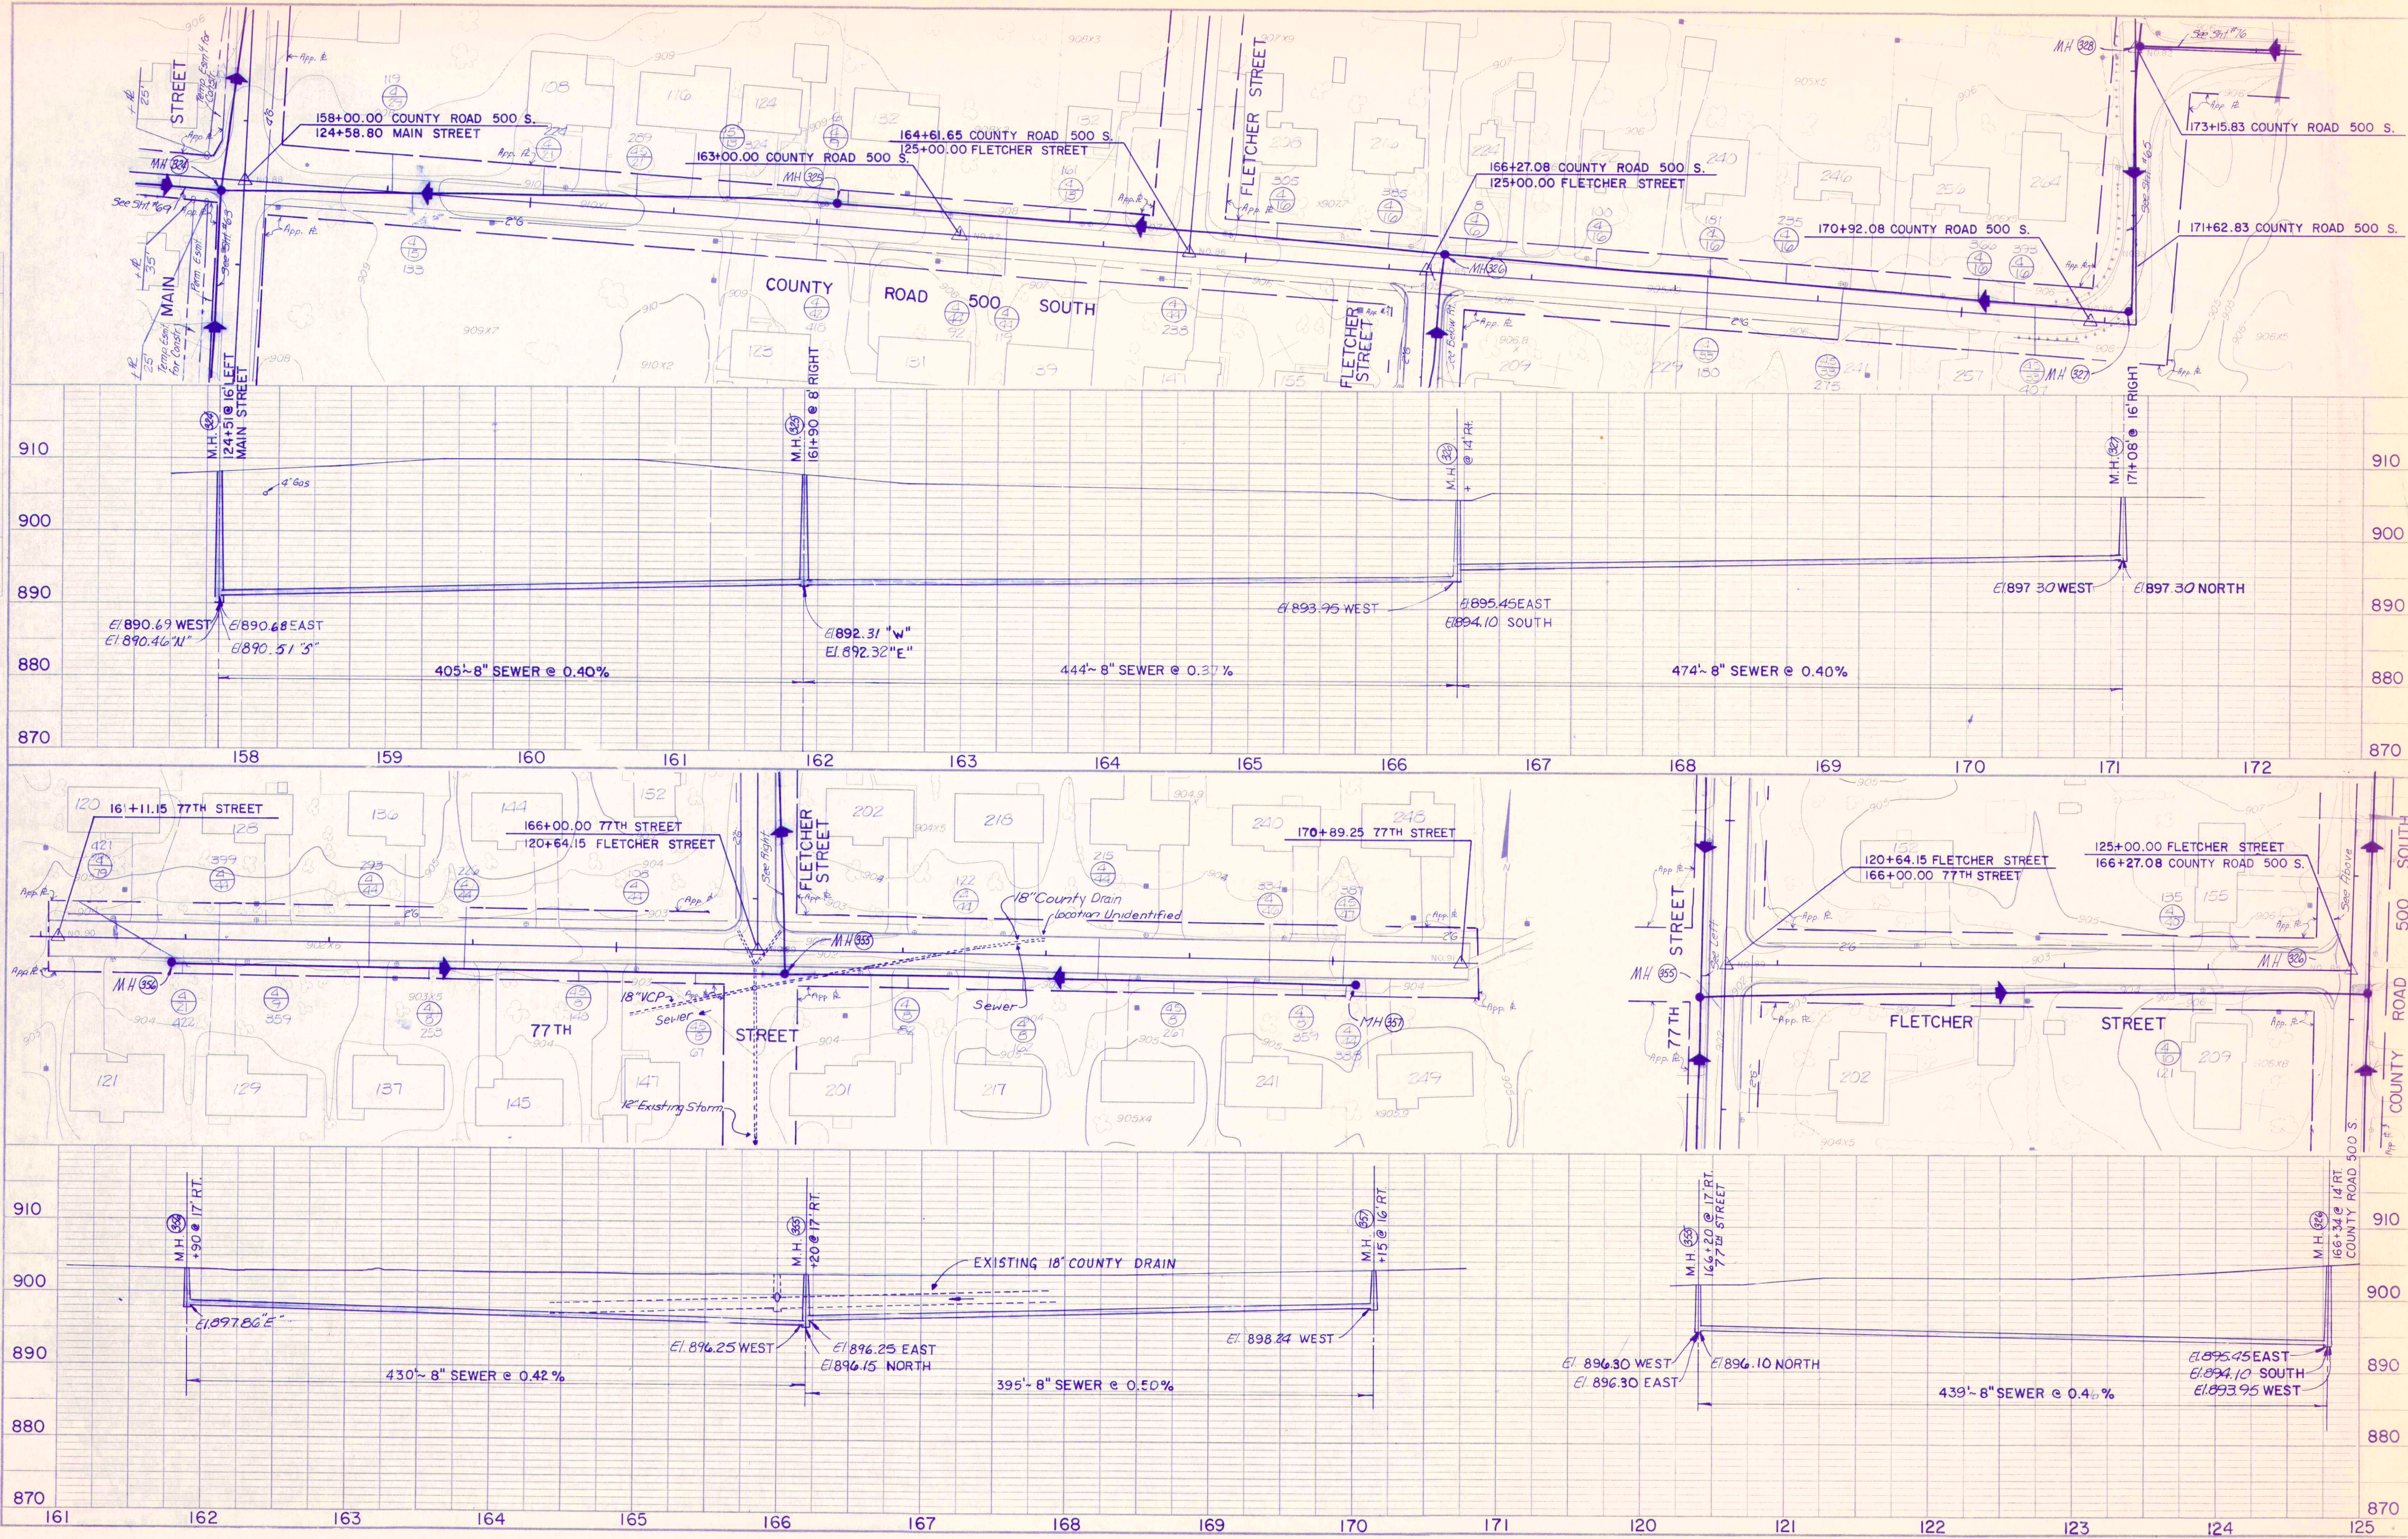

COUNTY ROAD 500 S. / FLETCHER ST.
 77TH ST.
 FALL CREEK R.W.D. PLAN 8 & PROFILE SHEET
 HORIZ. 1"=50'
 VERT. 1"=10'
 BEAM, LONGST & NEFF, INC.
 CONSULTING ENGINEERS
 INDIANAPOLIS, INDIANA
 64