


PLAN	DATE
PROJECTED	BY
ALIGNED	BY
NOTE BOOK	NO.

PROFILE	DATE
PROJECTED	BY
ALIGNED	BY
NOTE BOOK	NO.

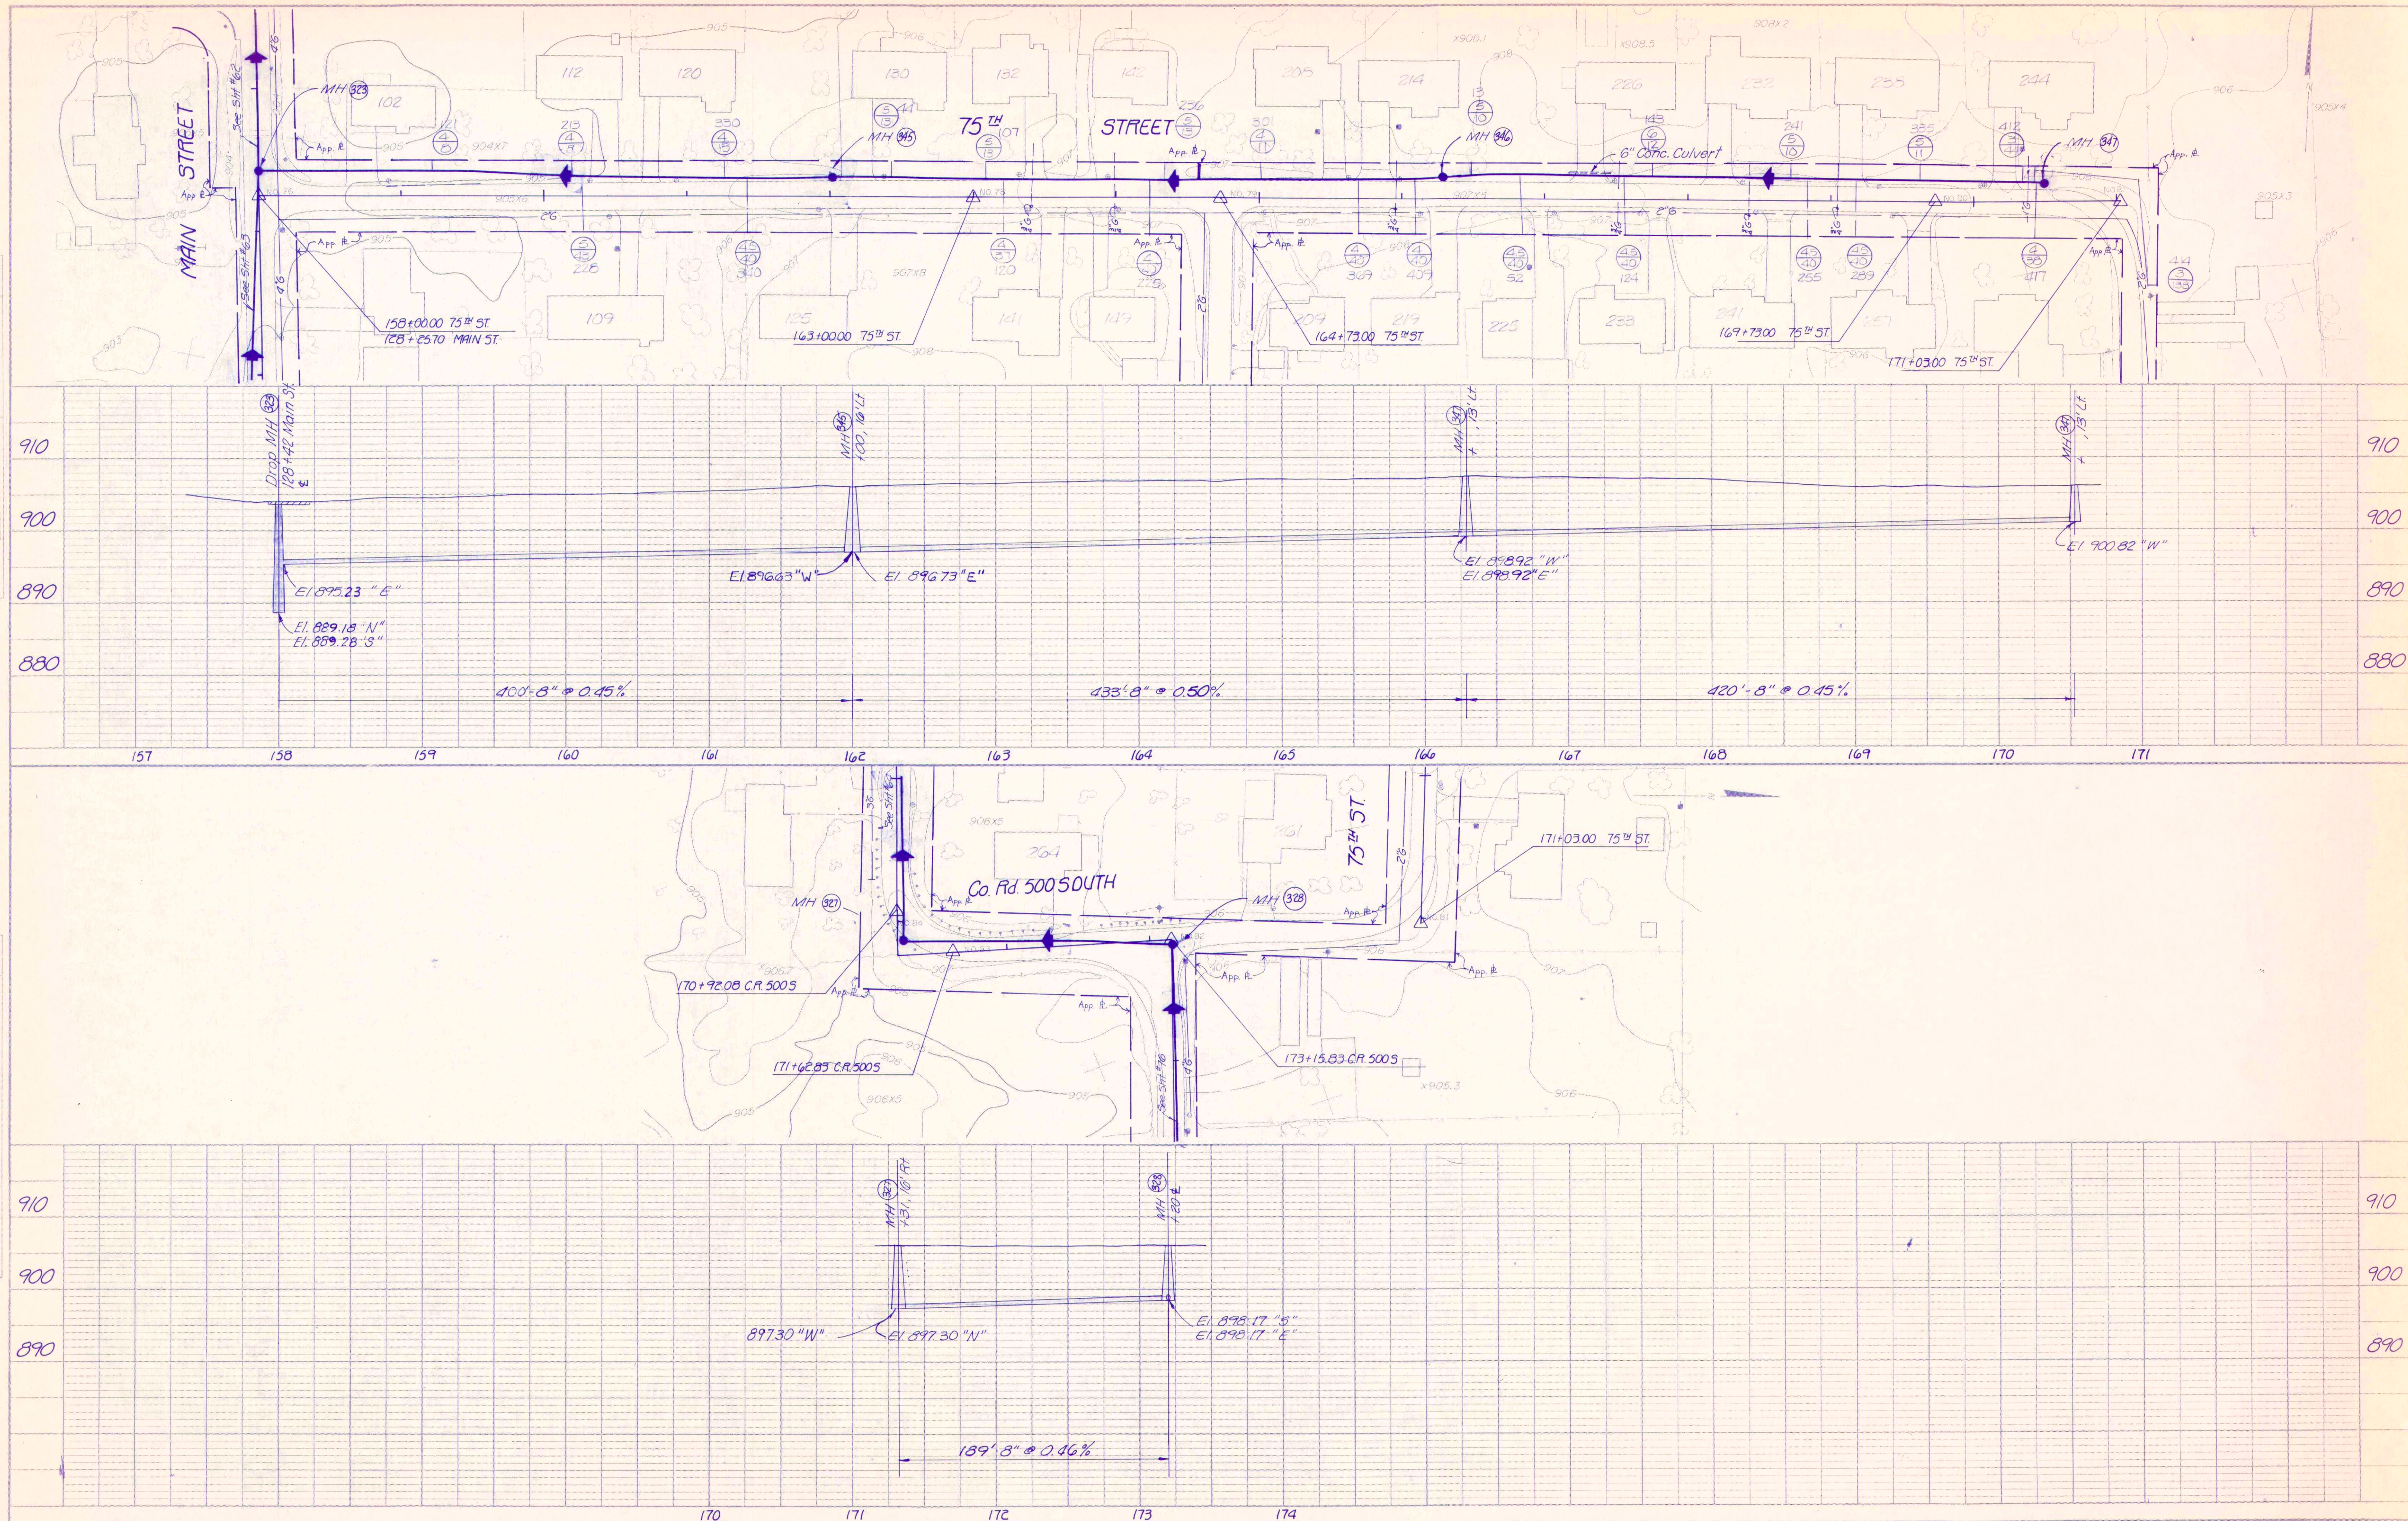

RECORD DRAWING

3-30-83

75 TH ST. / Co. Rd. 500 SOUTH		SHEET 65
FALL CREEK R.W.D. PLAN & PROFILE		
HORIZ. 1"=50'	BEAM, LONGEST & NEFF, INC. CONSULTING ENGINEERS INDIANAPOLIS, INDIANA	