


PLAN
 SHEET NO. 1
 DATE: 10/1/10
 BY: [Signature]
 CHECKED: [Signature]
 NO. 10

PROFILE
 SHEET NO. 2
 DATE: 10/1/10
 BY: [Signature]
 CHECKED: [Signature]
 NO. 10

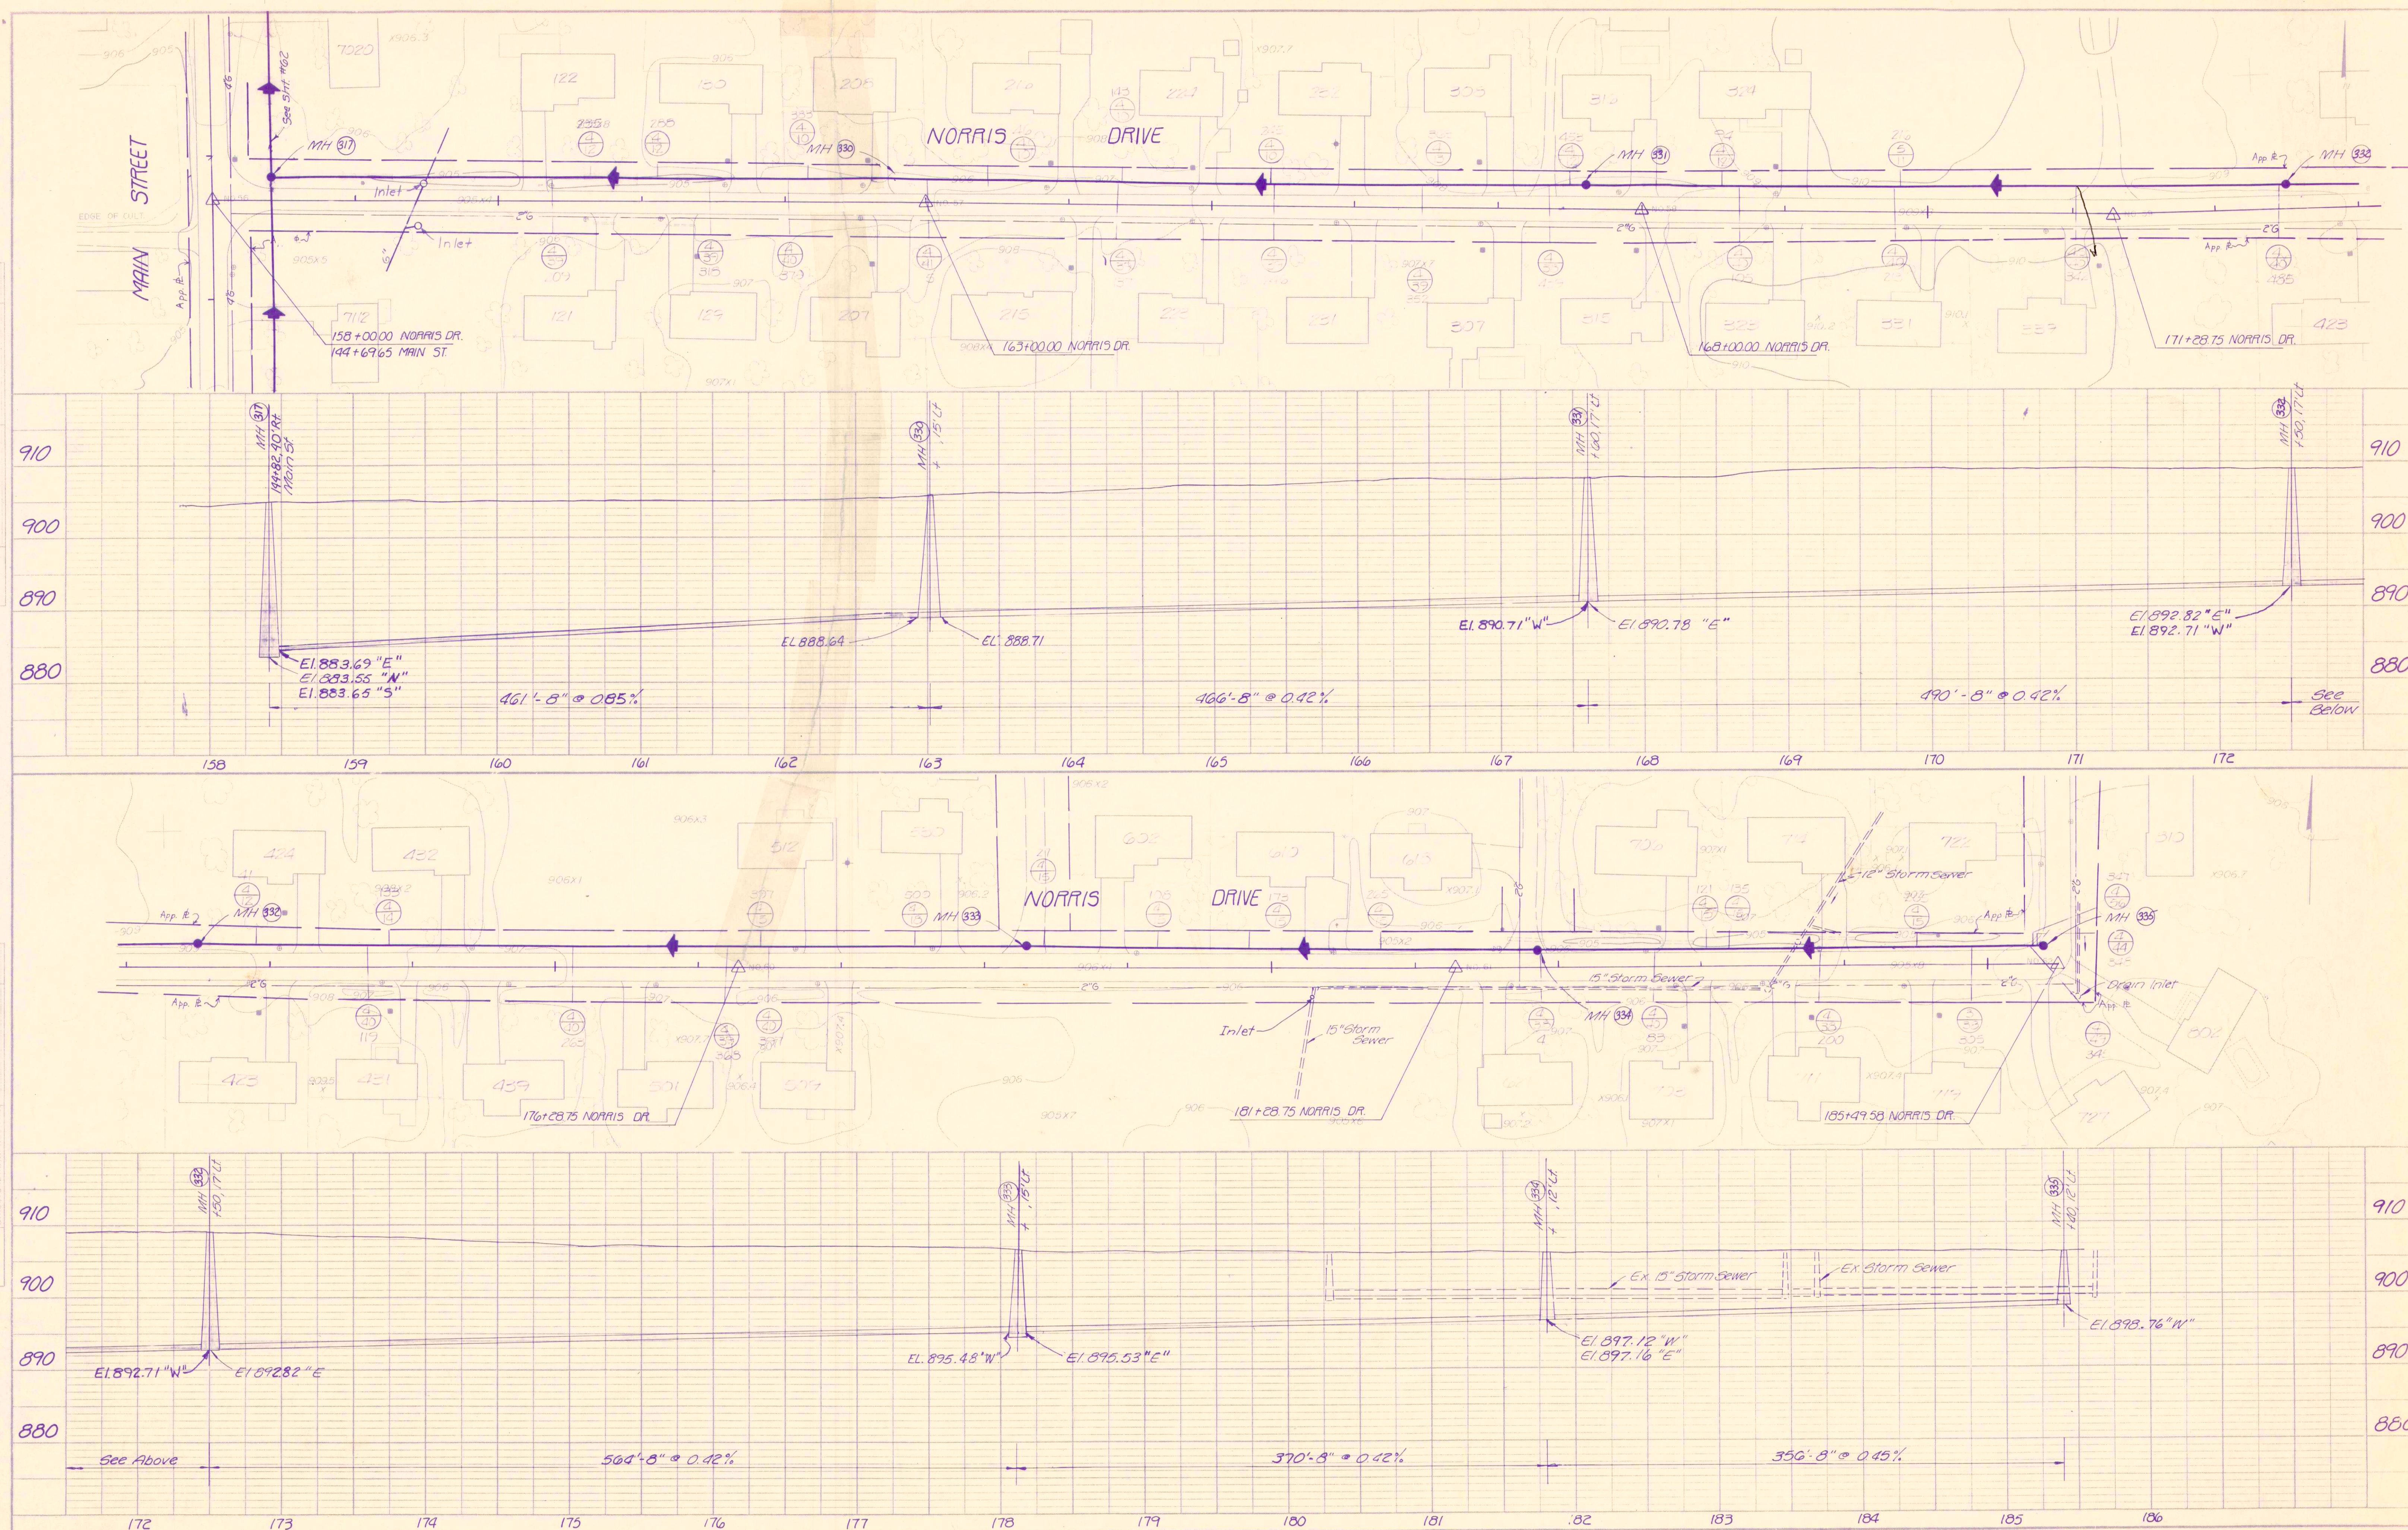

RECORD DRAWING