


PLAN	DATE	BY
	NO.	NO.
	NOTE BOOK	
	NO.	

PROFILE	DATE	BY
	NO.	NO.
	NOTE BOOK	
	NO.	

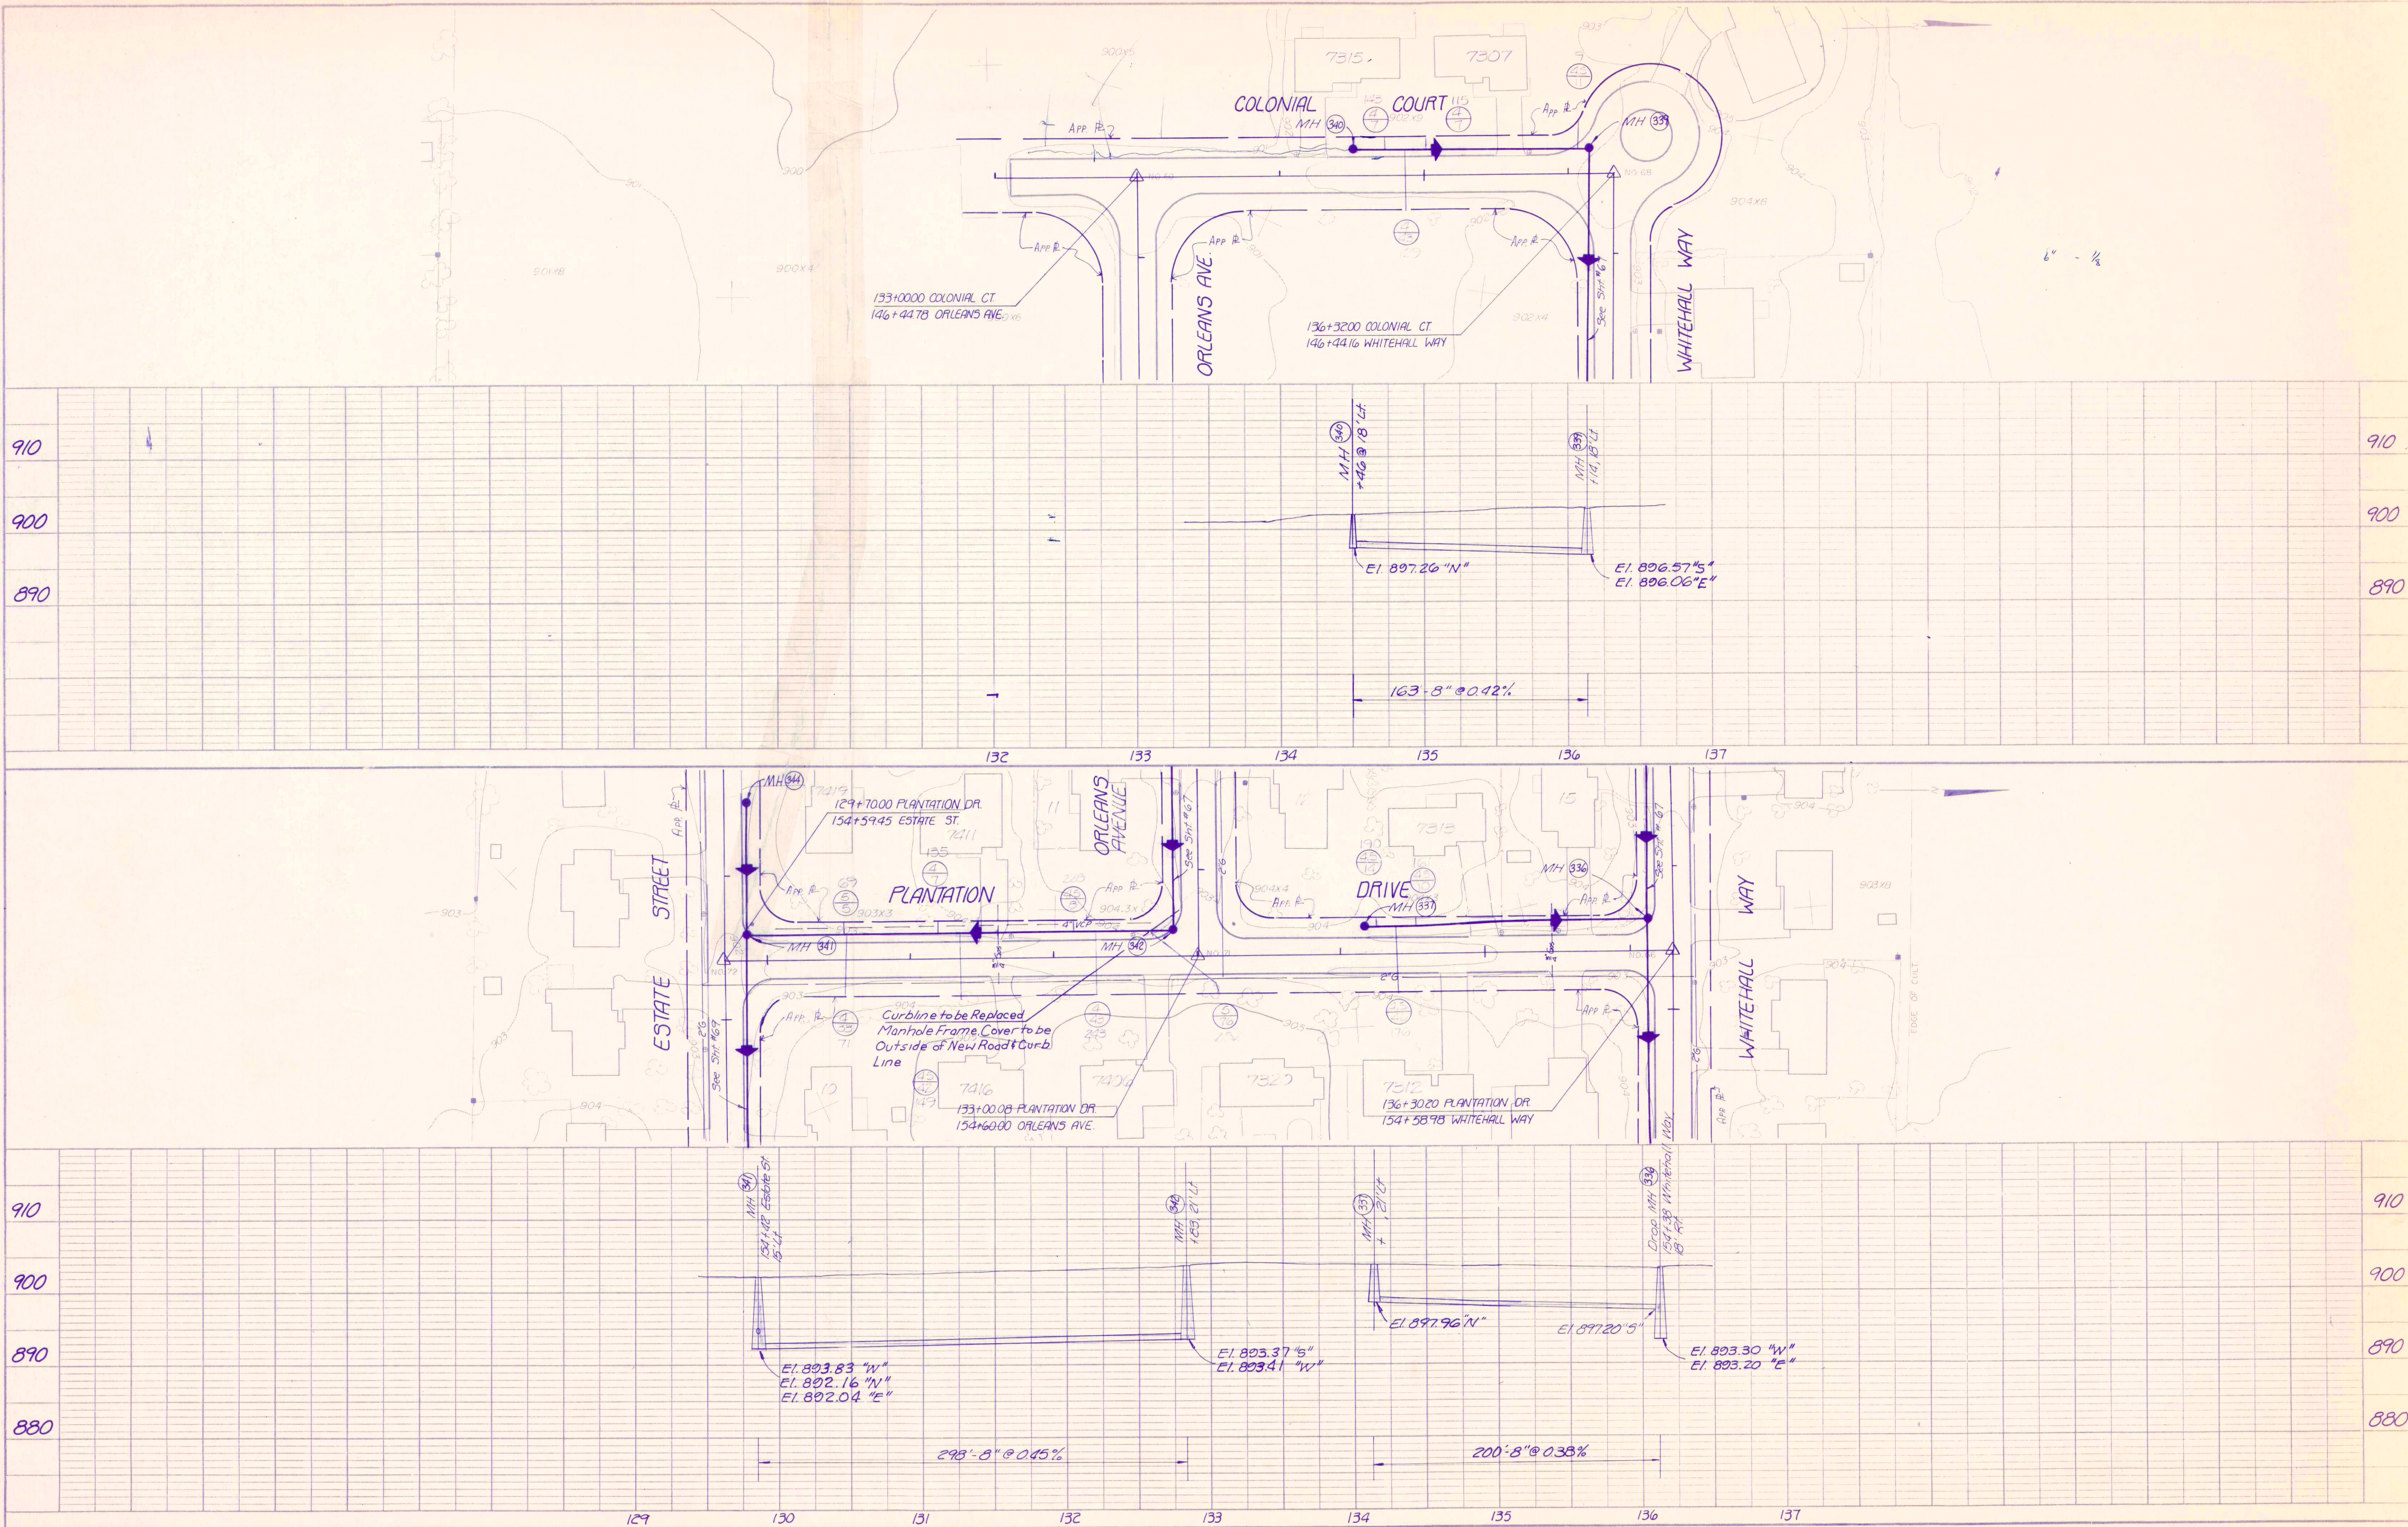

RECORD DRAWING

COLONIAL CT/ PLANTATION DR.	
FALL CREEK R.W.D. PLAN & PROFILE SHEET	
HORIZ. 1"=50'	BEAM, LONGEST & NEFF, INC. CONSULTING ENGINEERS INDIANAPOLIS, INDIANA
VERT. 1"=10'	68