


PLAN	DATE	BY	CHECKED	NO.
SURVEYED				
DESIGNED				
NOTED				
STRUCTURE NOTATION				

PROFILE	DATE	BY	CHECKED	NO.
SURVEYED				
DESIGNED				
NOTED				
STRUCTURE NOTATION				



RECORD DRAWING

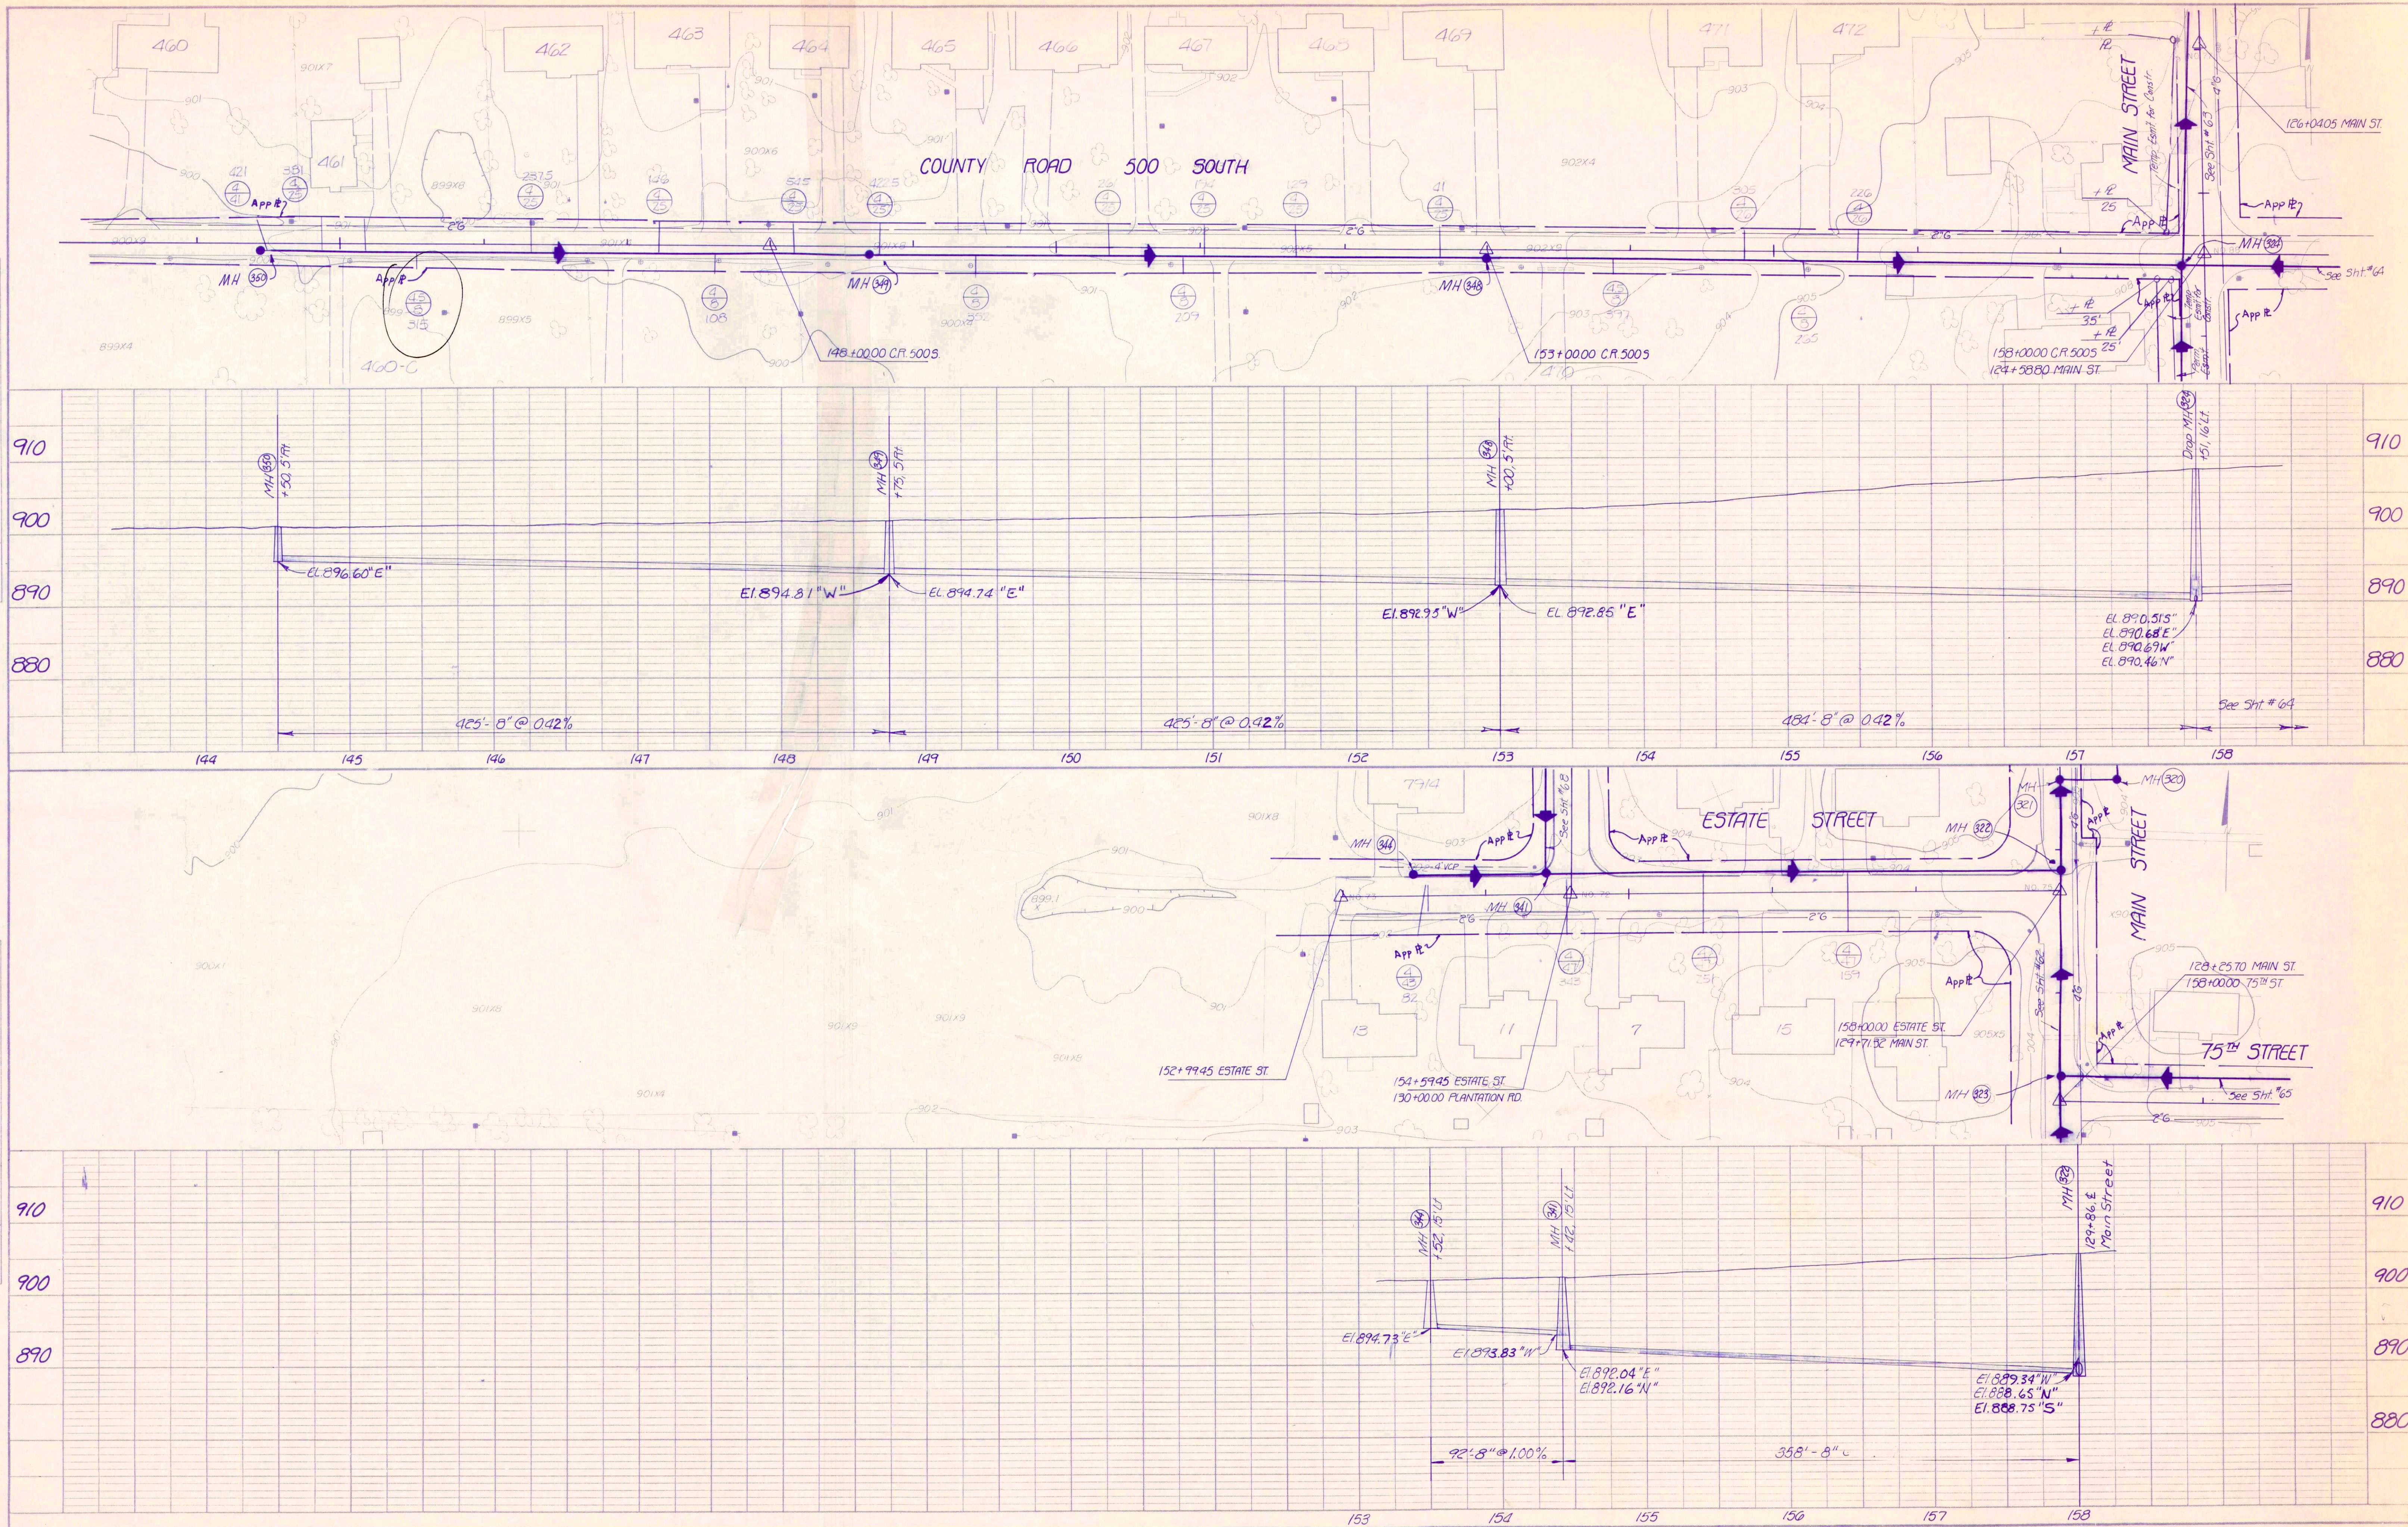