


PLAN	DATE	BY	SURVEYED
NOTE BOOK			
ALIGNED CHECKED			
RT. OF WAY CHECKED			
NO.			

PROFILE	DATE	BY	SURVEYED
NOTE BOOK			
GRADES CHECKED			
STRUCTURE NOTATIONS CHECKED			
NO.			

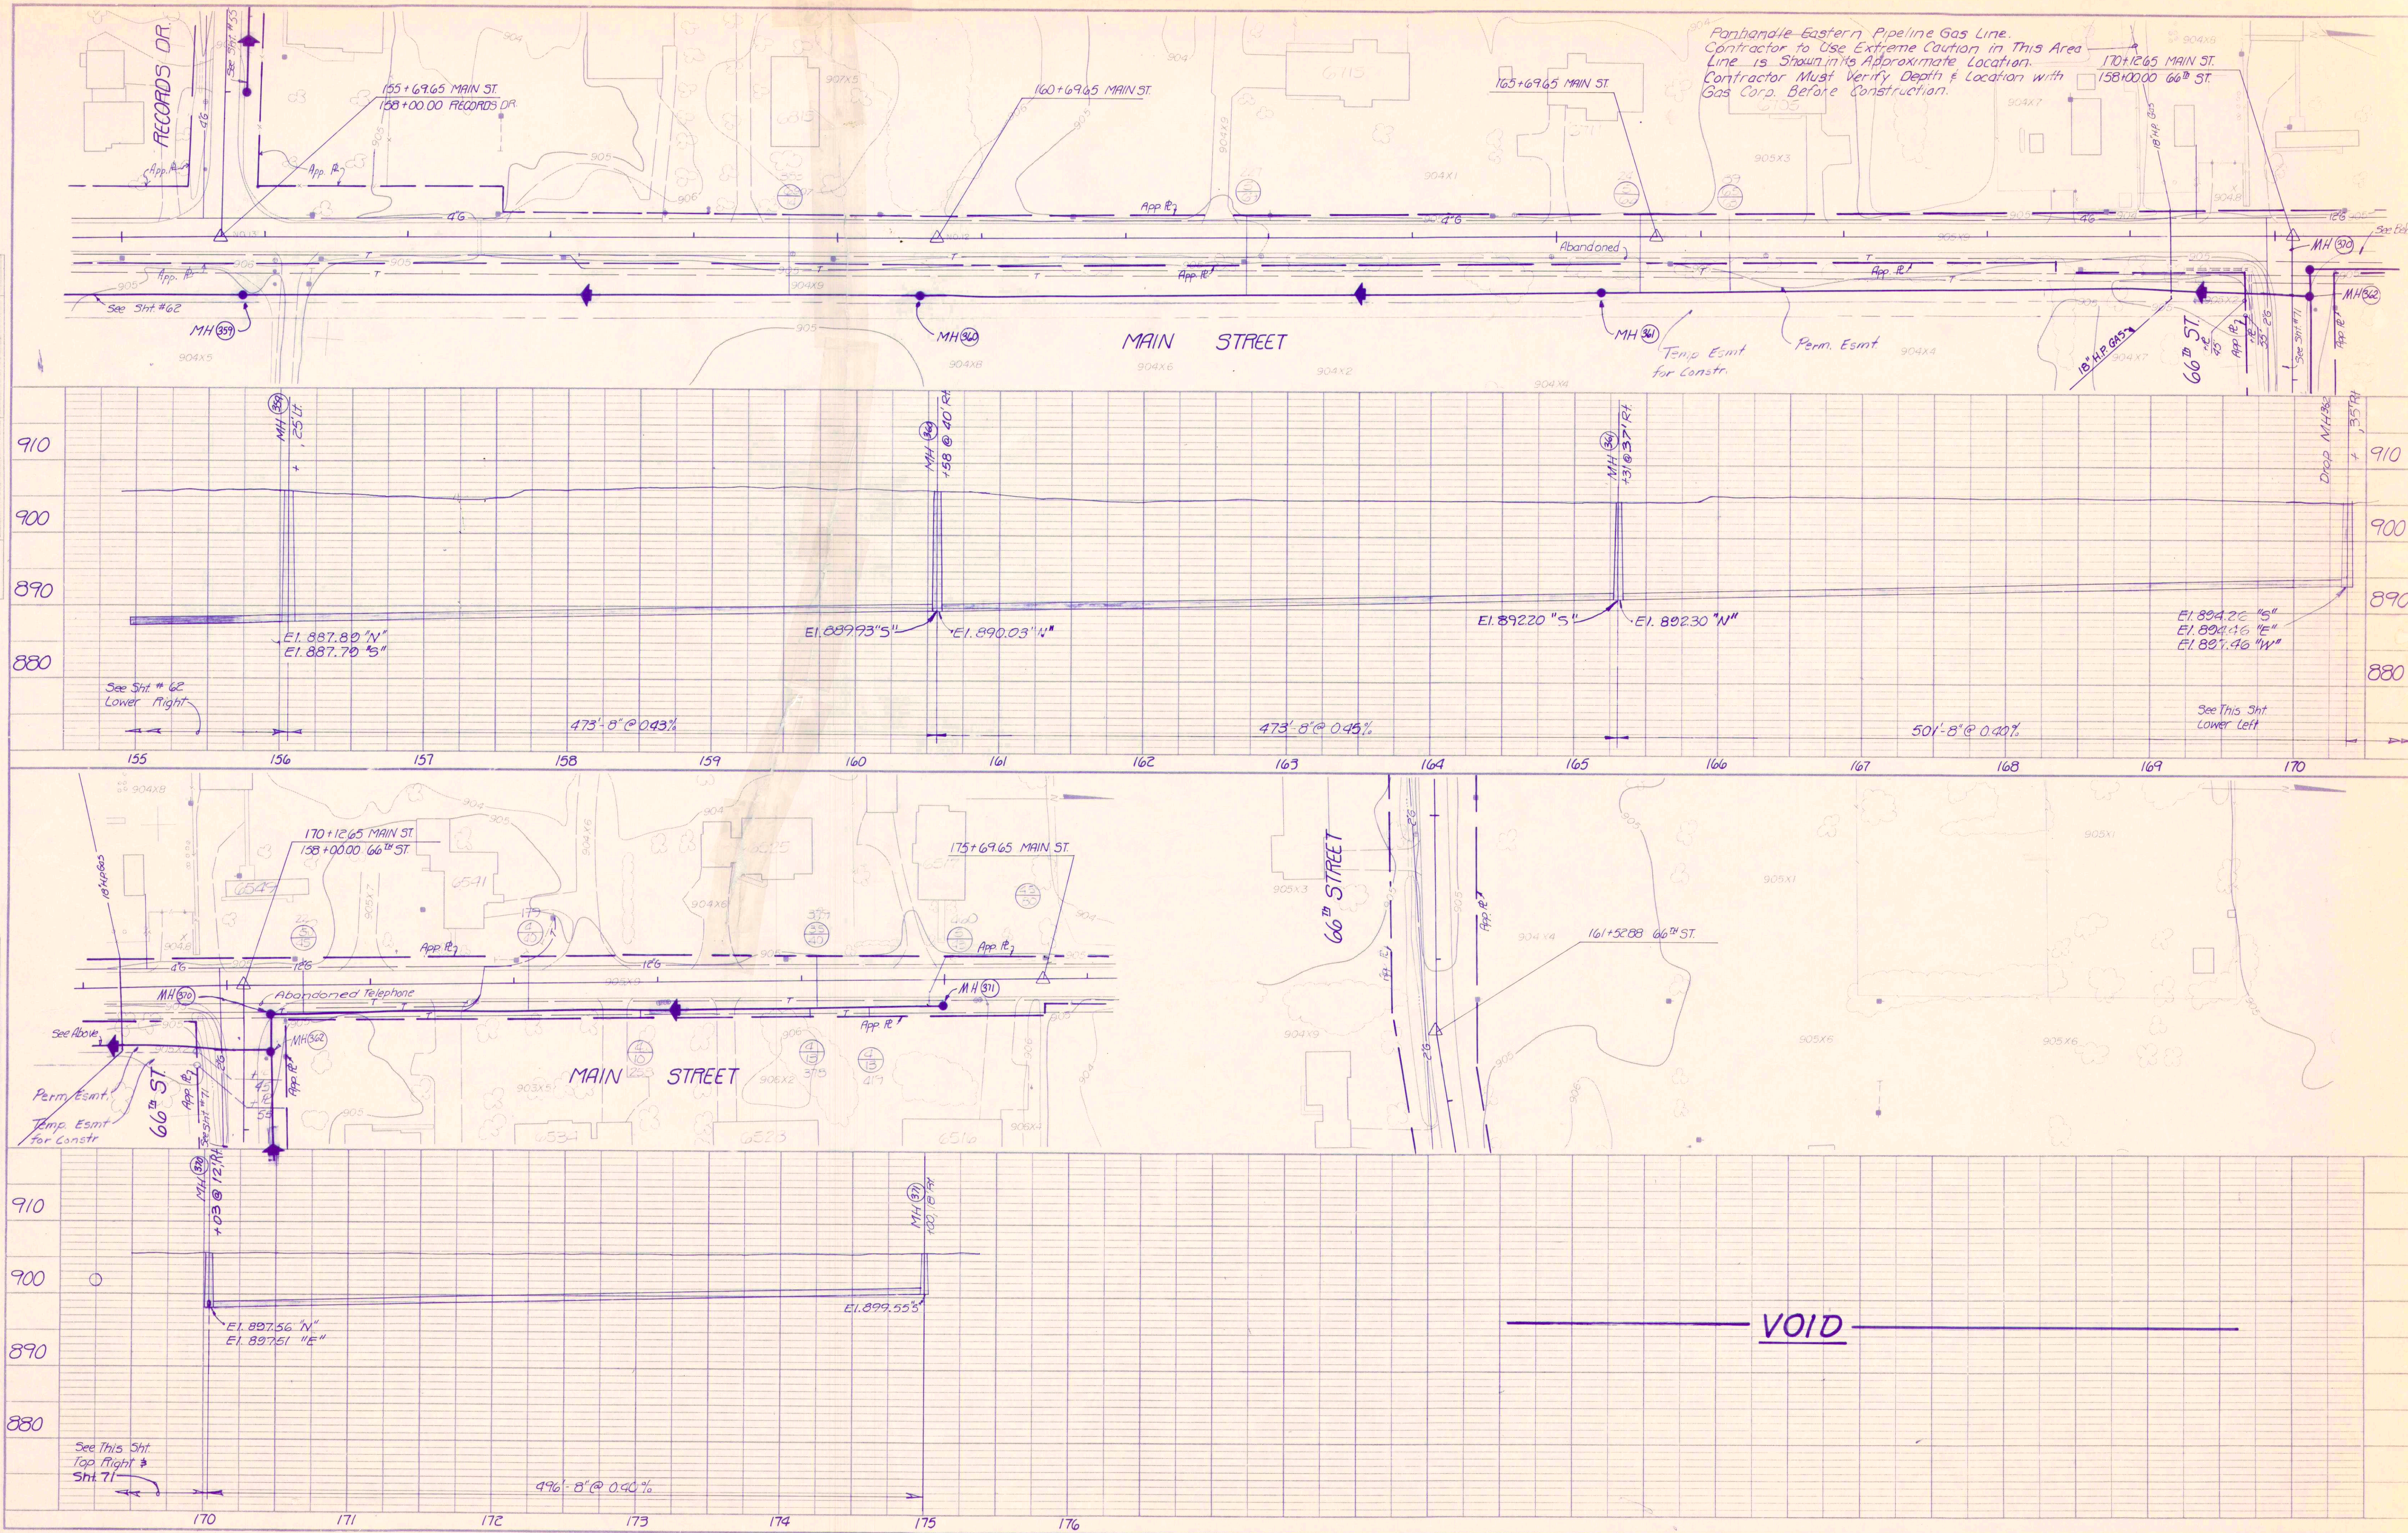

RECORD DRAWING

MAIN STREET	
FALL CREEK R.W.D. PLAN & PROFILE	SHEET
HORIZ. 1"=50'	BEAM, LONGEST & NEFF, INC.
VERT. 1"=10'	CONSULTING ENGINEERS
	INDIANAPOLIS, INDIANA