


PLAN	DATE
NO.	BY
NOTE BOOK	REVISIONS
NO.	BY
NOTE	DATE
NO.	BY



PROFILE	DATE
NO.	BY
NOTE BOOK	REVISIONS
NO.	BY
NOTE	DATE
NO.	BY

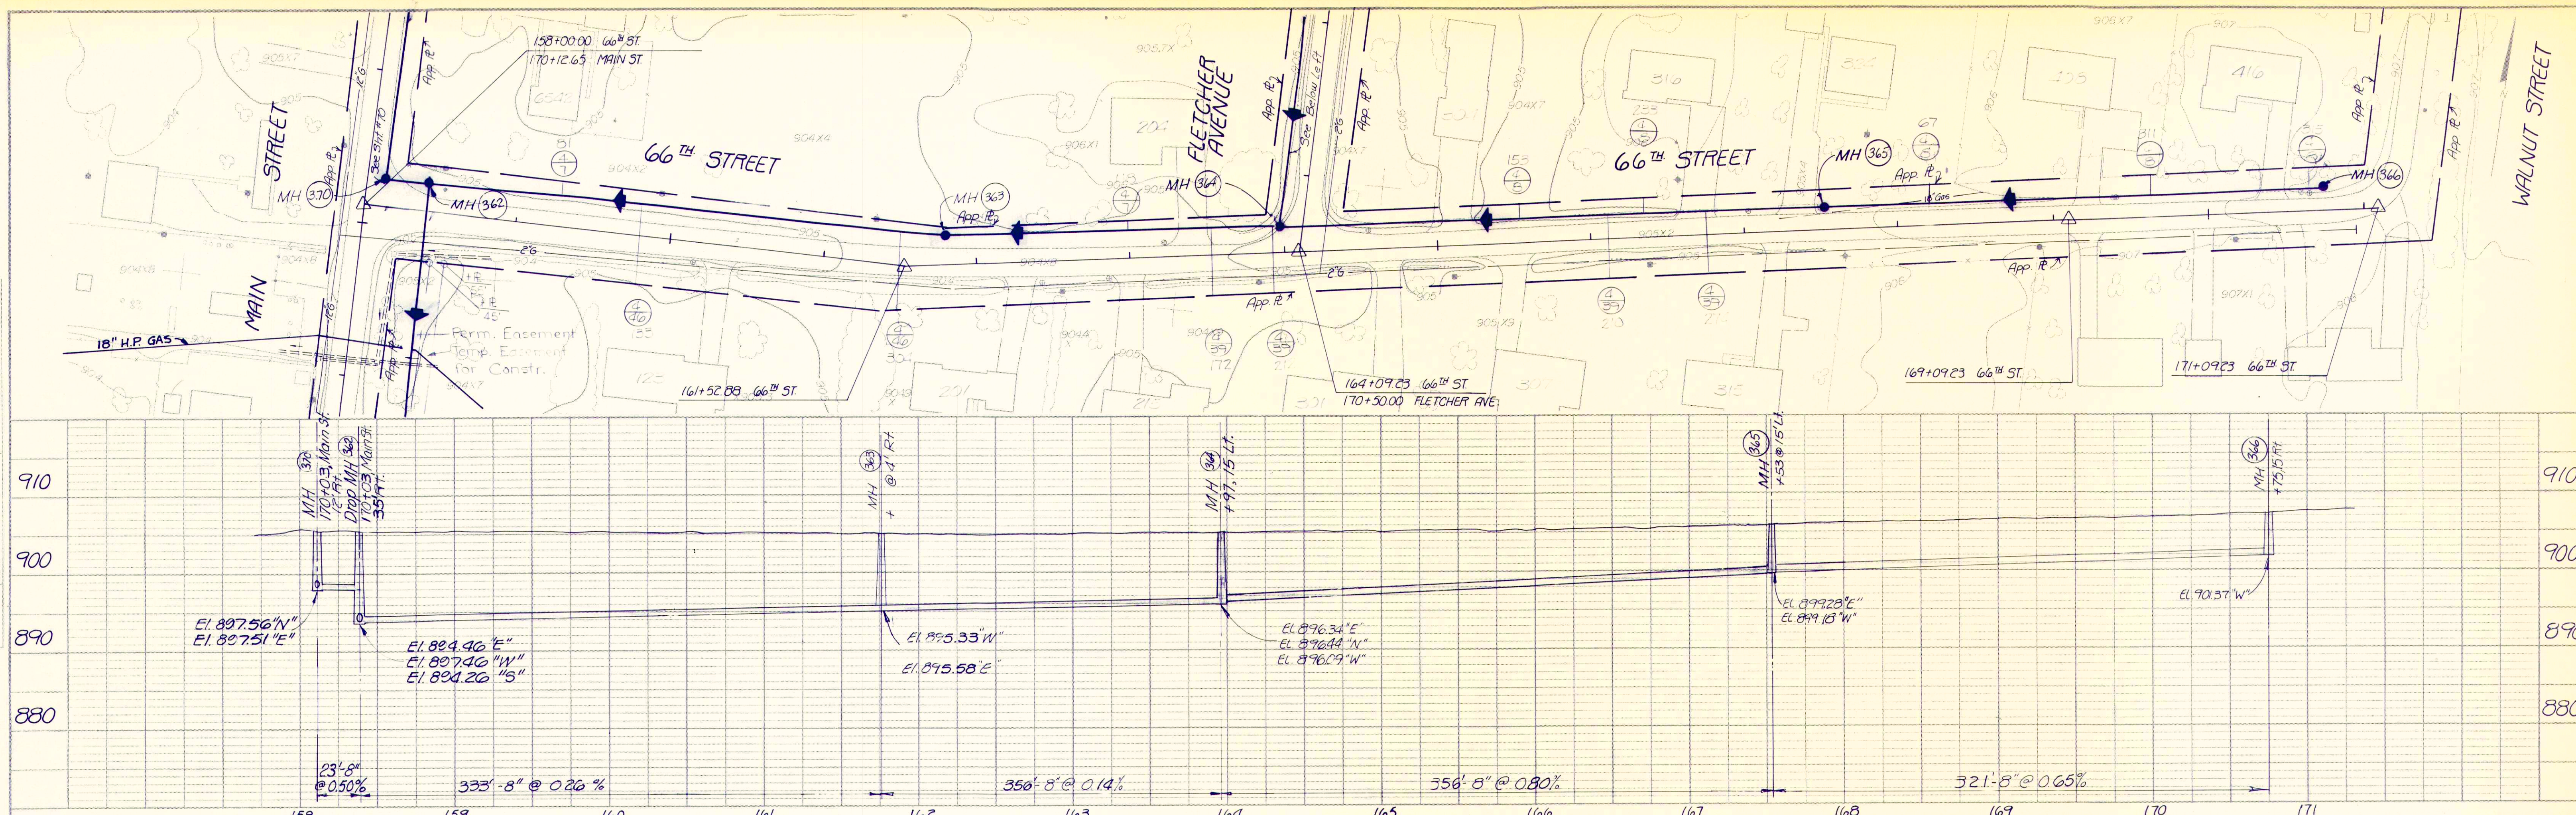