


PLAN
 NOTE BOOK
 NO.

PROFILE
 NOTE BOOK
 NO.

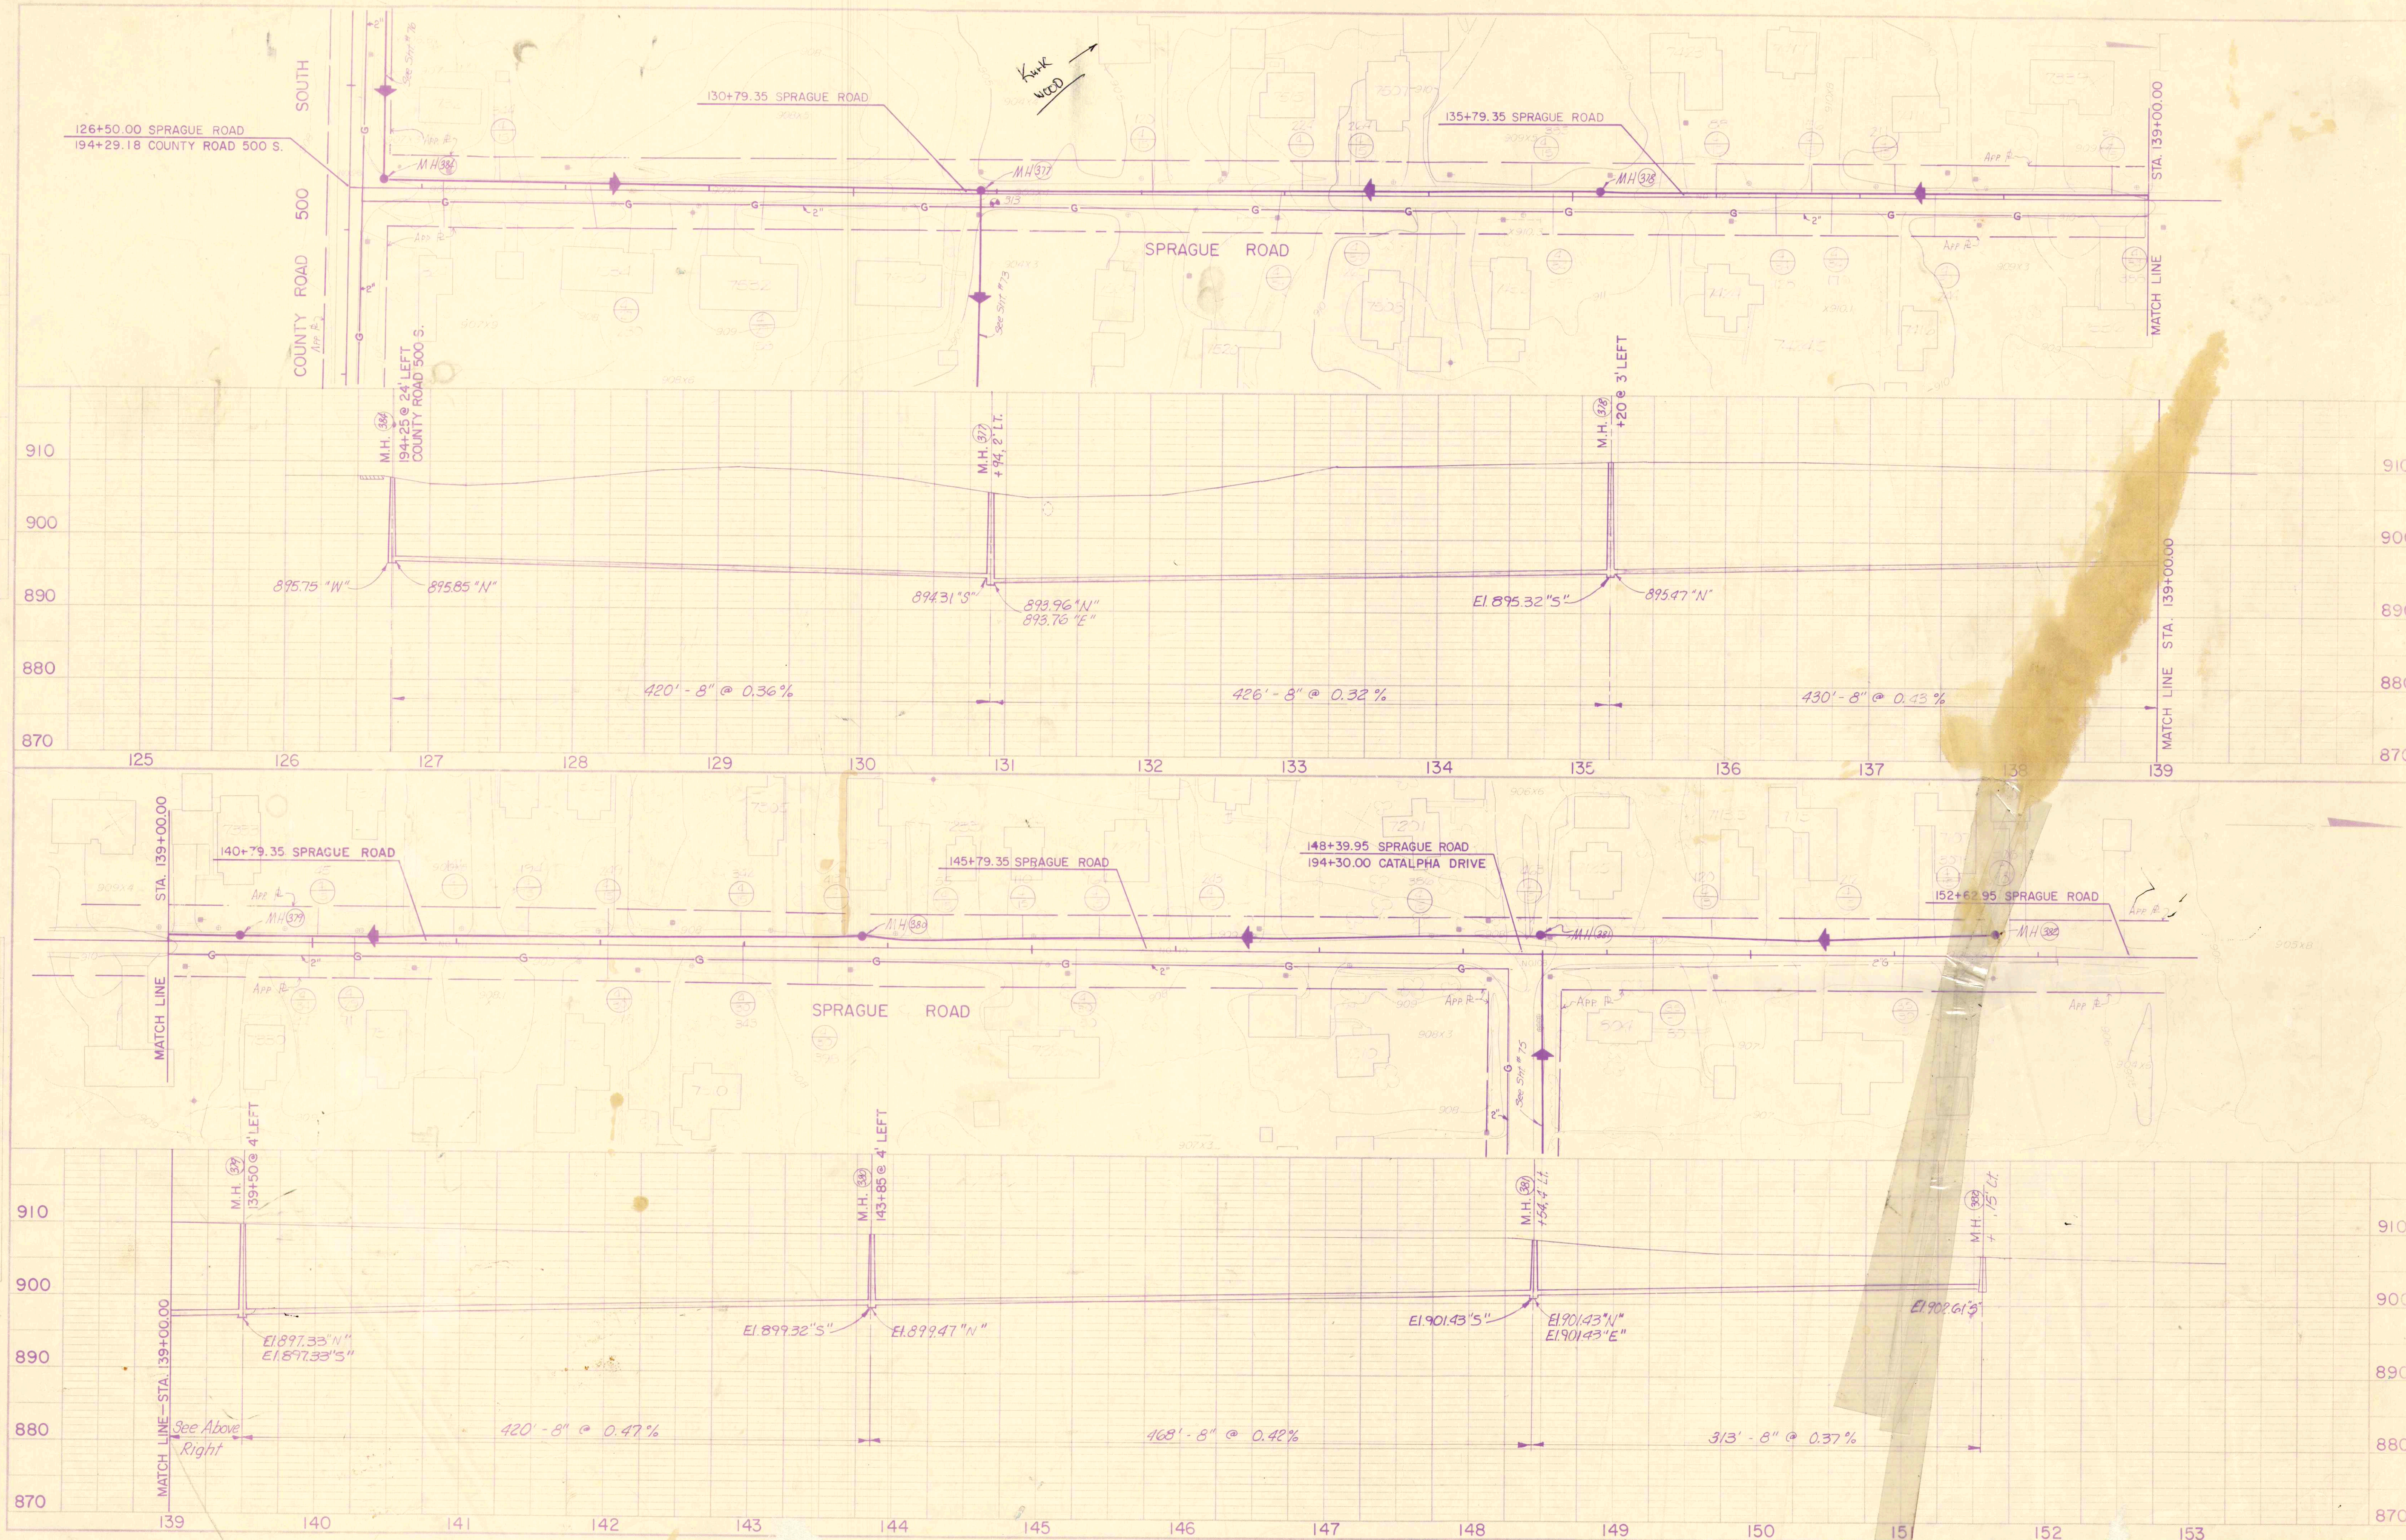

RECORD DRAWING