


PLAN
 SHEET NO. 1
 DATE: 10/1/12
 BY: J. R. NEFF
 CHECKED: J. R. NEFF
 NO. OF SHEETS: 2

PROFILE
 SHEET NO. 2
 DATE: 10/1/12
 BY: J. R. NEFF
 CHECKED: J. R. NEFF
 NO. OF SHEETS: 2

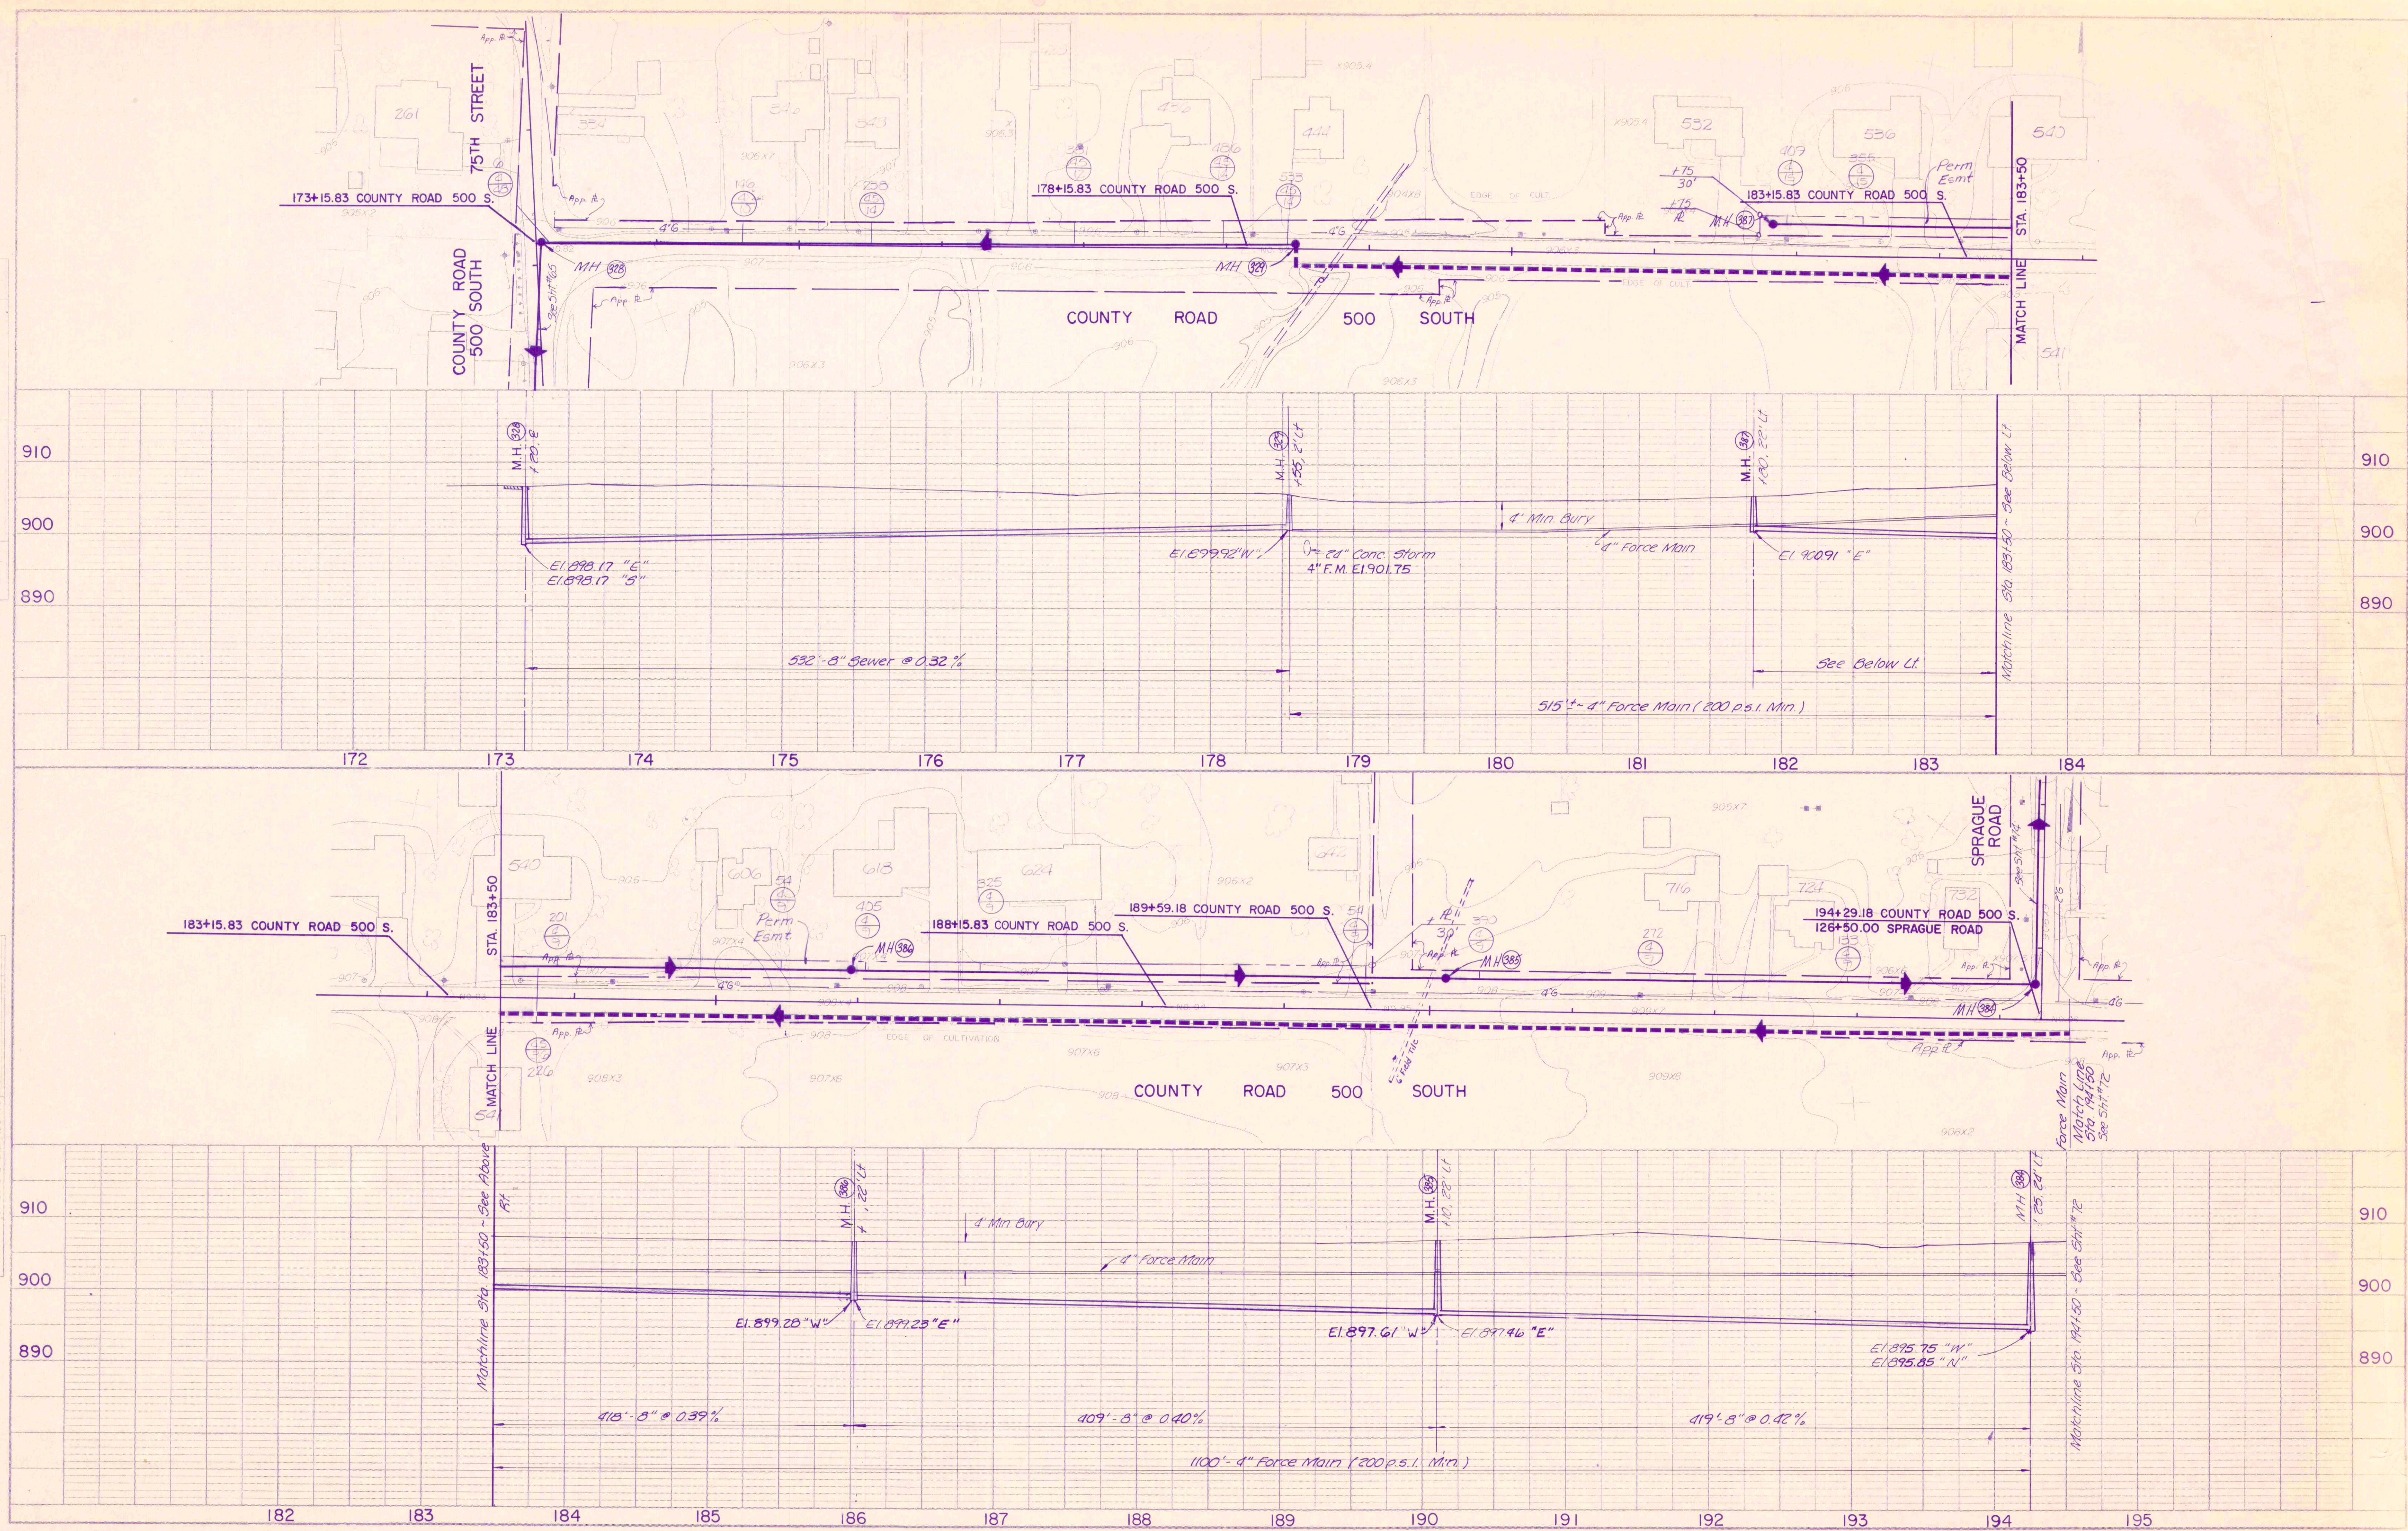

RECORD DRAWING

3-30-83