


LIFT STATION	A	B	C	D	E	F	G	H	I	J	K	L	M	N	O	P	Q	R	S	T	U	V	W	X	Y	Z	AA
U.S. 36 (3 PUMPS)	856.00	857.68	836.38	21.00'	845.46	8'-0"	10'-0"	240-30	3#000 1#10	2 1/2"	200A	837.10	843.50	844.00	845.00	845.50	15'-0"	416	62	20	4'x4'	4"	130	1'-6"	1" MIN.	1" MIN.	16'-0"
REGENCY MOBILE H.P.	890.00	891.37	881.16	10.00'	887.04	4'-0"	5'-0"	240-10	2#6 1#10	1"	60A	881.50	883.90	884.40	—	884.88	8'-0"	47	54	3	3'x3'	2"	100	6"	1" MIN.	1" MIN.	5'-0"
FALCONHURST	891.00	891.87	870.46	20.00'	877.17	4'-0"	5'-0"	240-10	2#6 1#10	1"	60A	872.50	875.50	876.50	—	877.49	10'-0"	35	50	3	3'x3'	2"	100	6"	1" MIN.	1" MIN.	15'-0"
C.R. 100 W. (3 PUMPS)	867.75	868.32	839.70	29.00'	848.41	8'-0"	10'-0"	240-30	3#000 1#10	2 1/2"	200A	840.75	847.00	847.50	848.00	848.75	15'-0"	353	73	20	4'x4'	4"	130	1'-6"	1" MIN.	1" MIN.	20'-0"
C.R. 550 S.	893.90	893.63	884.19	11.00'	886.81	4'-0"	5'-0"	240-10	2#6 1#10	1"	60A	885.00	885.85	887.00	—	887.10	10'-0"	28	33	3	3'x3'	2"	100	6"	1" MIN.	1" MIN.	5'-6"
PARADISE VILLAGE	895.00	896.56	874.46	22.00'	880.29	8'x8'x7'	10'-0"	240-30	3#2 1#10	1 1/2"	100A	875.25	878.50	879.50	—	879.70	12'-0"	640	31	10	4'x4'	4"	100	1'-6"	1" MIN.	1" MIN.	16'-0"
NORRIS HEIGHTS	905.60	906.06	877.50	29.00'	881.86	5'-0"	8'-0"	240-30	3#6 1#10	1"	60A	878.75	881.65	882.50	—	882.70	12'-0"	360	27	7.5	4'x4'	4"	50	1'-0"	1" MIN.	1" MIN.	23'-0"
BABY FARMS	889.70	891.05	875.65	16.00'	880.50	4'-0"	5'-0"	240-30	3#6 1#10	1"	60A	876.25	879.25	880.00	—	880.50	8'-0"	90	49	5.0	3'x3'	2"	100	6"	1" MIN.	1" MIN.	6'-0"
LANTERN MEADOWS	877.00	878.00	852.70	26.50'	858.84 W	5'-0"	5'-0"	240-30	3#6 1#10	1"	60A	852.00	856.00	857.00	—	857.50	10'-0"	100	37	5.0	3'x3'	4"	100	1'-0"	1" MIN.	1" MIN.	20'-0"

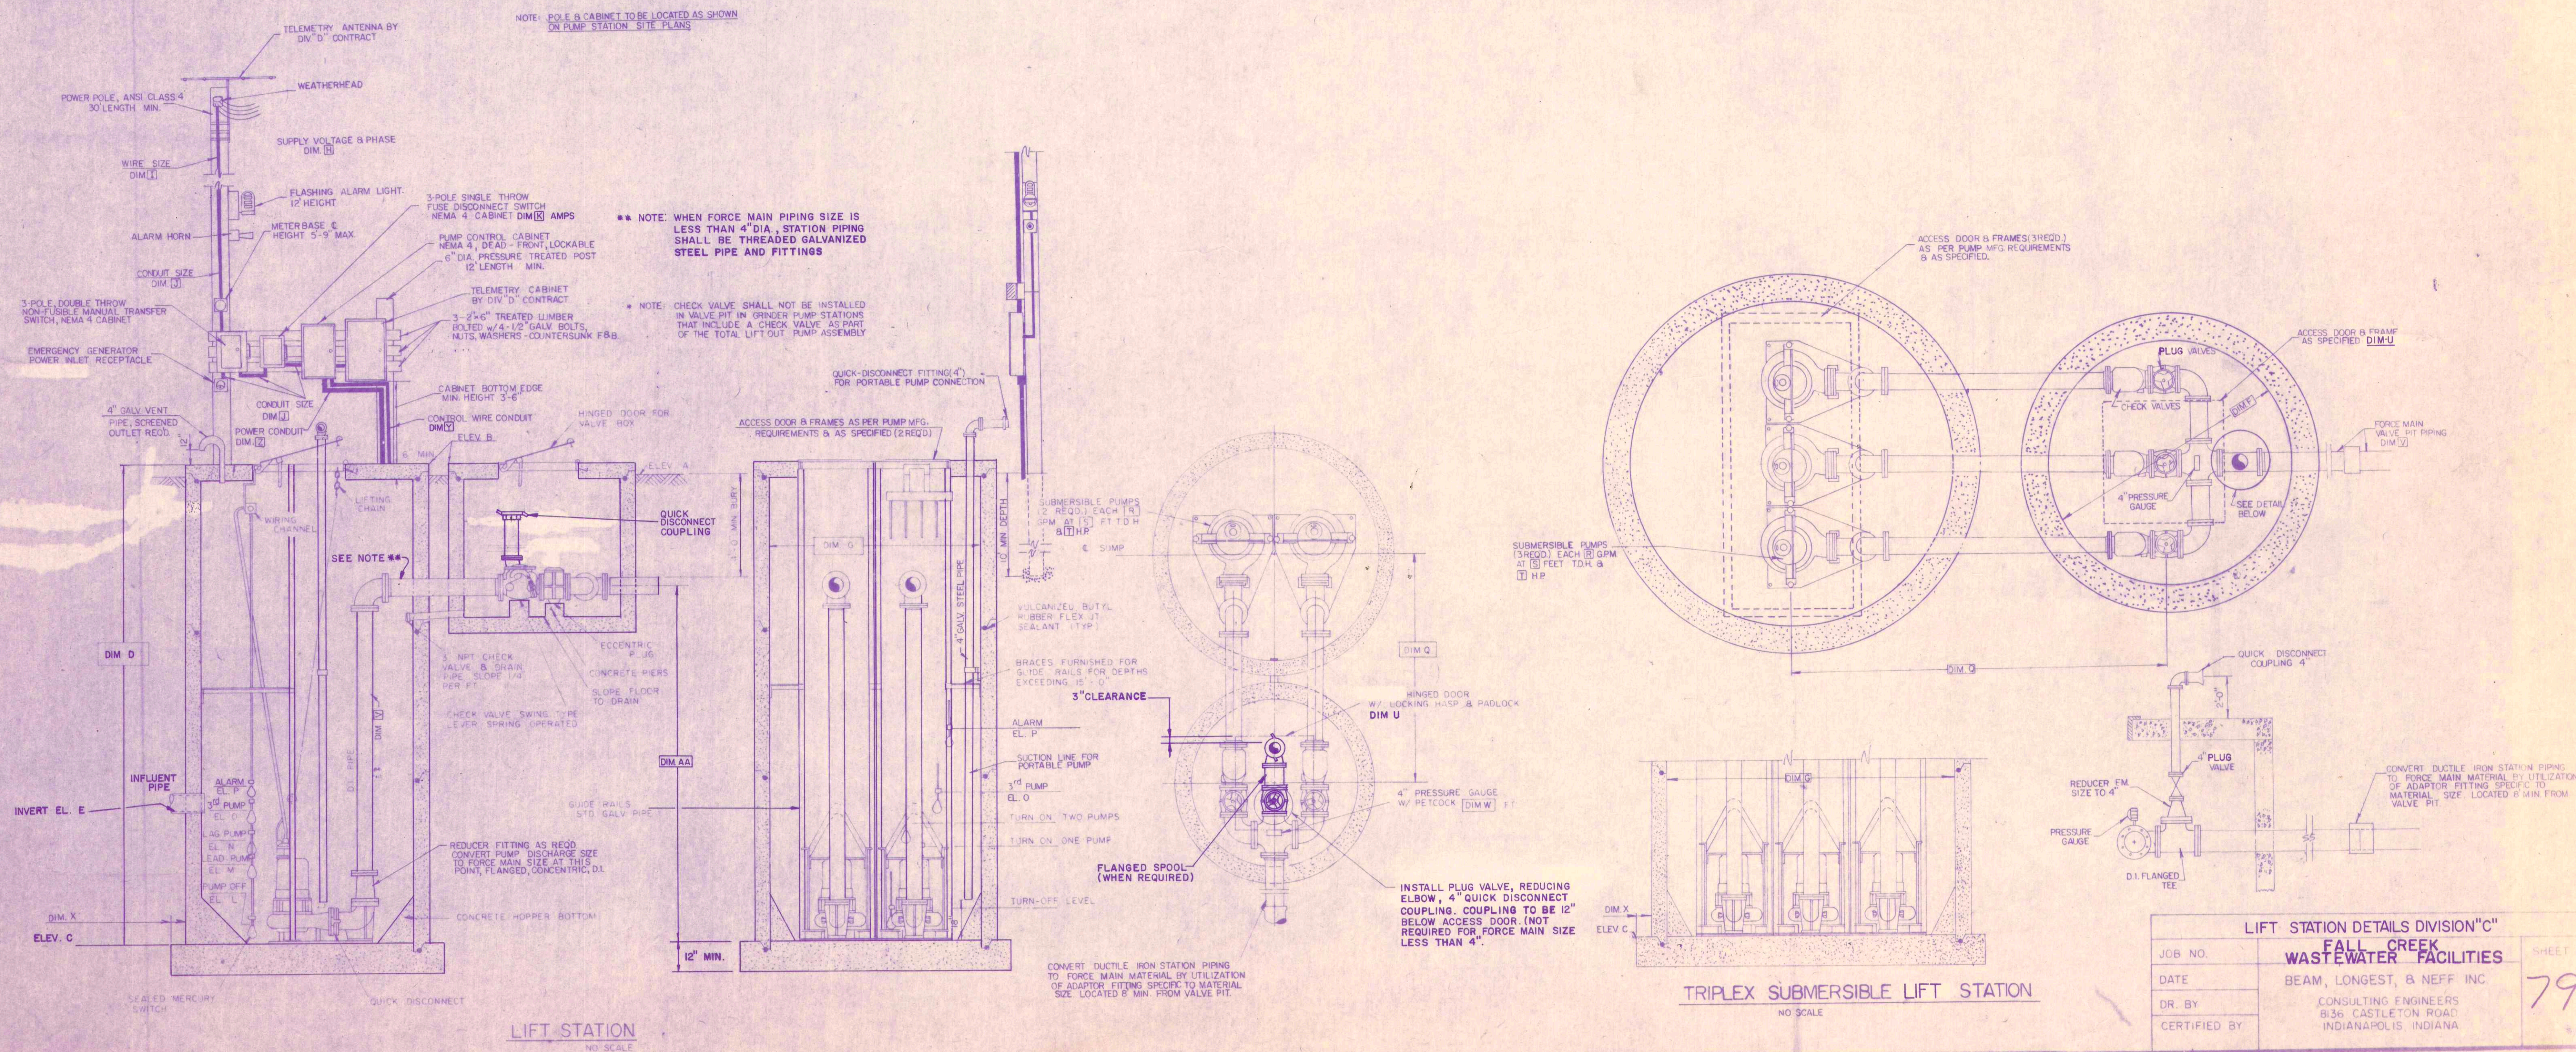

RECORD DRAWING