



TYPE "A" VALVE BOX  
NO SCALE

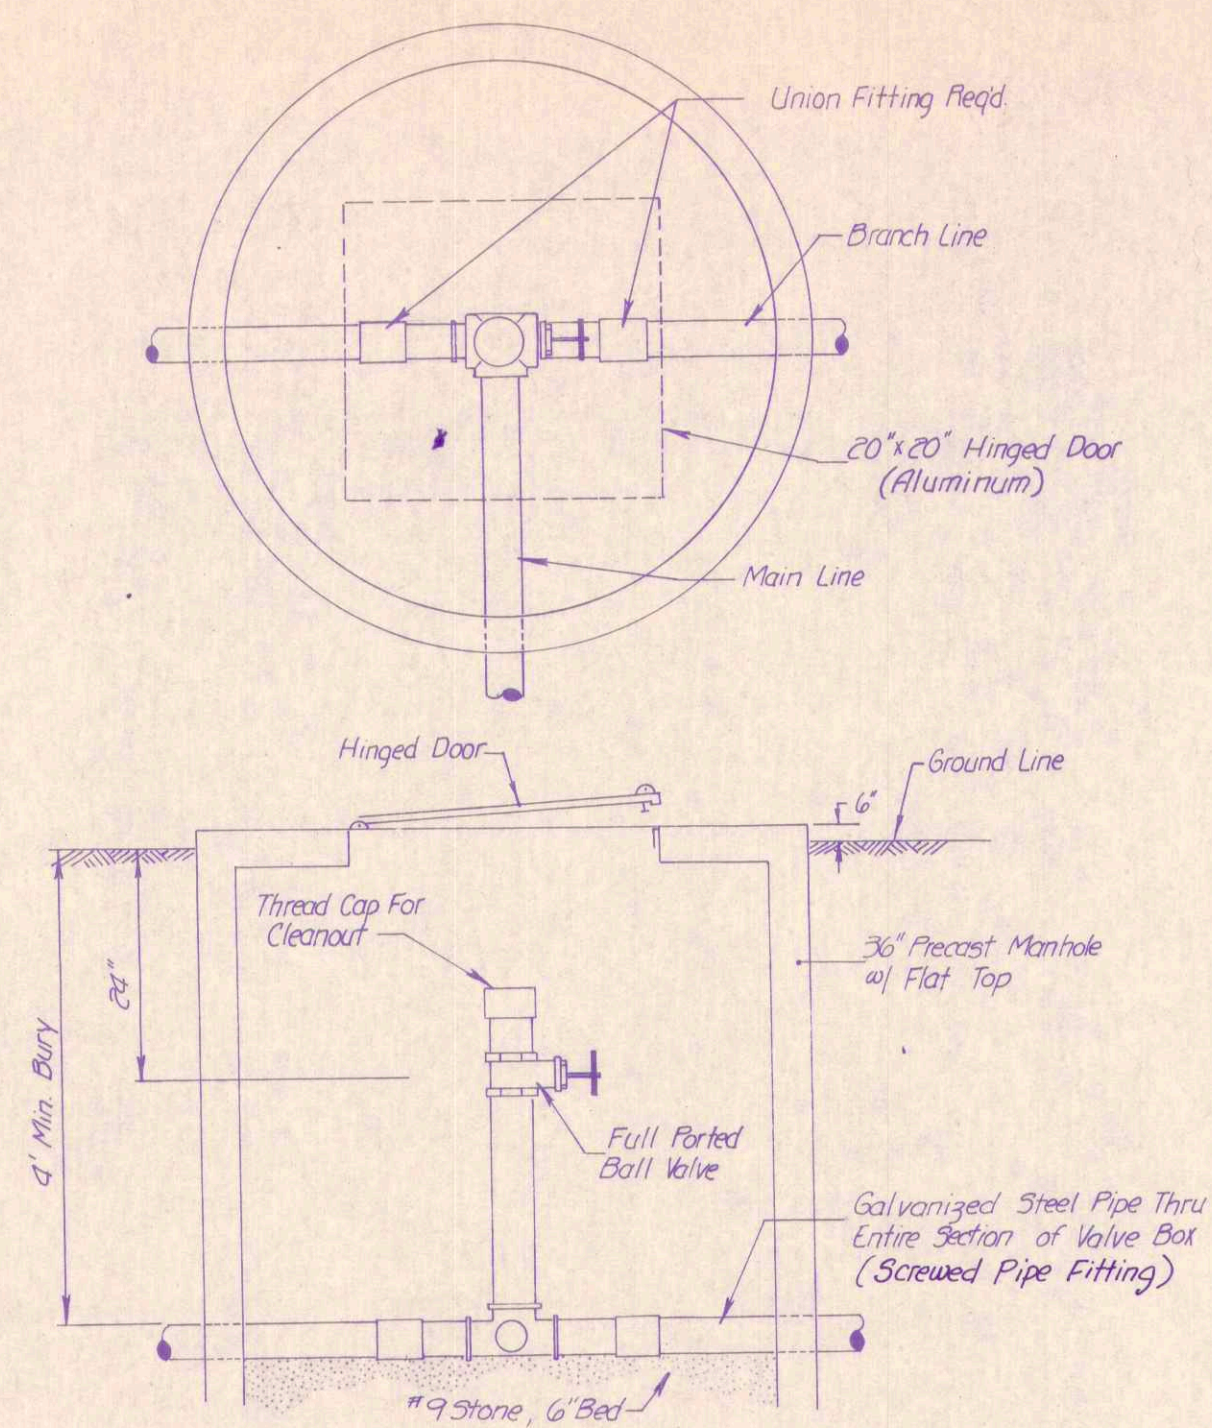


TYPE "B" VALVE BOX  
NO SCALE

#### VALVE BOX NOTES



- 1) STANDARD THREADED GALVANIZED T-FITTING, MAY BE UTILIZED IN LIEU OF A SIDE OUTLET TEE OR A SIDE OUTLET CROSS.
- 2) CLEANOUT RISER AND VALVE SHALL BE SIZED TO MATCH LARGEST PRESSURE SEWER ENTERING VALVE BOX.
- 3) SIZE REDUCTION/INCREASE SHALL BE MADE WITH STD. REDUCER FITTINGS INSIDE VALVE BOX.
- 4) GALVANIZED PIPE TO EXTEND TO 5' MINIMUM OUTSIDE VALVE BOX.

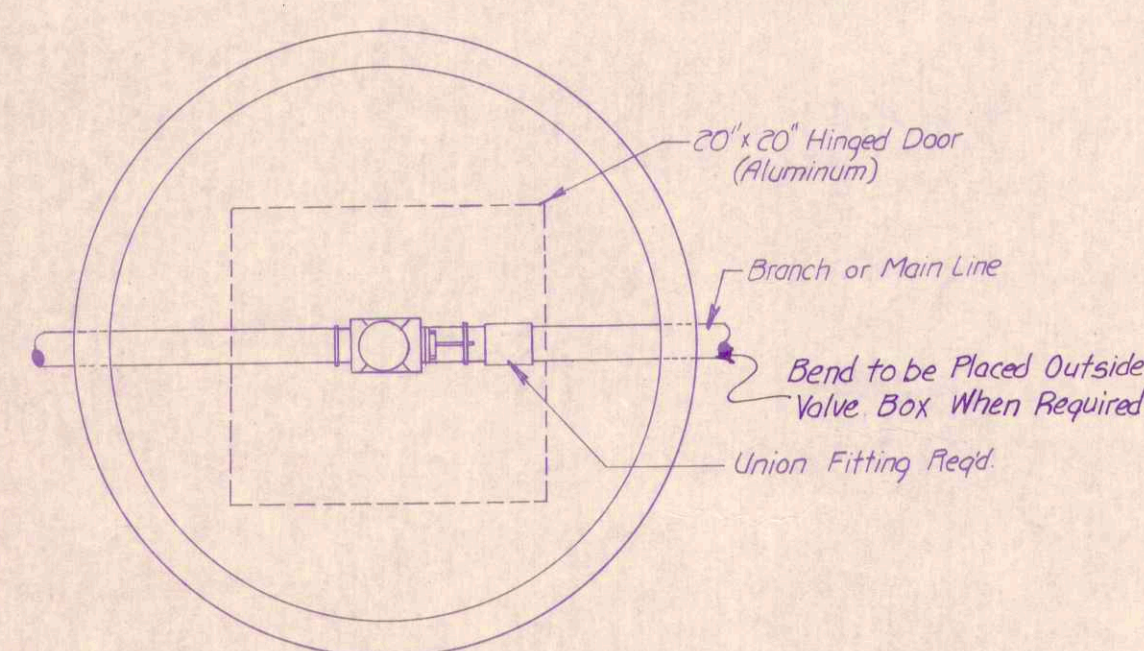


TYPE "C" VALVE BOX  
NO SCALE

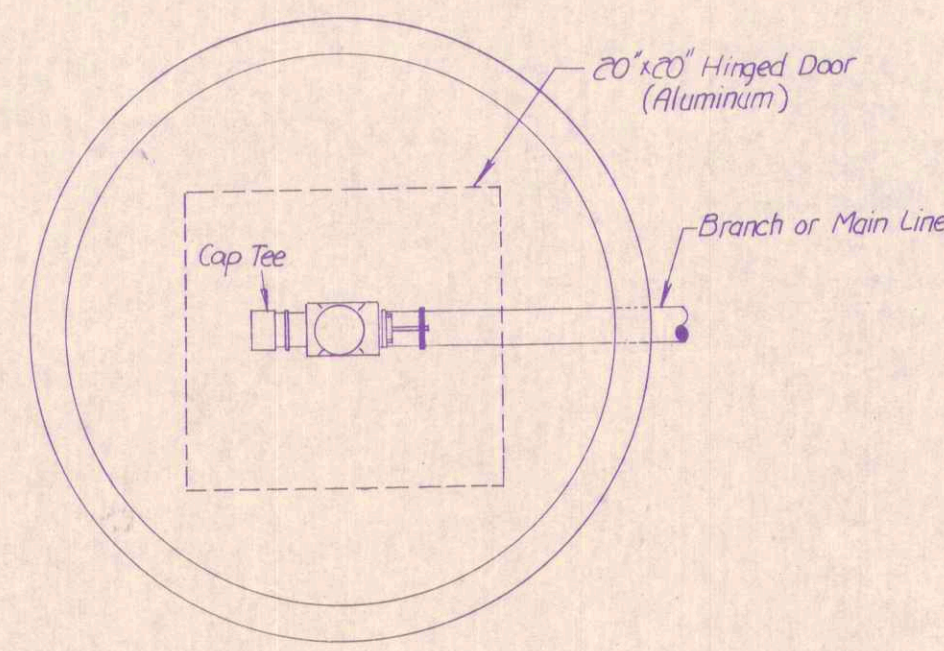

TYPE "D" VALVE BOX  
NO SCALE

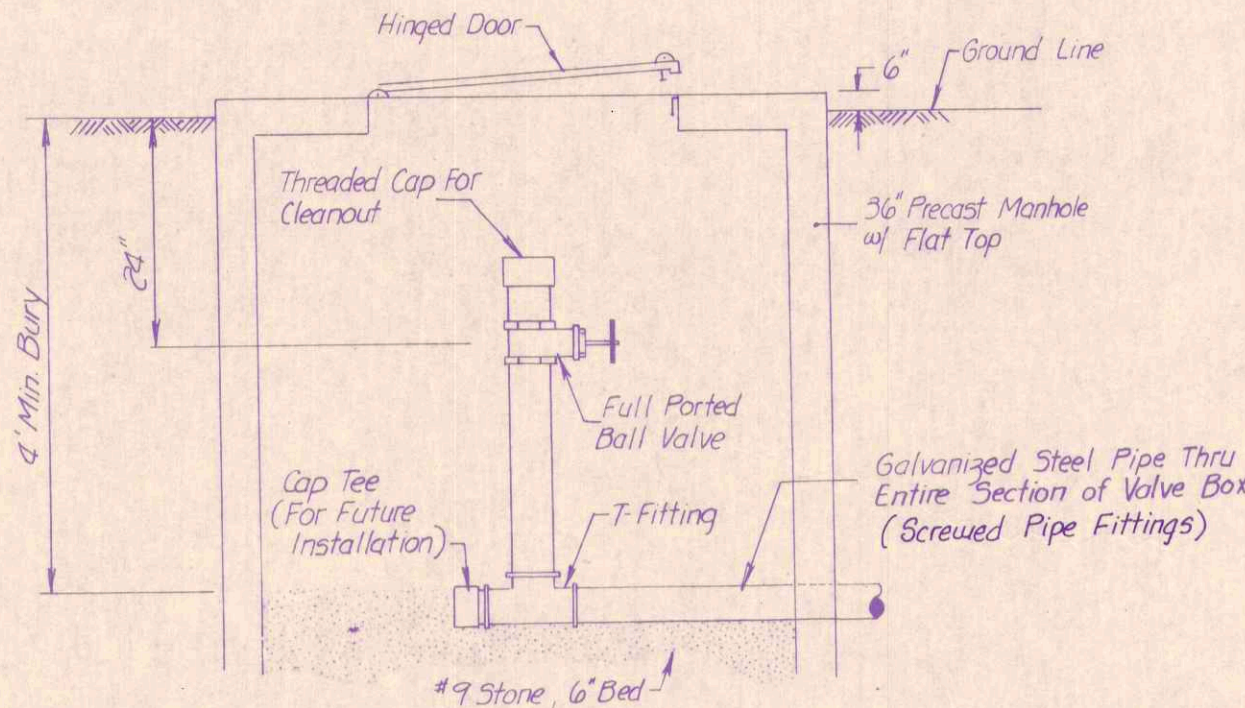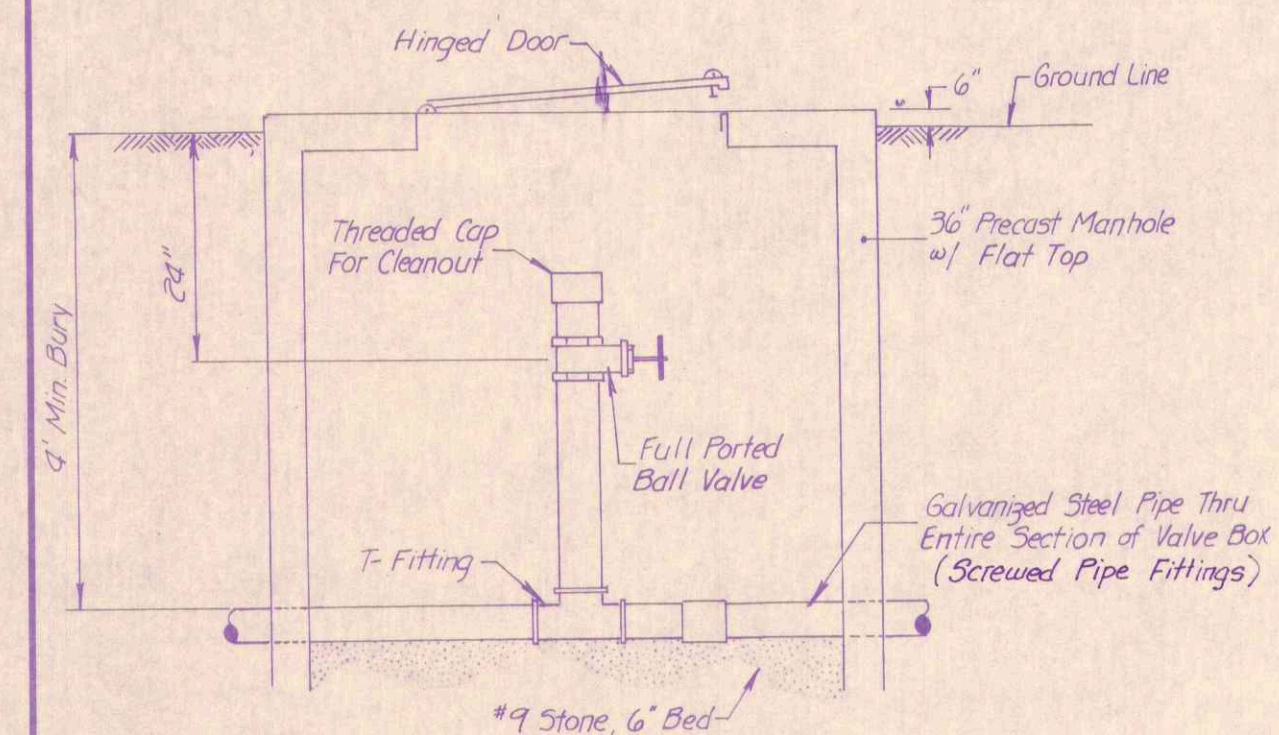

#### VALVE BOX DETAILS

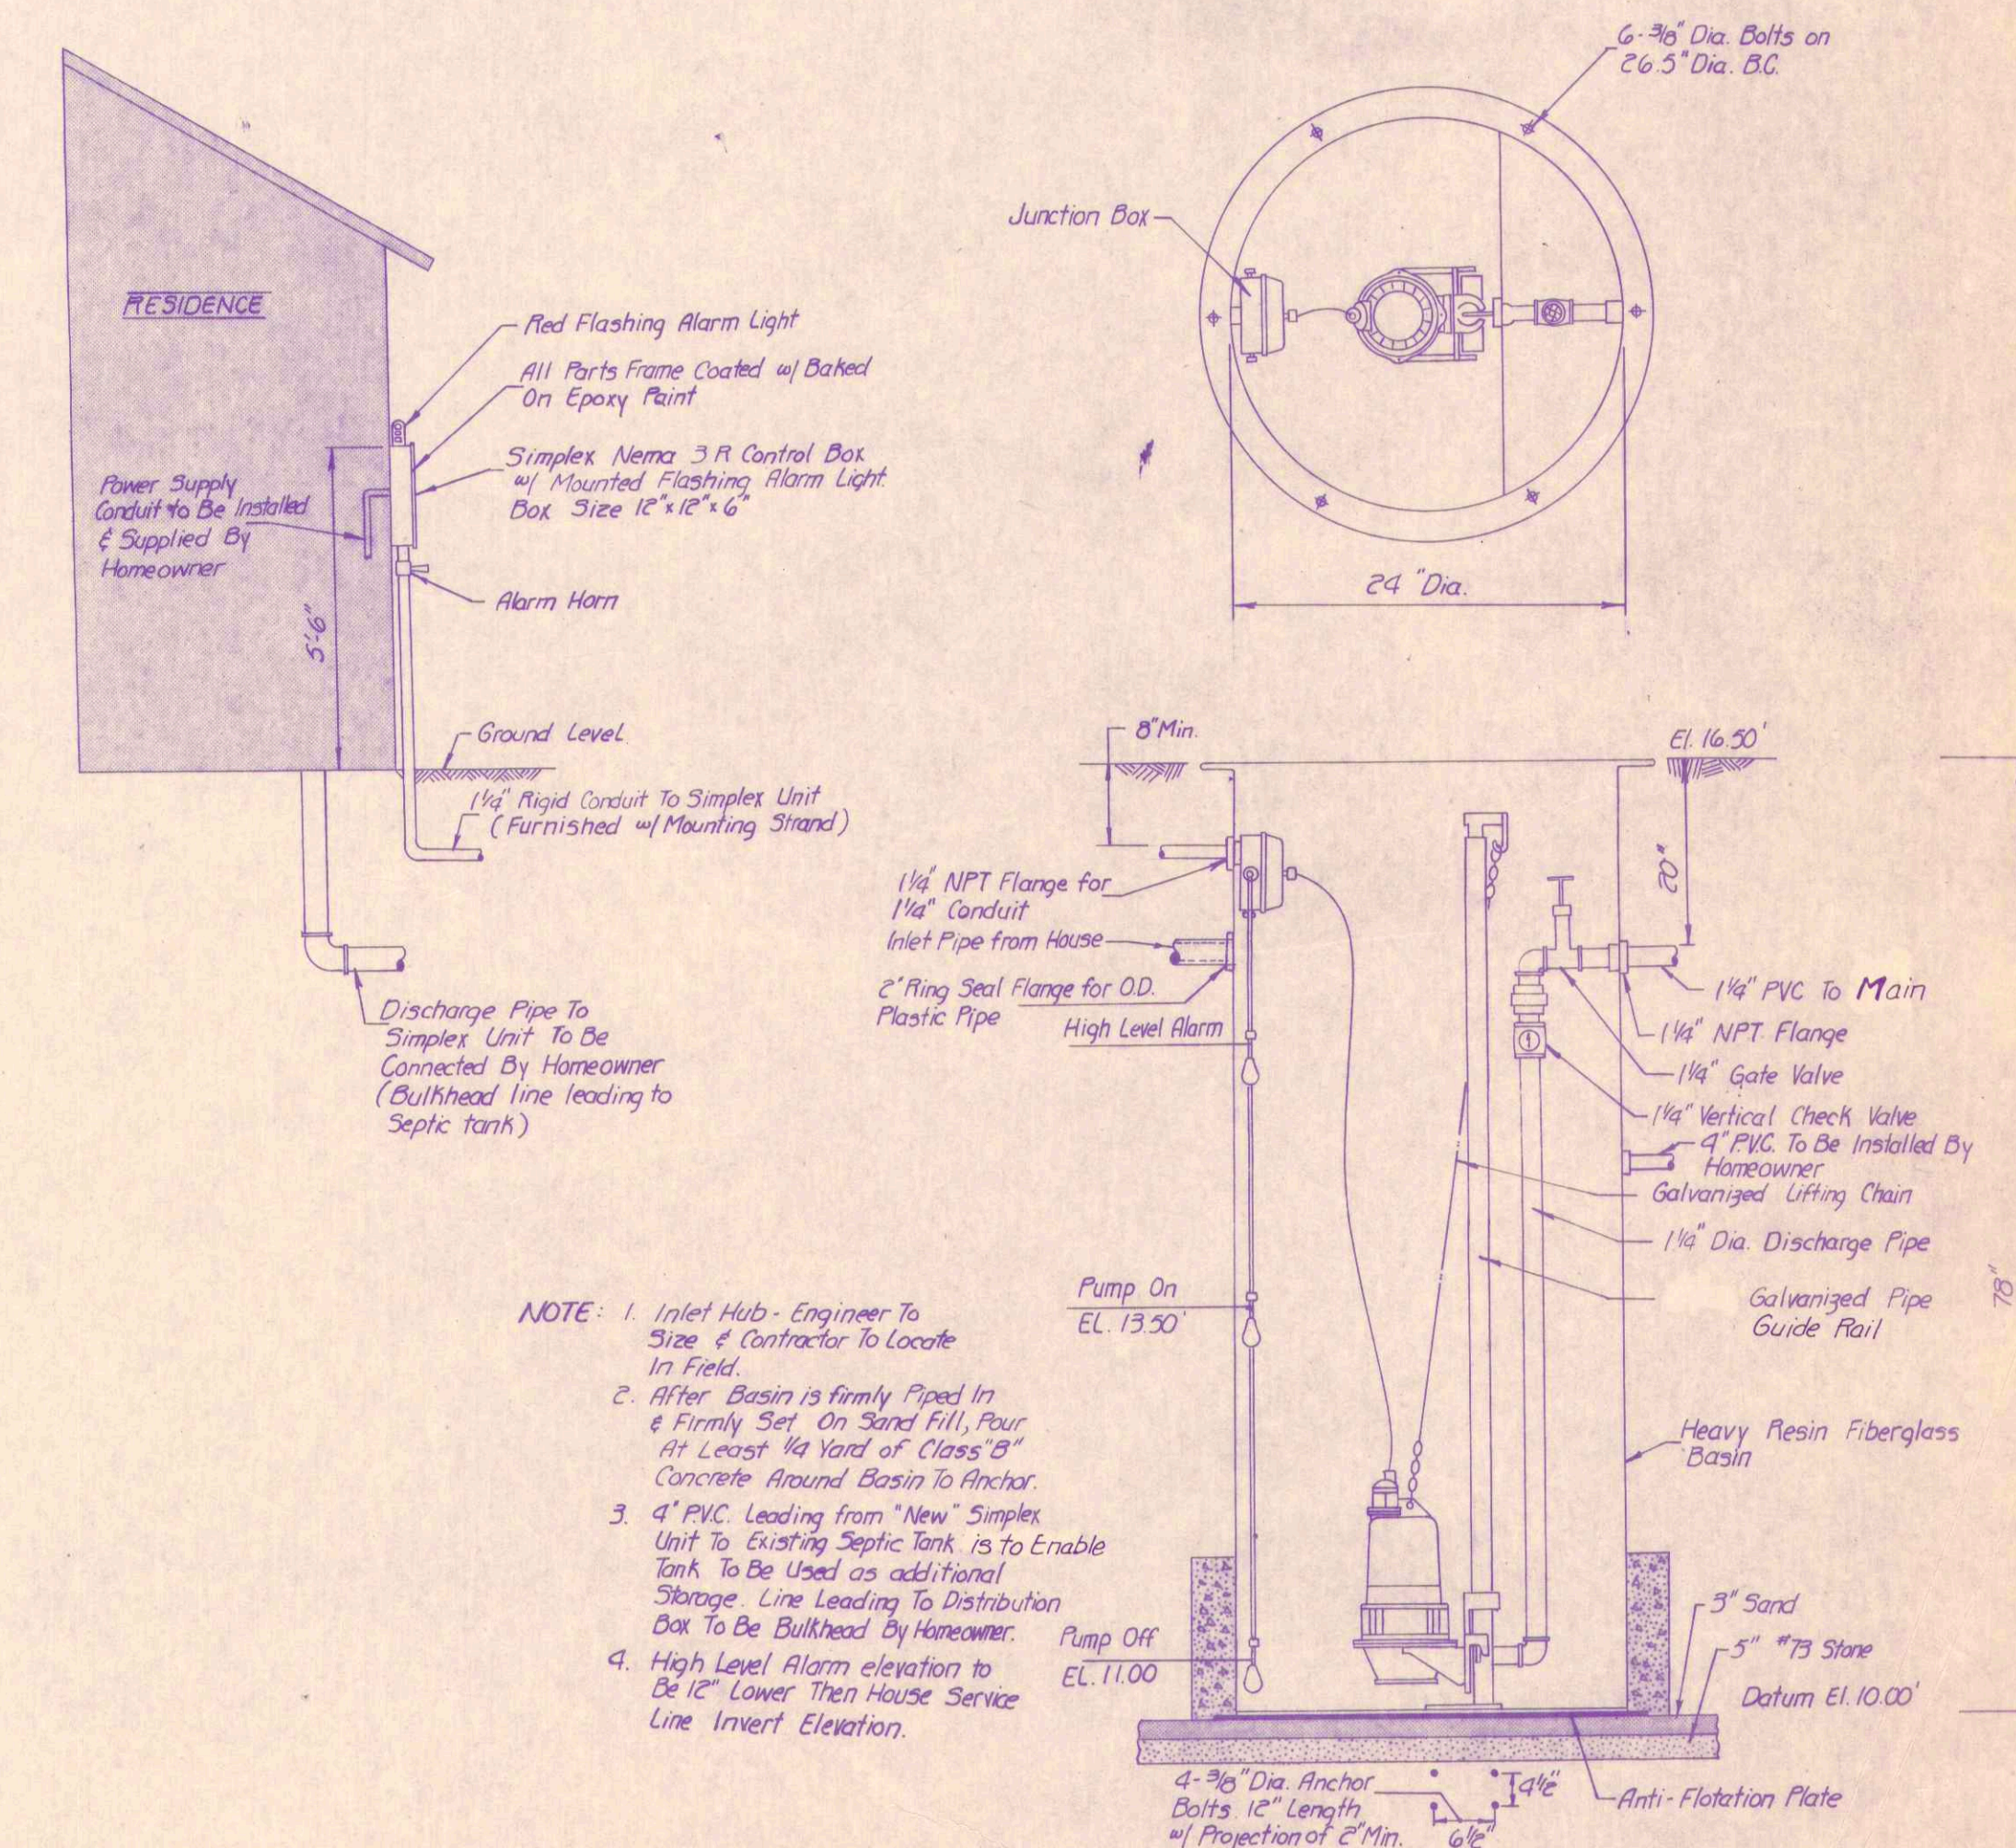

SIMPLEX UNIT GRINDER PUMP  
NO SCALE

RECORD DRAWING

	GRINDER STATION & PRESSURE SEWER DETAILS		
	Scale: NONE	FALL CREEK WASTEWATER FACILITIES	Sheet
	Drawn By:	BEAM, LONGEST & NEFF	80
	Designed By:	Consulting Engineers 8136 Castleton Road Indianapolis, IN 46250	