

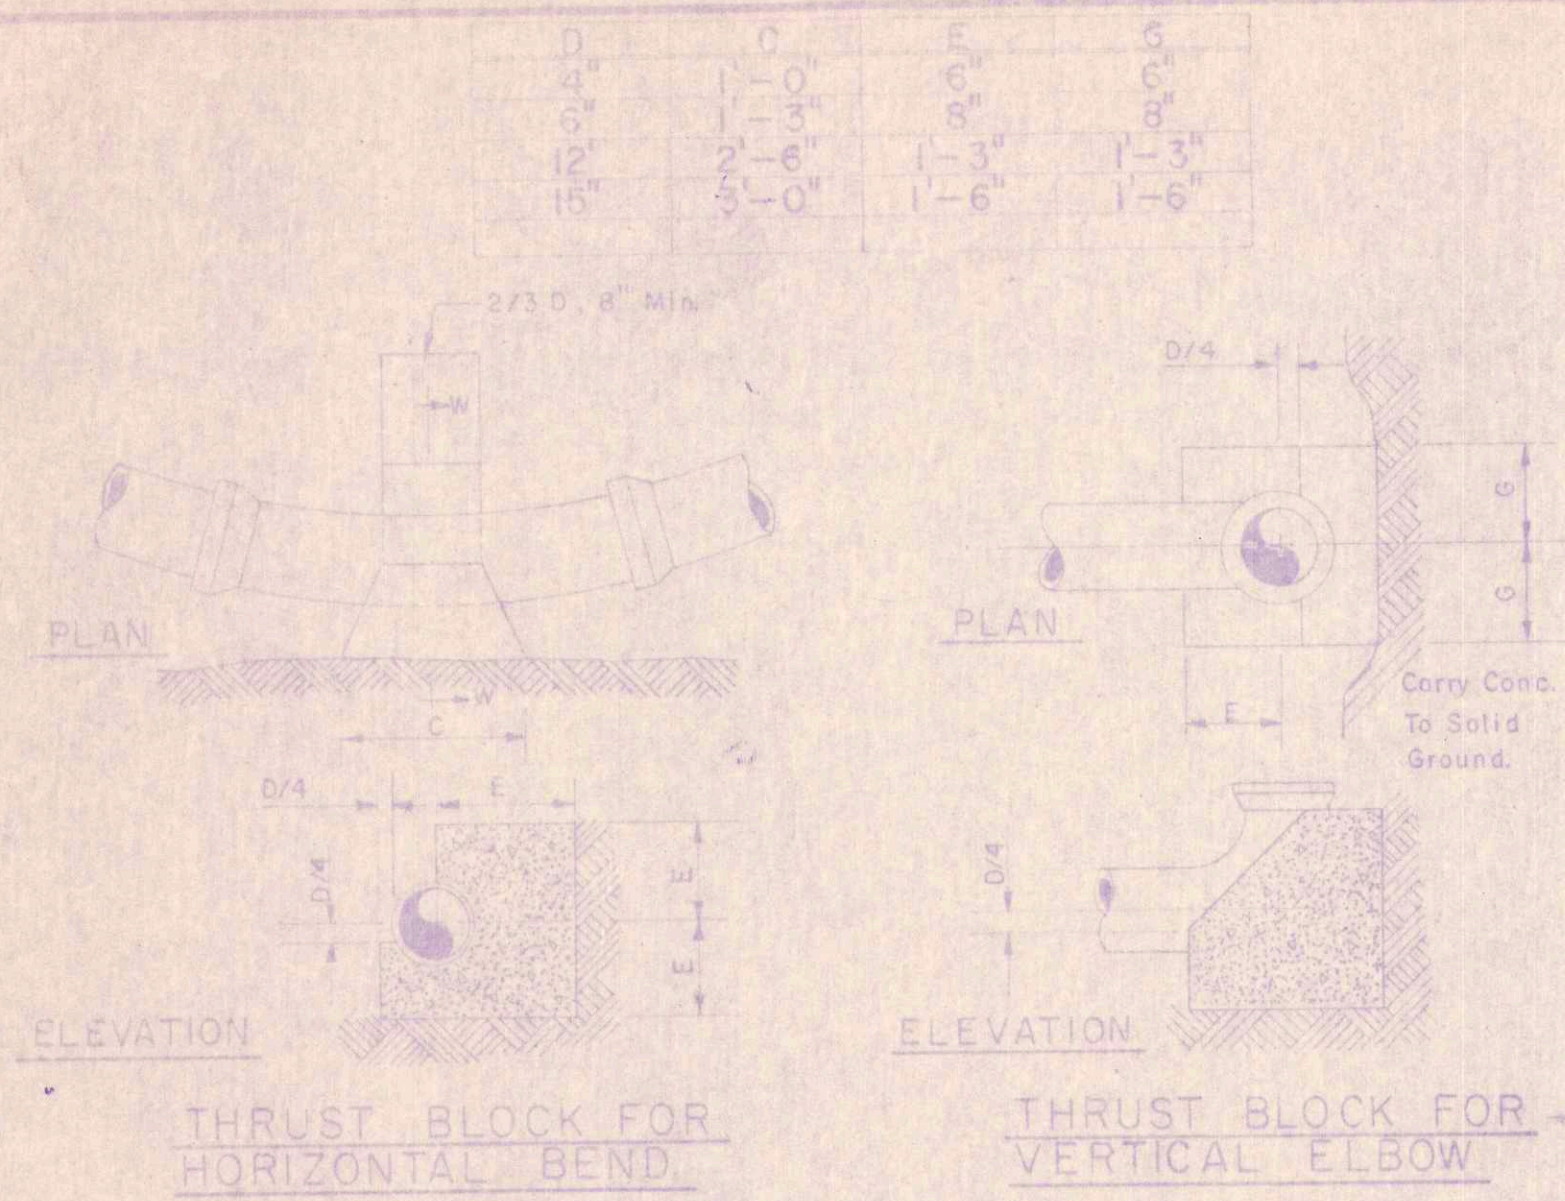


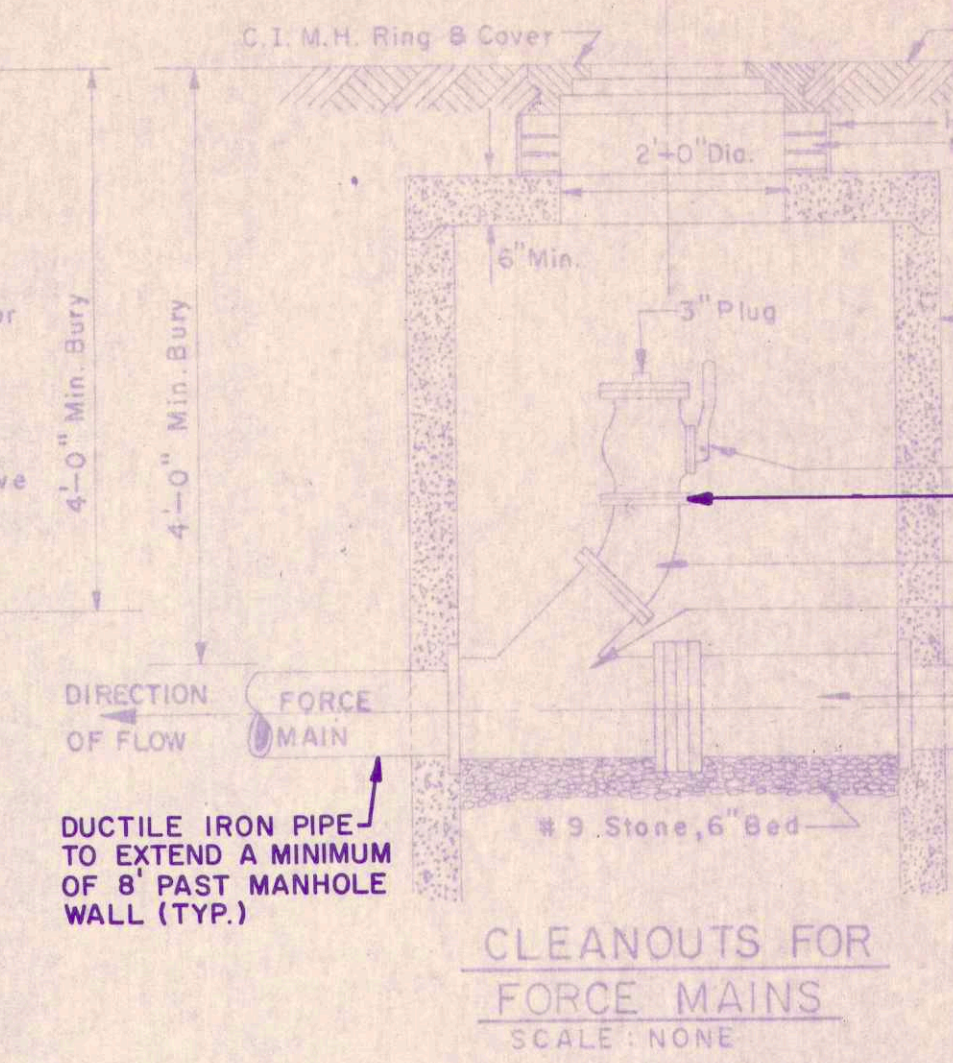


Scale: None
(Thrust Blocks To Be Provided At All Bends In Force Mains)



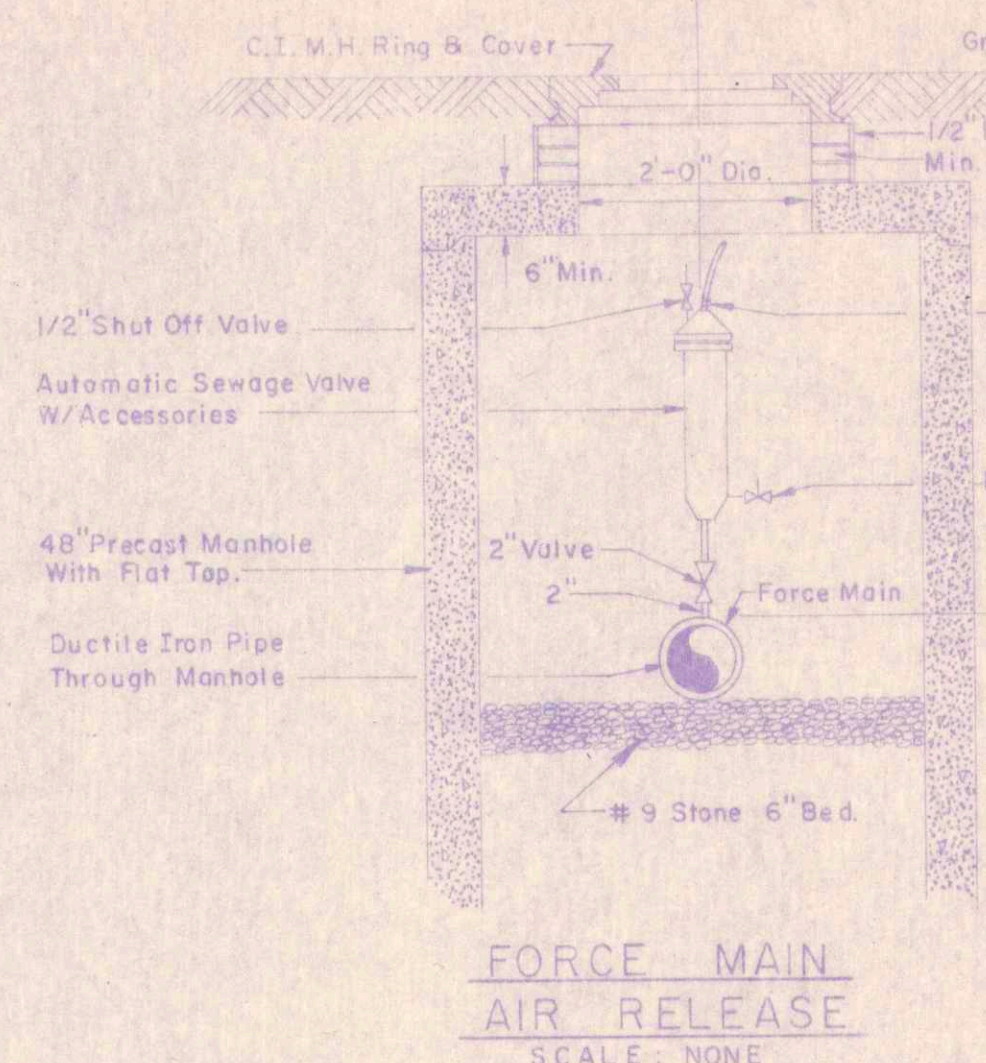


ALL PIPING JOINTS IN MANHOLE SHALL BE EITHER MECHANICAL OR FLANGED



NOTE: If Slip Joints are used, then this Lateral must have a Mechanical Joint on the Lateral.

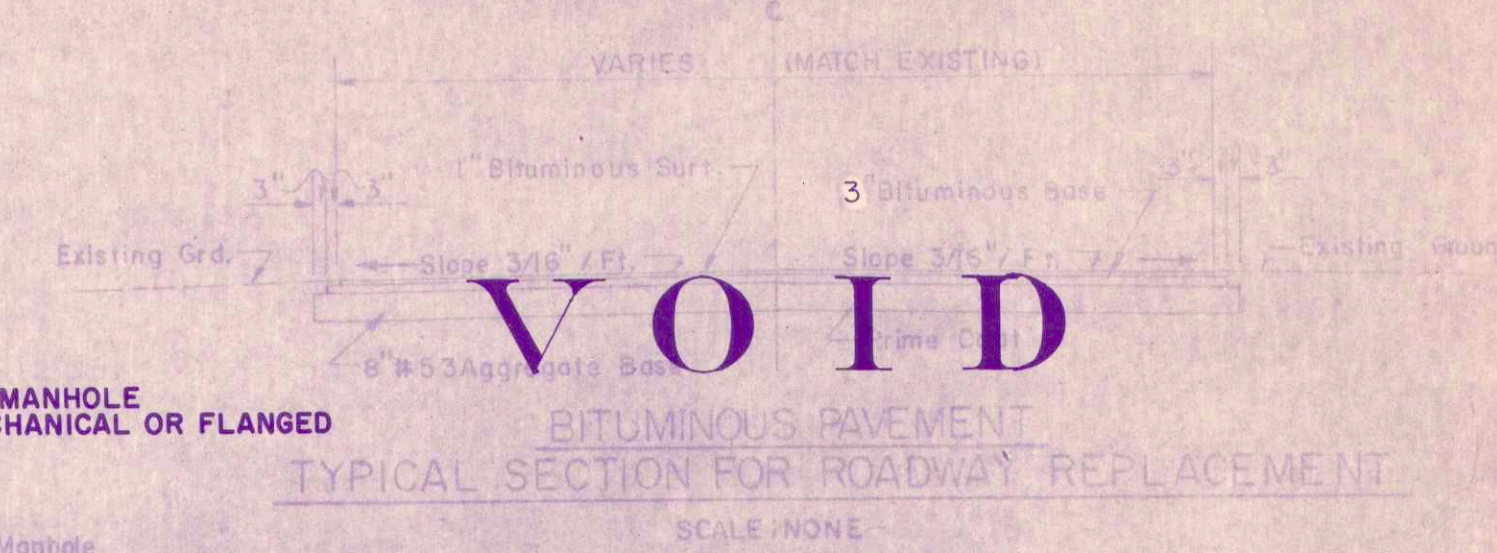

VOID

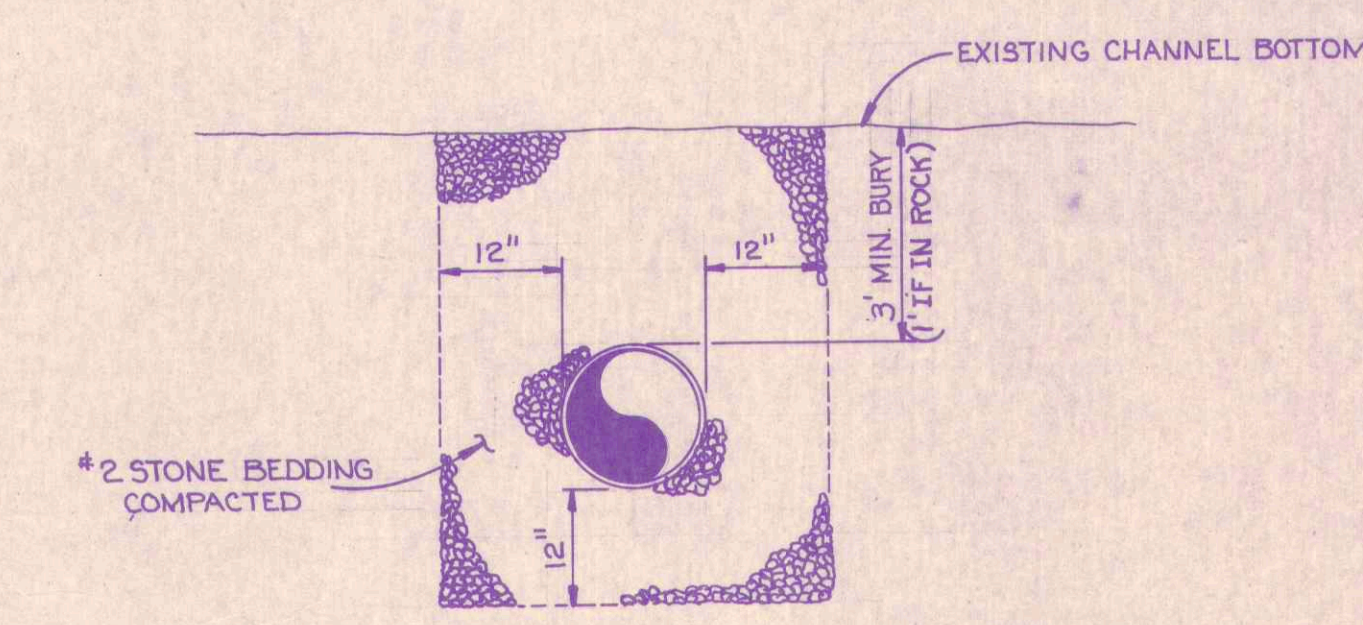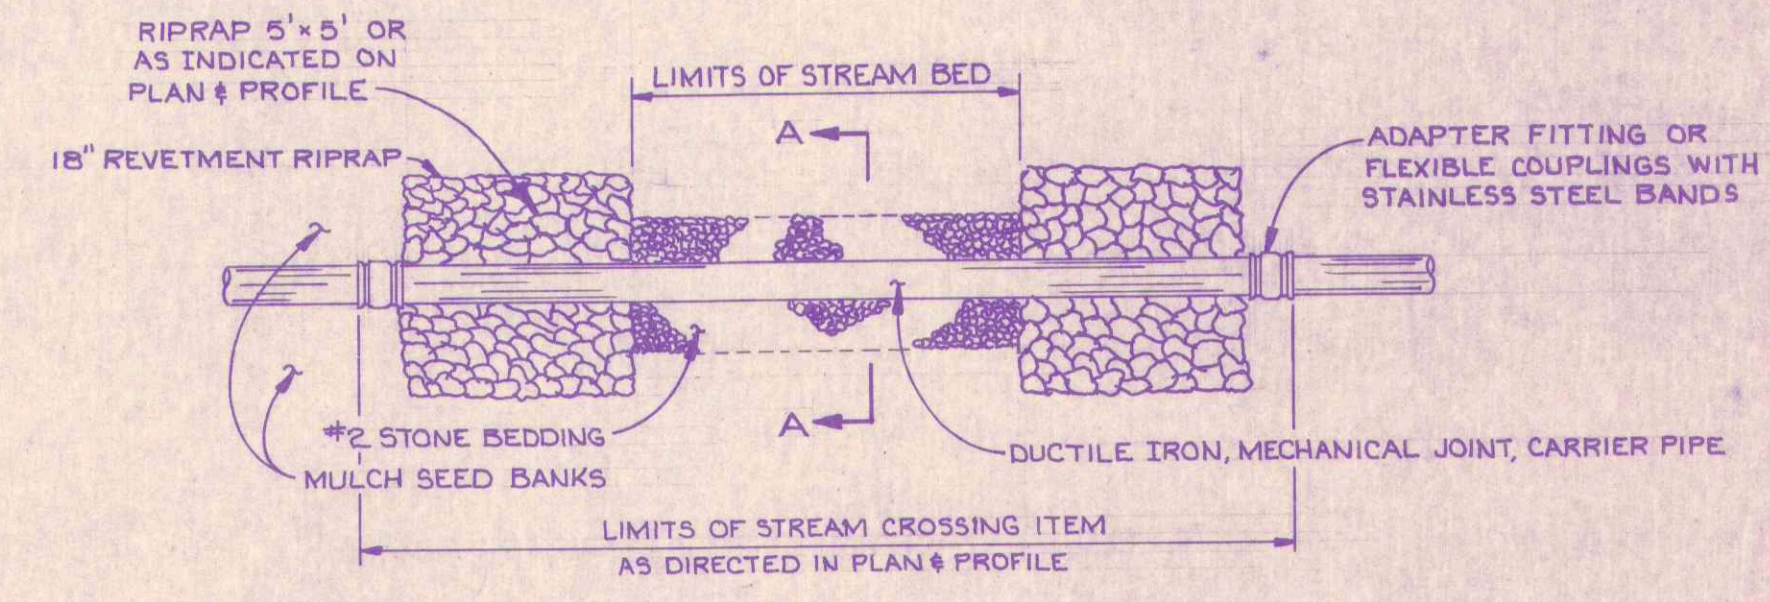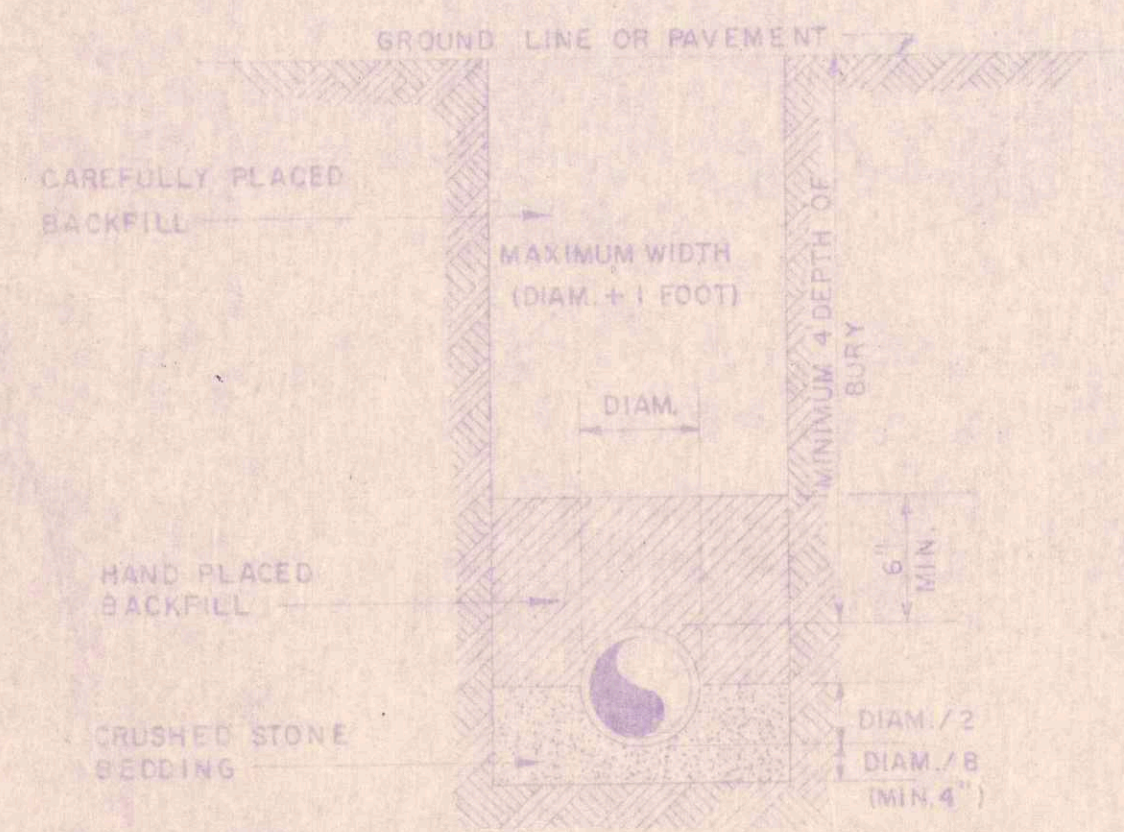

STREAM CROSSING DETAIL

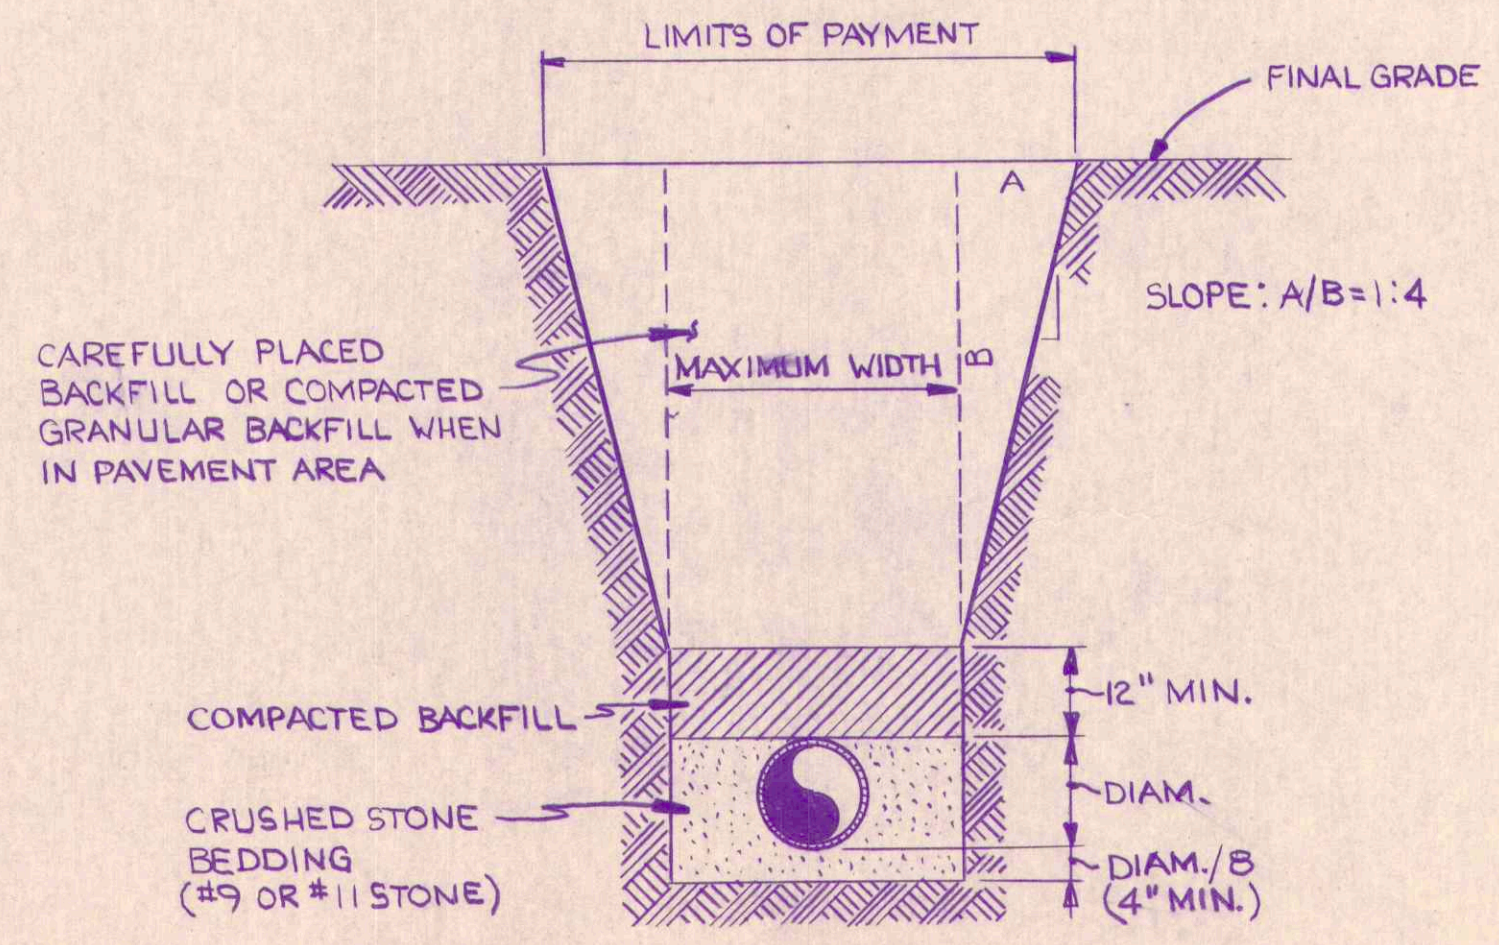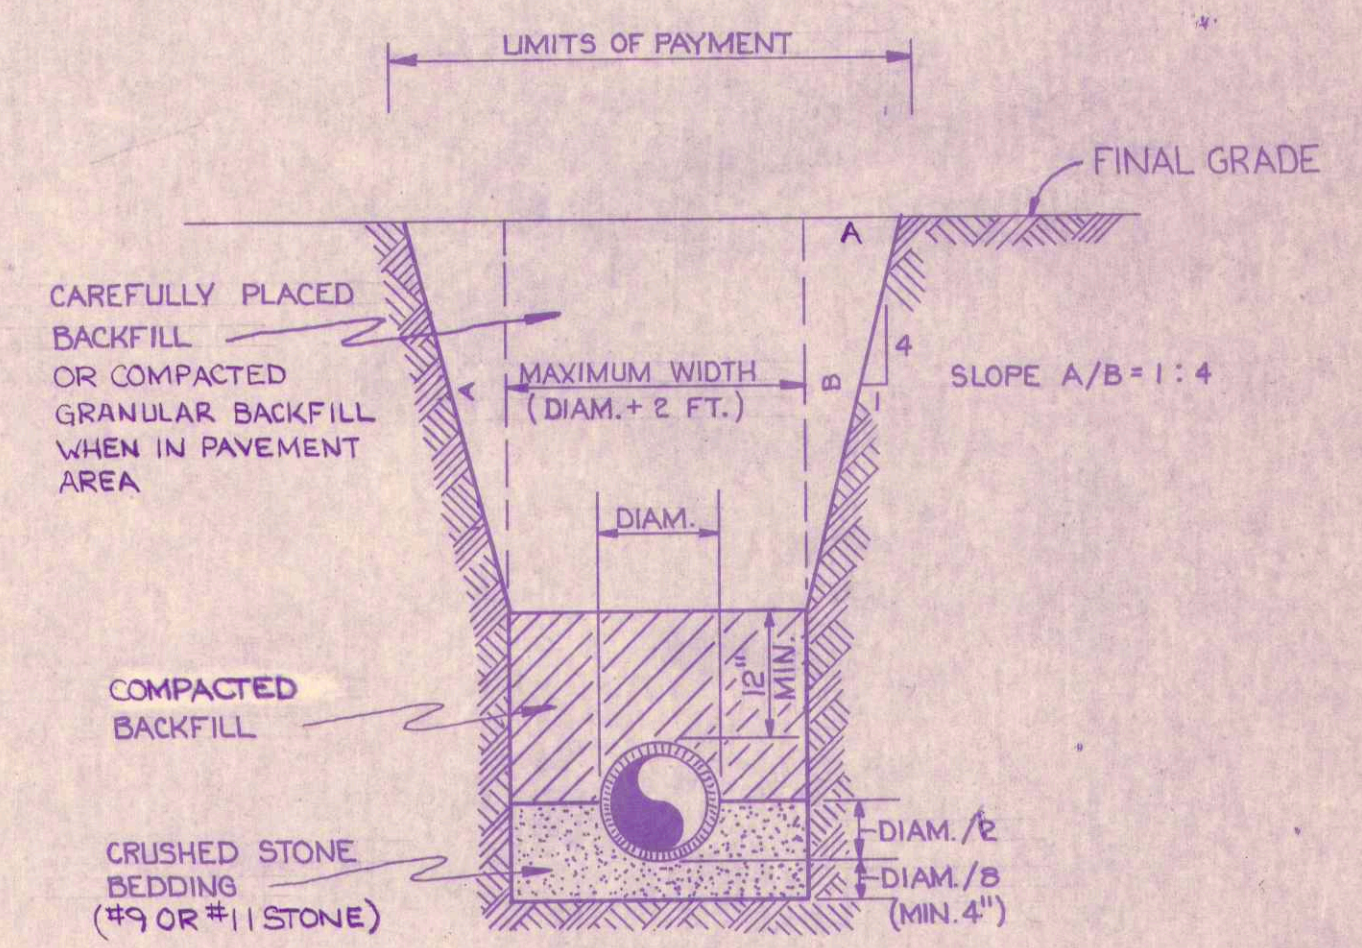

RECORD DRAWING



MISCELLANEOUS DETAILS		
JOB NO. 825	FALL CREEK WASTEWATER FACILITIES	SHEET NO. 81
DATE 3-30-83	BEAM, LONGEST & NEFF, INC. CONSULTING ENGINEERS	
DR BY: JCB	8136 CASTLETON ROAD INDIANAPOLIS, INDIANA	
CERTIFIED BY: E.R.		