




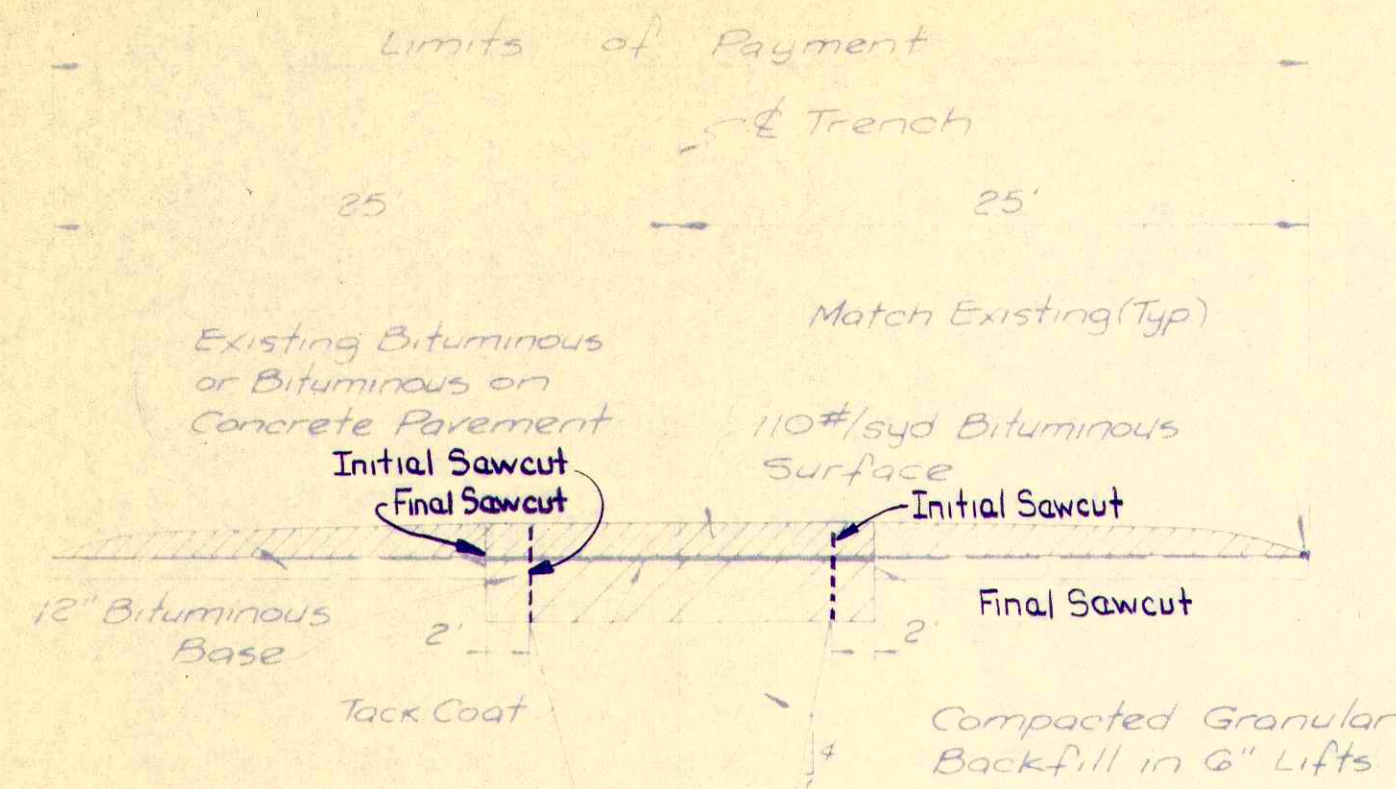


**HIGHWAY REPAIR FOR BITUMINOUS PAVEMENT or BITUMINOUS ON CONCRETE PAVEMENT**  
(No Scale)

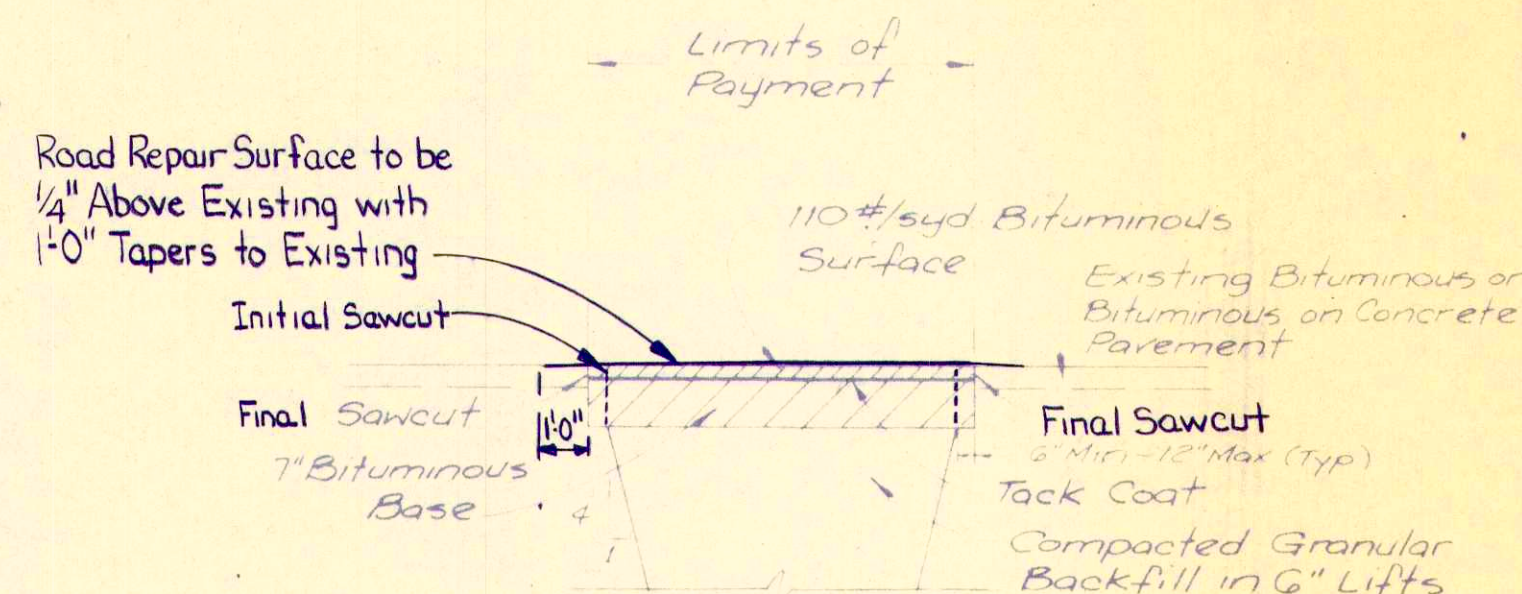


**COUNTY ROAD REPAIR FOR BITUMINOUS PAVEMENT**  
(No Scale)

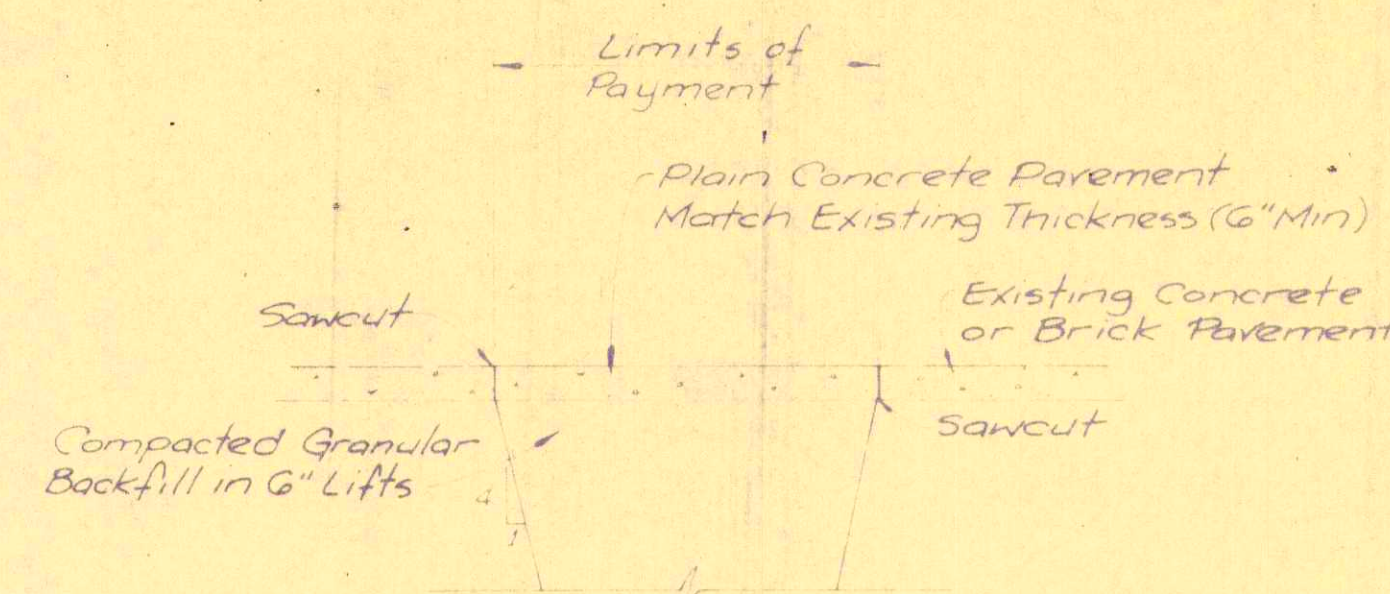


**PAVEMENT REPAIR DETAIL \***  
(No Scale)  
\* For County Road, Street & Residential Driveway Repair (Within Highway R/W) - Concrete or Brick Pavement

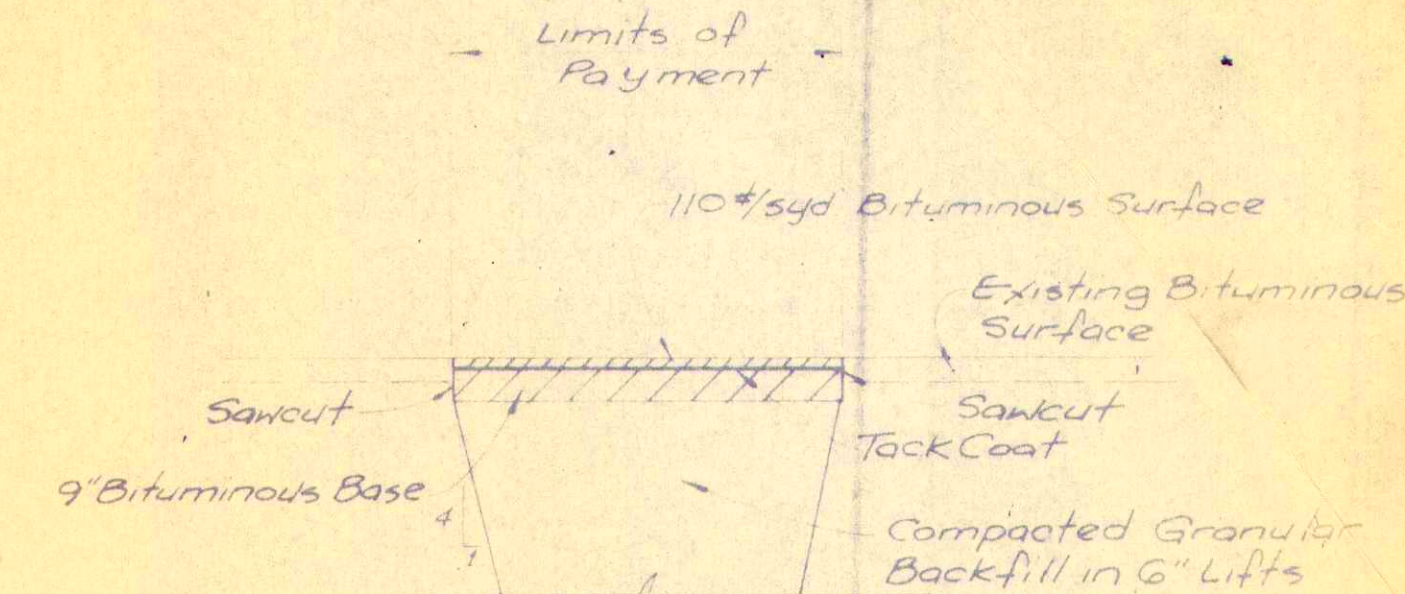


**BITUMINOUS COMMERCIAL DRIVEWAY REPAIR, WITHIN HIGHWAY R/W**  
(No Scale)

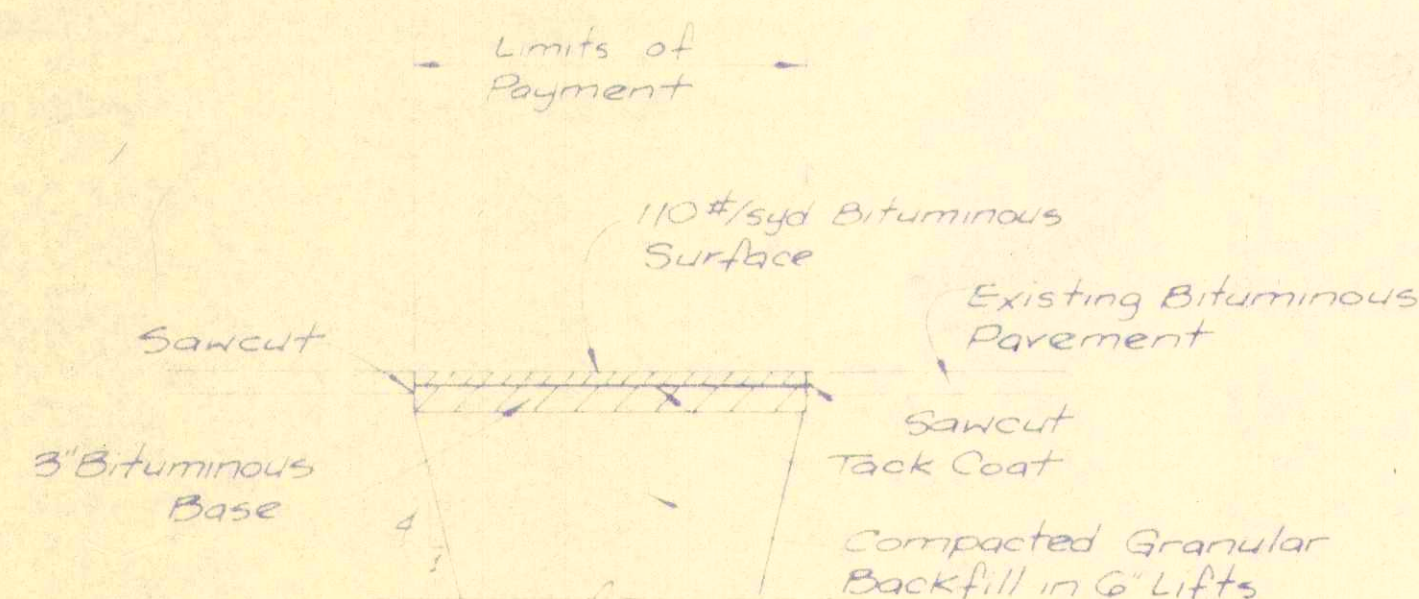


**BITUMINOUS RESIDENTIAL DRIVEWAY REPAIR \***  
(No Scale)  
\* For Driveways in Street, County & Highway R/W

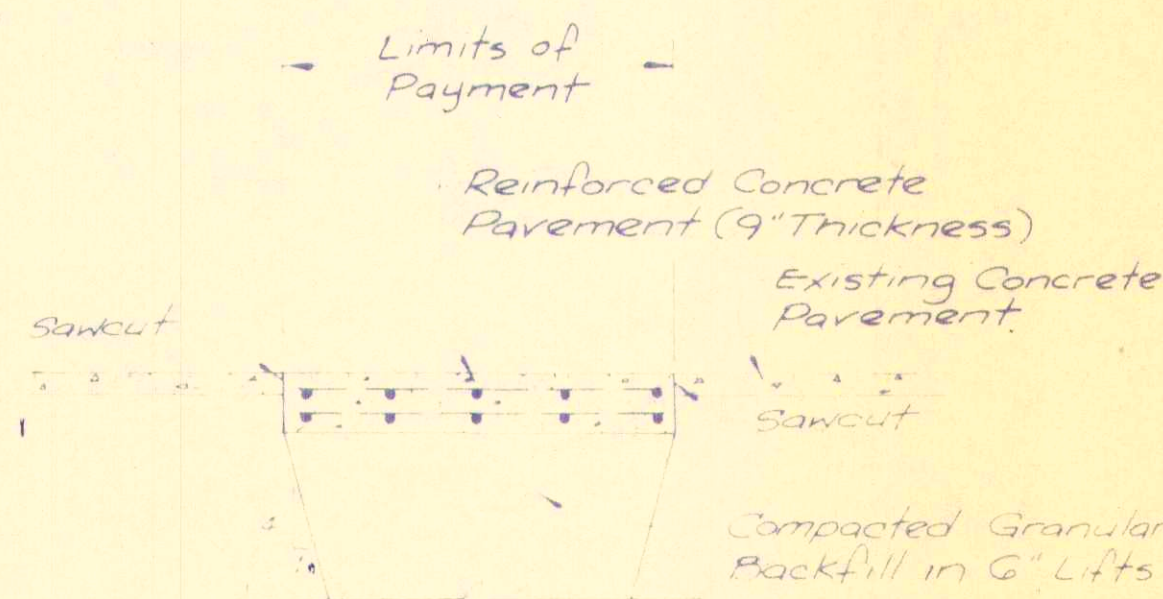


**CONCRETE COMMERCIAL DRIVEWAY REPAIR, WITHIN HIGHWAY OR COUNTY R/W**  
(No Scale)

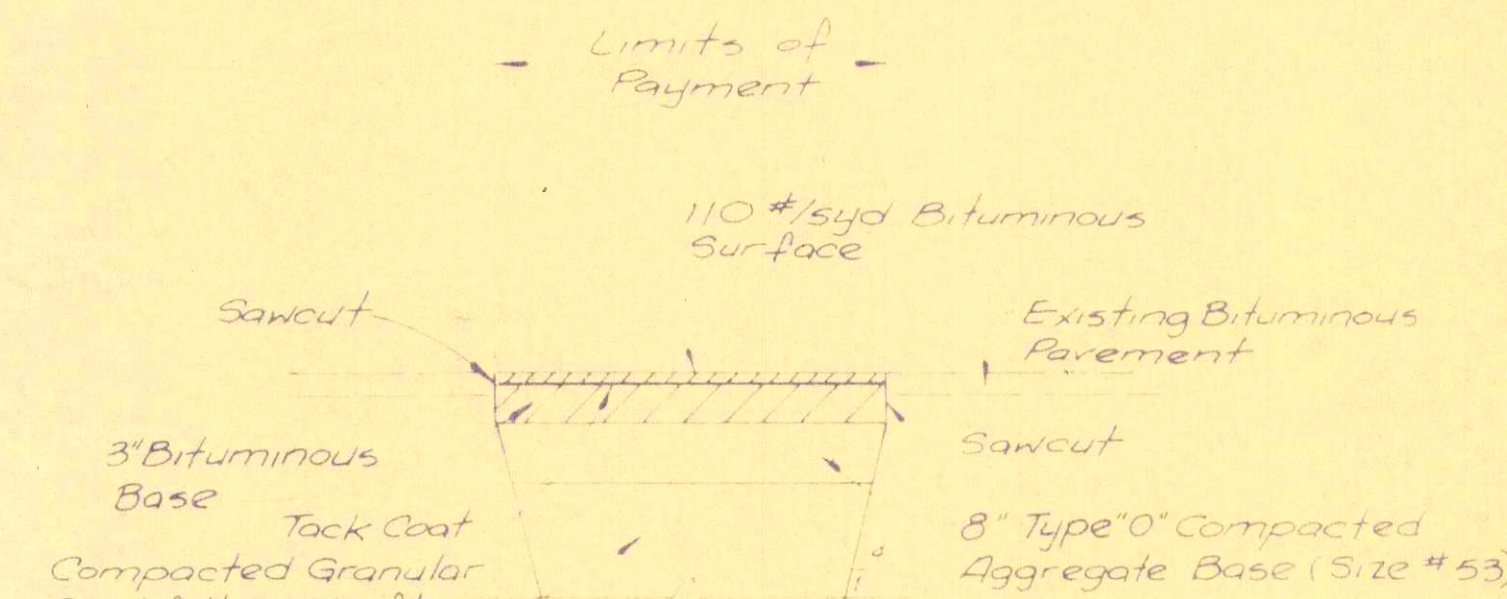


**STREET REPAIR FOR BITUMINOUS PAVEMENT**  
(No Scale)

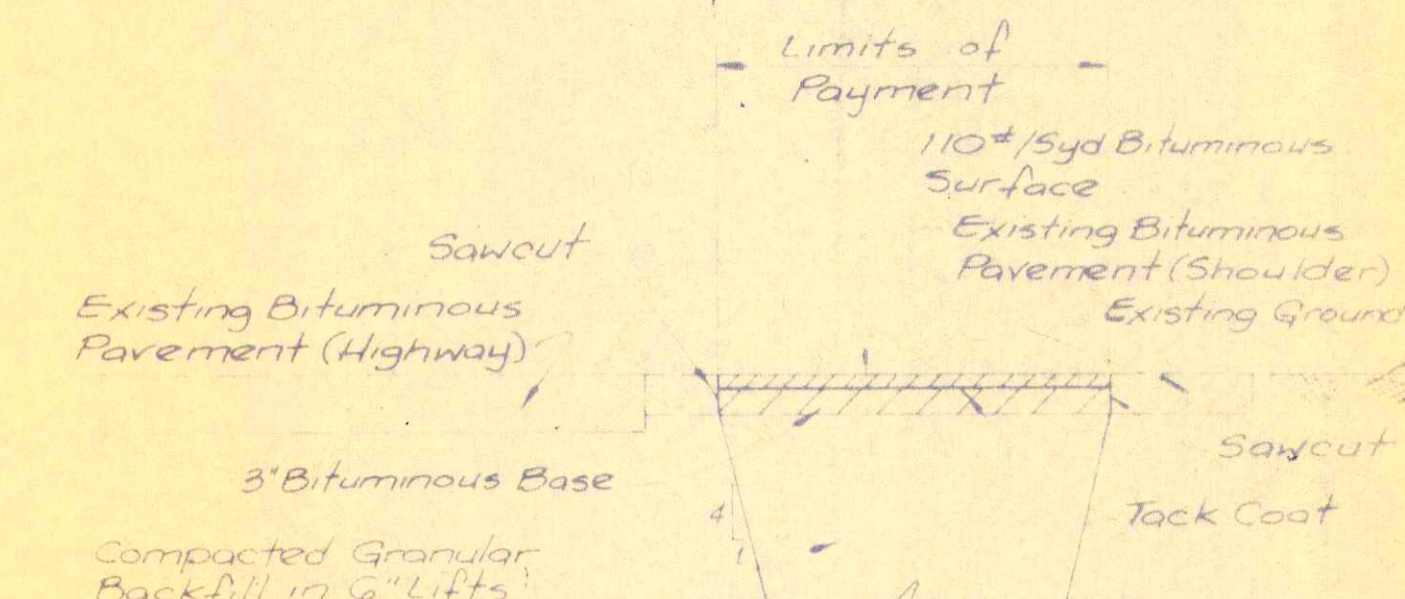


**SHOULDER REPAIR ALONG HIGHWAYS**  
(No Scale)

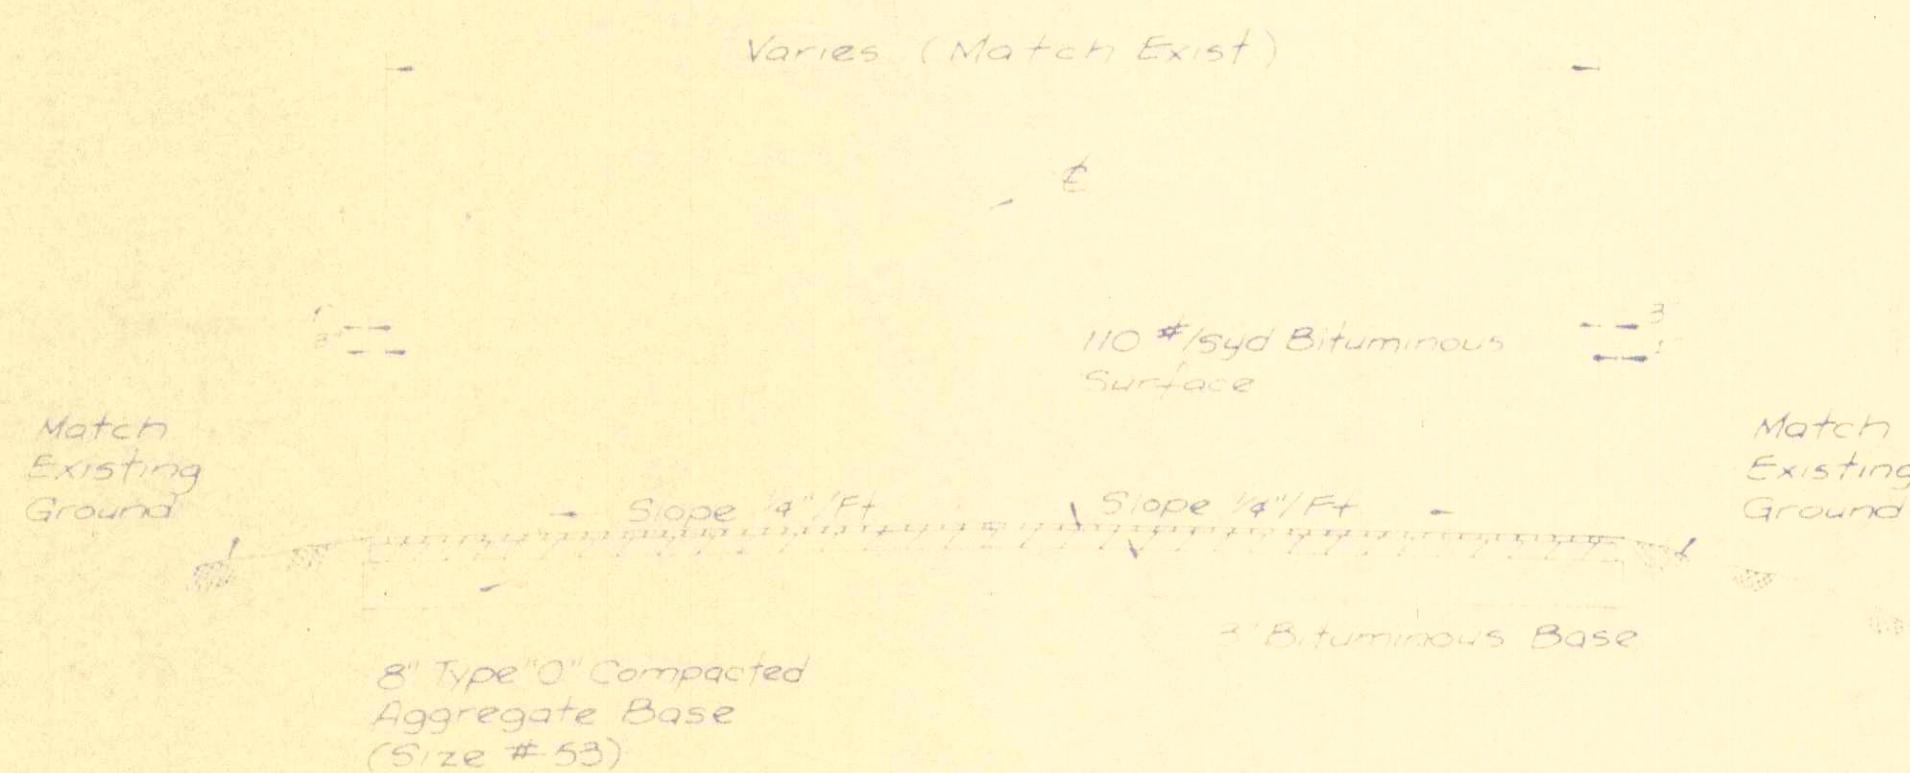

**TYPICAL SECTION FOR ROADWAY REPLACEMENT BITUMINOUS PAVEMENT**  
(No Scale)

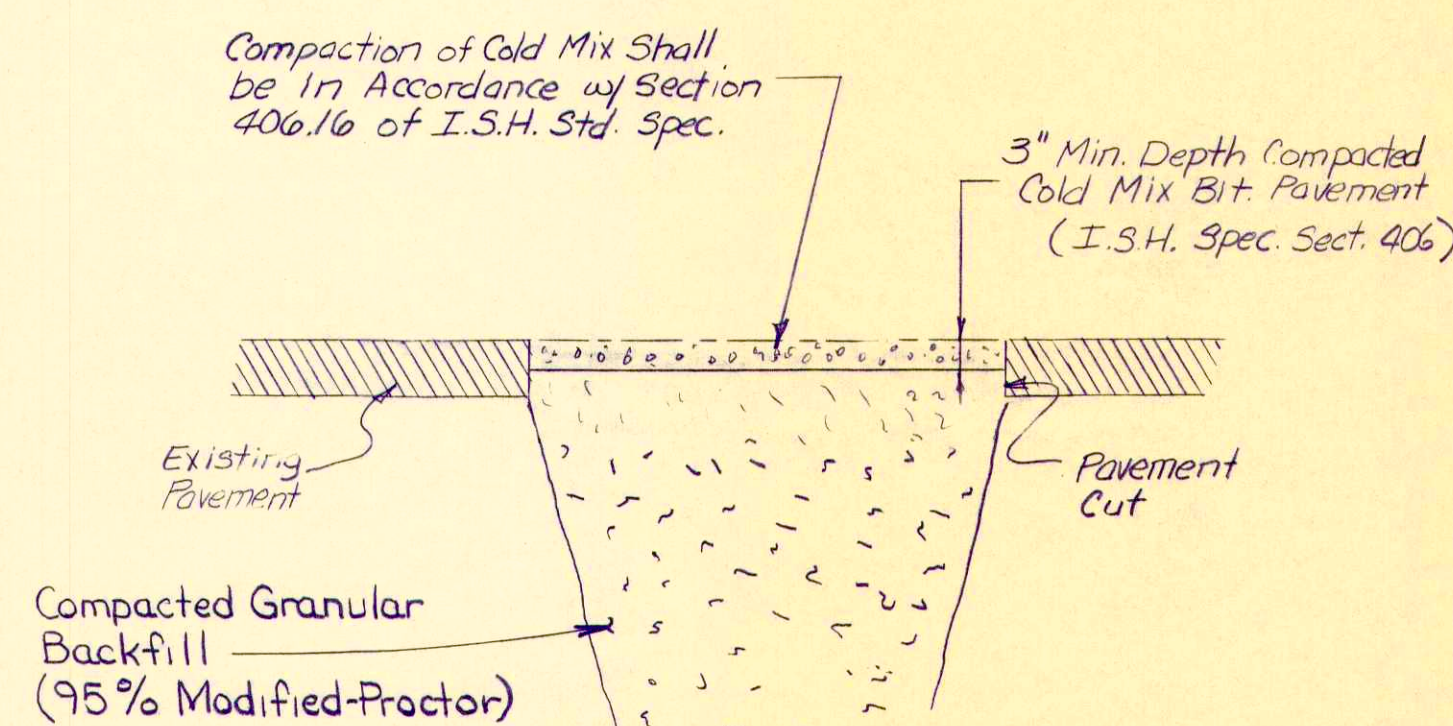

**TEMPORARY ROAD REPAIR**  
For All Pavement During Sewer Main Installation

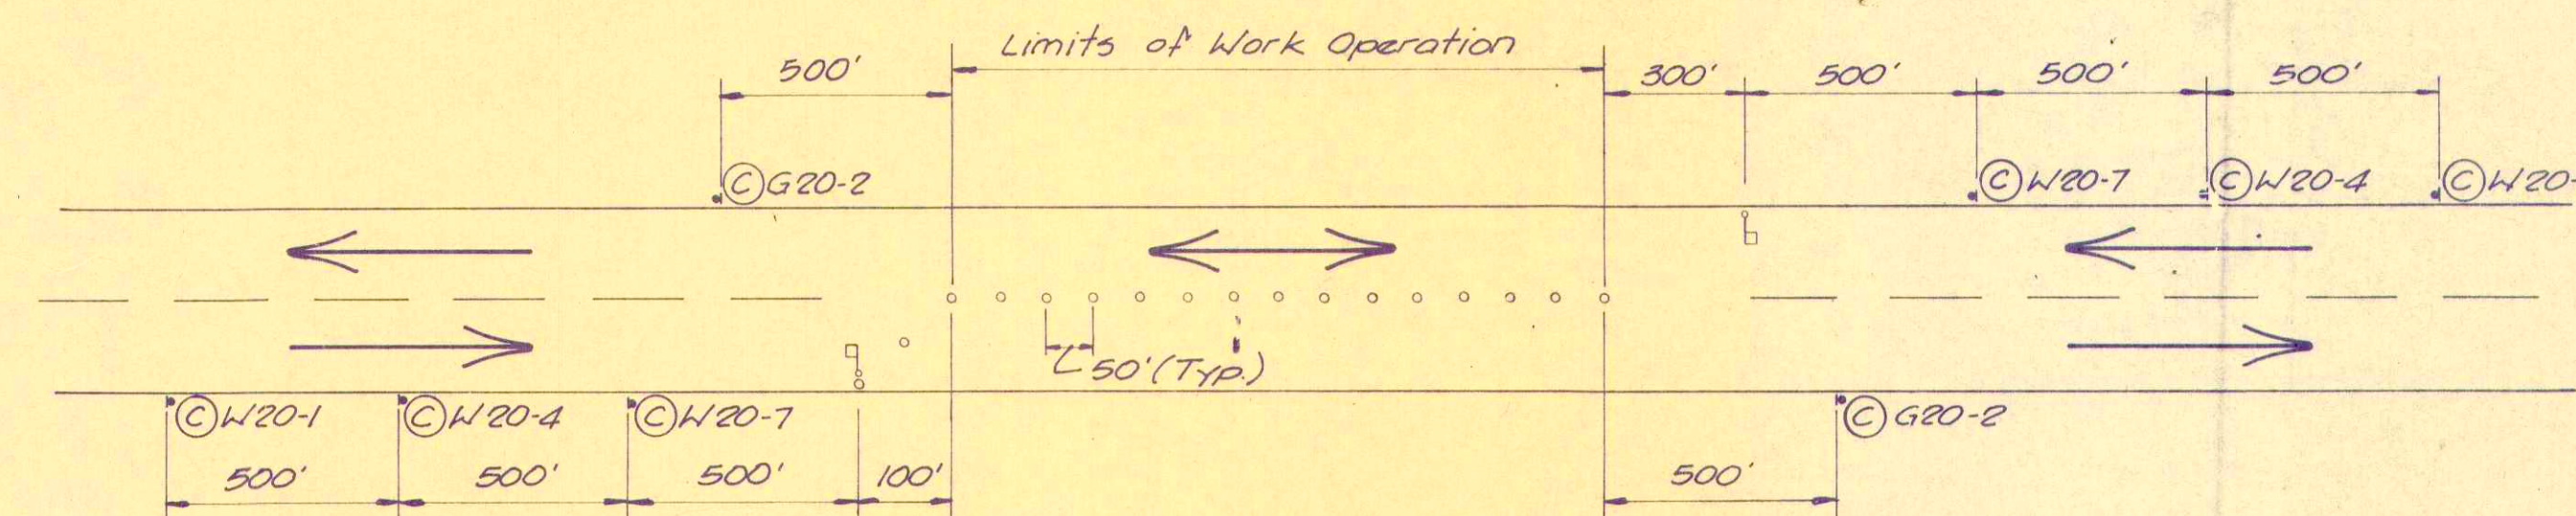

**TYPICAL WORK SECTION**  
(No Scale)

#### LEGEND

- ② Construction Sign, Type A
- G20-2 End Construction
- W20-1 Road Construction Ahead
- W20-4 One Lane Road Ahead
- W20-7 Flagman Ahead
- Flagman
- Cones, Drums, or Barricades, Type I or II

#### GENERAL NOTES

1. MAINTENANCE OF TRAFFIC SHALL BE IN ACCORDANCE WITH SECTION 104.04 OF THE INDIANA STATE HIGHWAY STANDARD SPECIFICATIONS, DATED 1978, THE INDIANA MANUAL ON UNIFORM TRAFFIC CONTROL DEVICES, DATED 1975 AND THE MAINTAINING TRAFFIC SEQUENCE FOR INDIVIDUAL SEGMENTS AS DETAILED.
2. CONTRACTOR SHALL BE REQUIRED TO ERCT AND MAINTAIN ALL CONSTRUCTION SIGNS AS SHOWN.
3. THE MAINTENANCE OF TRAFFIC LISTED HERE IS ONLY A RECOMMENDATION AND SHOULD THE CONTRACTOR DESIRE TO ADOPT ANOTHER METHOD OF MAINTAINING TRAFFIC DURING CONSTRUCTION, IT SHALL BE SUBMITTED TO THE ENGINEER FOR REVIEW AND APPROVAL IN ADVANCE OF THE COMMENCEMENT OF WORK IN THE AFFECTED AREA.
4. LENGTH OF WORK OPERATION SHALL BE LIMITED AS SET OUT IN SECTION 9, GENERAL CONSTRUCTION SPECIFICATIONS.
5. MAINTENANCE OF TRAFFIC AS SHOWN IN THE DETAIL ABOVE SHALL BE REQUIRED ONLY WHEN CONSTRUCTION IS WITHIN 12 FEET OF EDGE OF PAVEMENT.

## MAINTENANCE OF TRAFFIC

|                 |  |                                                                       |  |           |
|-----------------|--|-----------------------------------------------------------------------|--|-----------|
|                 |  | <b>PAVEMENT REPAIR DETAILS</b>                                        |  | Sheet     |
| Scale None      |  | <b>FALL CREEK WASTEWATER FACILITIES</b>                               |  | <b>83</b> |
| Drawn By VMS    |  | BEAM, LONGEST & NEFF                                                  |  |           |
| Designed By GDL |  | Consulting Engineers<br>8136 Castleton Road<br>Indianapolis, IN 46250 |  |           |
| Certified By ER |  |                                                                       |  |           |