


--	--	--	--



SPRINGBROOK SECTION 1A

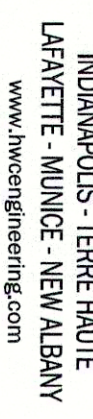