

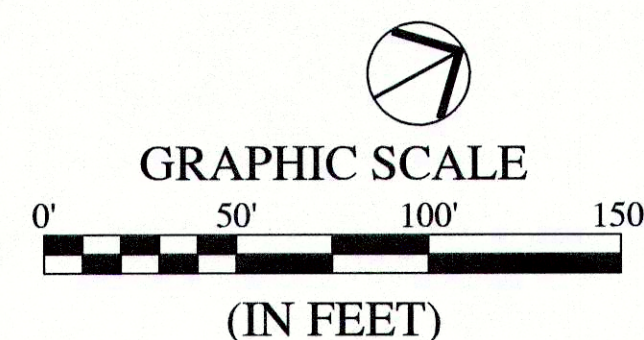
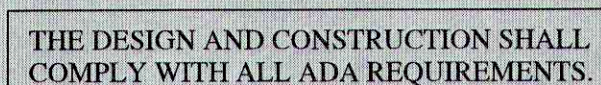


Feb 06, 2019

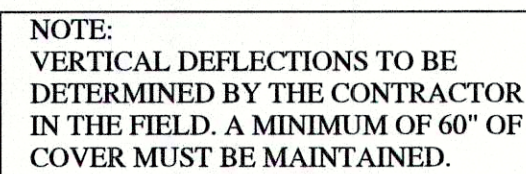

TBM #5
BENCH SPIKE 1' UP ON NORTH SIDE OF NINESTAR POLE #12660
ELEV = 862.05 (NAVD 88)

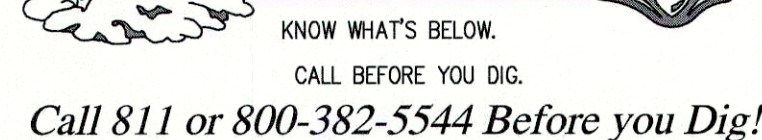

 GRANULAR BACKFILL
 - - - - - EXISTING GRADE
 _____ PROPOSED GRADE



HWC
ENGINEERING

INDIANAPOLIS - TERRE HAUTE
LAFAYETTE - MUNCIE - NEW ALBANY
www.hwcengineering.com

SPRINGBROOK
SECTION 1A
SANITARY SEWER FORCEMAIN
PLAN & PROFILE



DRAWN BY TD,TS	JOB NUMBER 2017-271-A
CHECKED BY SD	
DATE NOVEMBER 8, 2018	
SCALE AS SHOWN	

C5.0

SANITARY SEWER
FORCEMAIN PLAN
& PROFILE