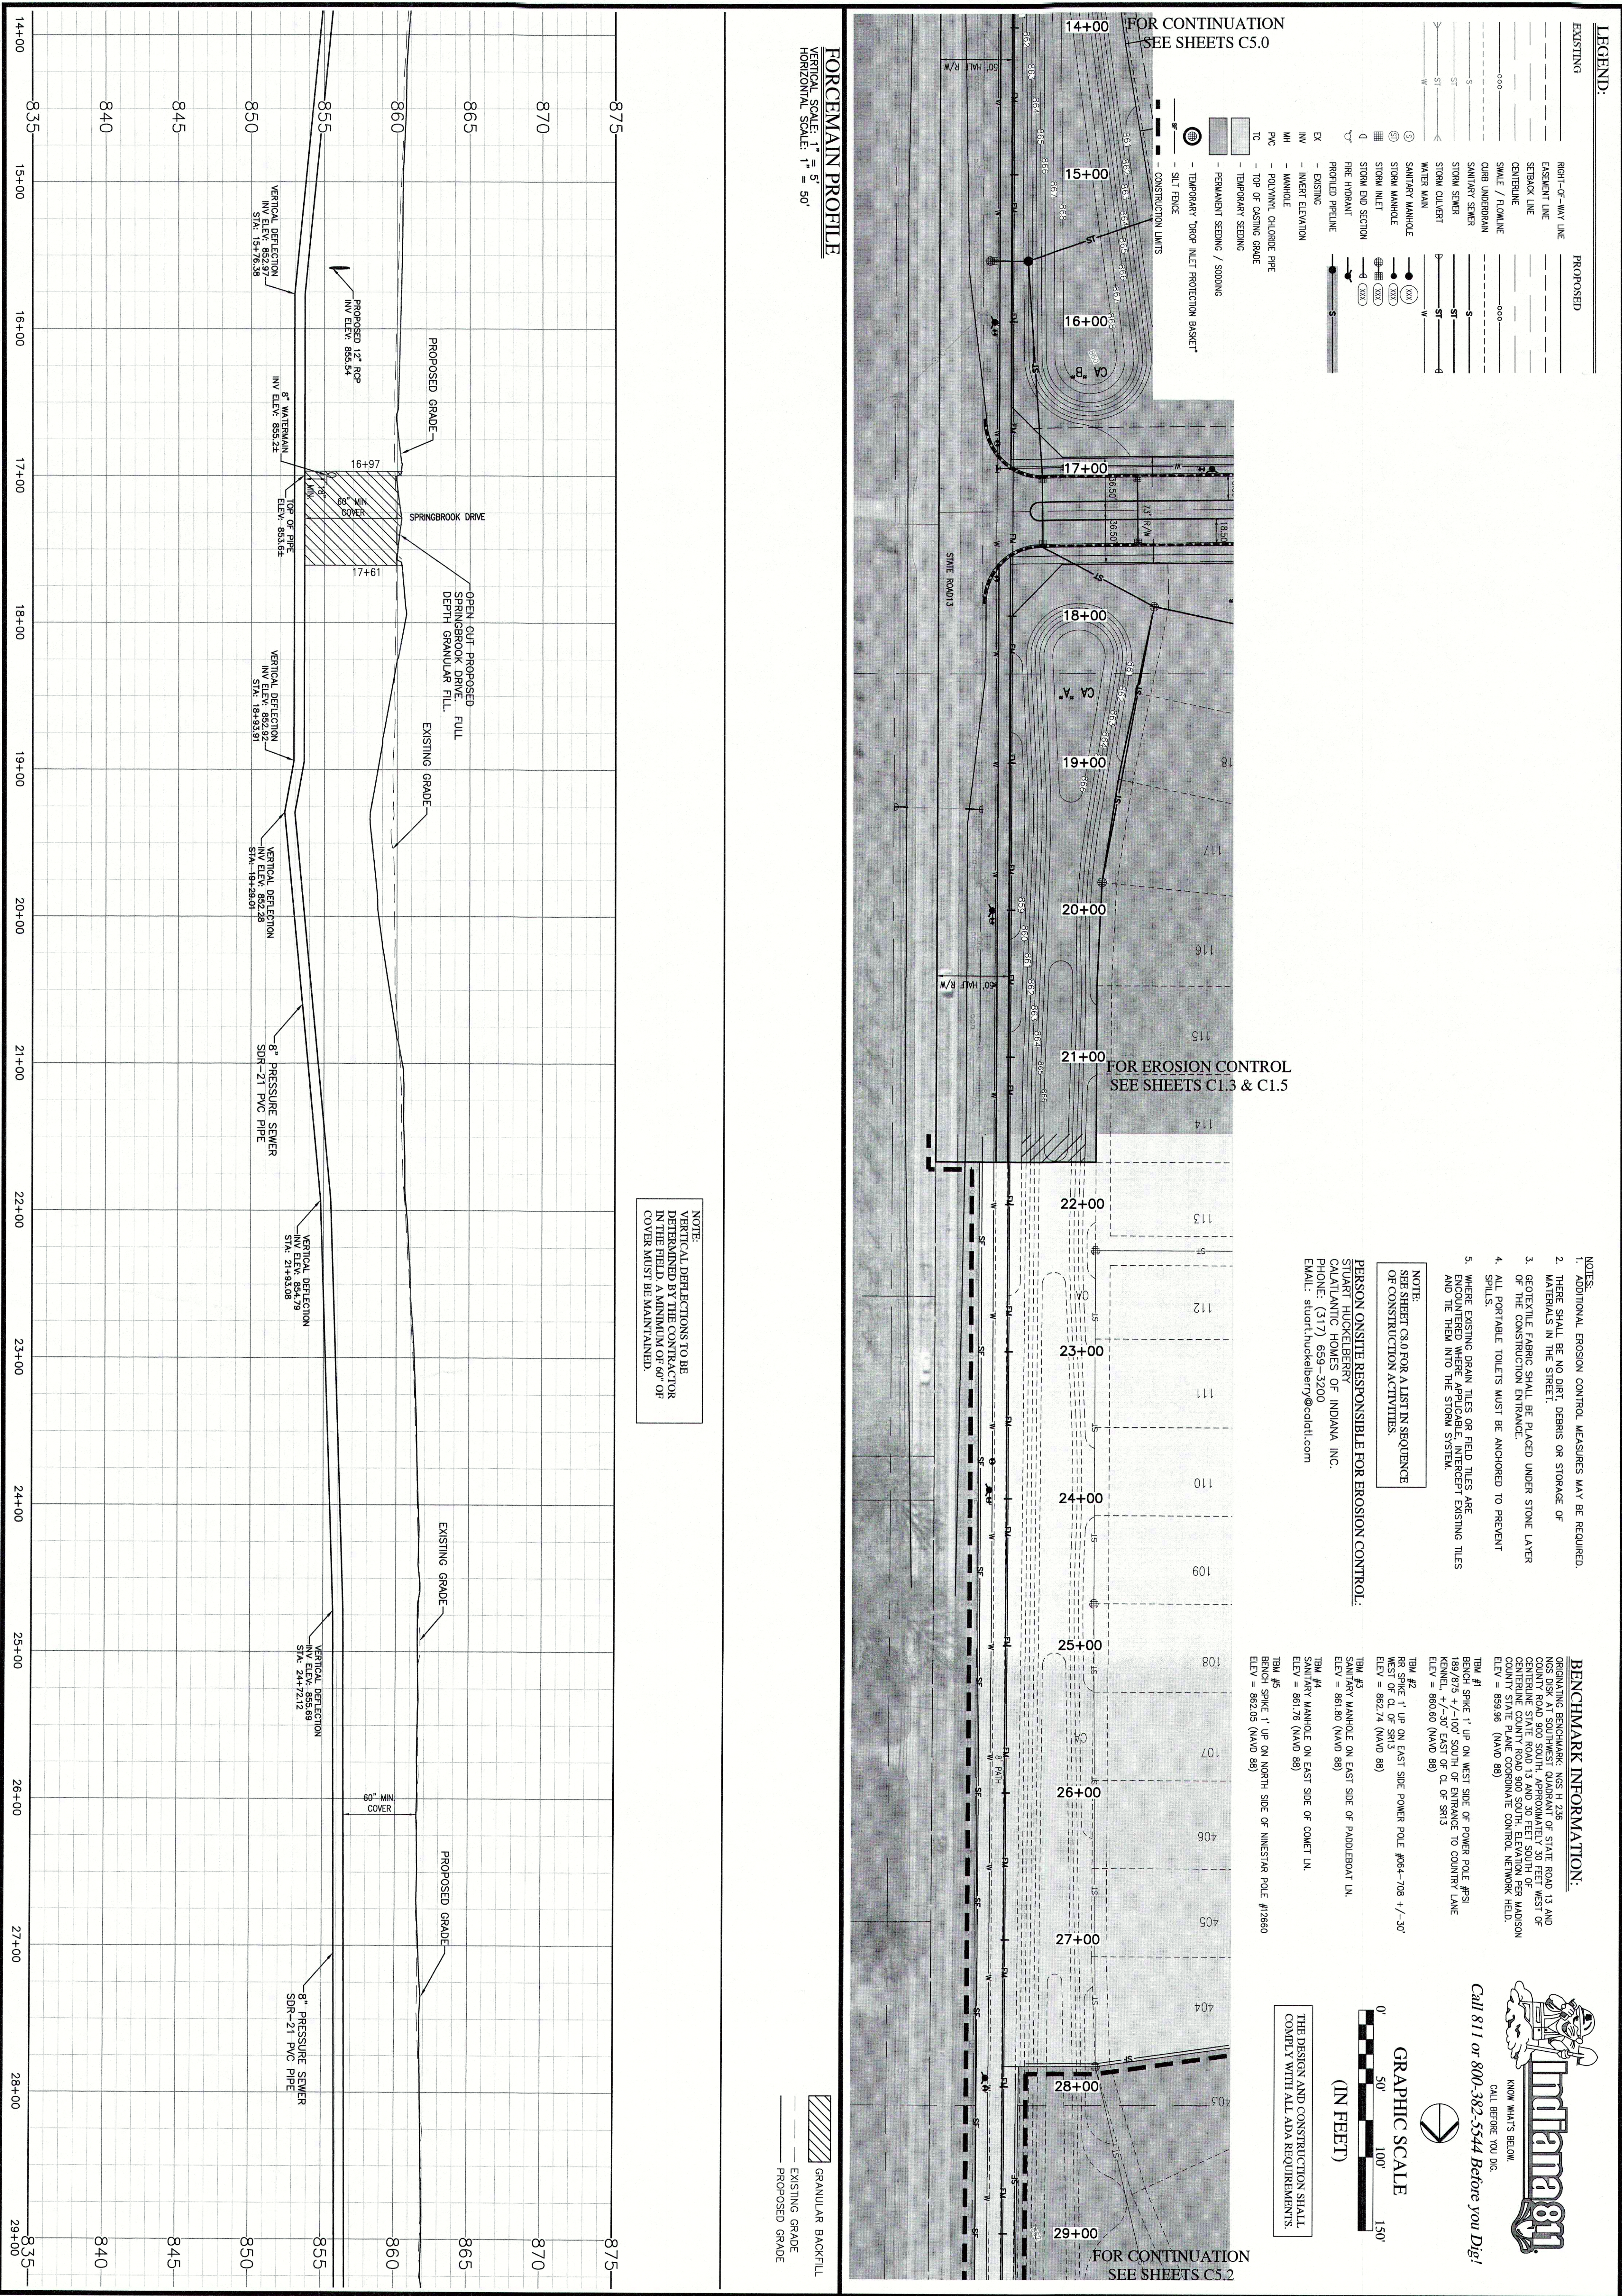


[illegible]

HWC
ENGINEERING

INDIANAPOLIS - TERRE HAUTE
LAFAYETTE - MUNDOE - NEW ALBANY
www.hwcengineering.com

SPRINGBROOK
SECTION 1A

SANITARY SEWER FORCEMAIN
PLAN & PROFILE

SANITARY SEWER FORDMAN PLAN & PROFILE	DRAWN BY T.O.S.		
	CHECKED BY S.D.	DATE NOVEMBER 8, 2018	
	SCALE AS SHOWN	JOB NUMBER 2017-271-A	
	SHEET		