

GENERAL ELECTRICAL NOTES:

- A. CONTRACTOR SHALL COORDINATE ALL REQUIREMENTS FOR NEW SERVICE WITH LOCAL UTILITY. ~~UTILITY FILES TO BE INCLUDED BY CONTRACTOR~~  
~~Home More Oliver, Email: marc@oliver-energy.com~~
- B. SEE ONE LINE DIAGRAM FOR ADDITIONAL DETAILS AND REQUIREMENTS.
- C. PROVIDE STAINLESS STEEL HARDWARE FOR ALL EQUIPMENT INSTALLED IN WET WELL. THIS INCLUDES BUT NOT LIMITED TO KELLEYS CABLE GRIPS, CABLE RACKS, MOUNTING BRACKETS, BOLTS AND NUTS.
- D. WITHIN A 5' RADIUS OF ANY VENTED OPENING ATTACHED TO THE WET WELL SHALL BE CLASS 1 DIVISION 2 GROUP D RATED.
- E. THE WET WELL CLASSIFICATION IS CLASS 1 DIVISION 1 GROUP D ENVIRONMENTAL PER NFPA 820. ALL EQUIPMENT SHALL MEET NEC REQUIREMENTS FOR THIS ENVIRONMENT.
- F. LOCATE ALL EXISTING PIPING AND UTILITIES BEFORE INSTALLING UNDERGROUND CONDUITS. PROTECT ALL EXISTING INSTALLATIONS.
- G. ALL BELOW GRADE CONDUIT SHALL BE SCH. 80 PVC. ALL TRANSITIONS (90 DEGREE ELBOW) FROM BELOW GRADE TO ABOVE GRADE SHALL BE GALVANIZED RIGID STEEL. ALL ABOVE GRADE CONDUIT SHALL BE GALVANIZED RIGID STEEL. ALL CONDUITS SHALL BE ALUMINUM CONDUITS WHERE IN CONTACT WITH EARTH OR CONCRETE WITH OXIDATION RESISTANT COATING. ALL CONDUITS FROM VENTED TERMINAL BOXES INTO WET WELL SHALL BE GALVANIZED RIGID STEEL.
- H. MAINTAIN 3" SEPARATION BETWEEN 480V POWER CONDUITS AND LOW VOLTAGE (NETWORK, 24V DC CONTROL, OR INTRINSICALLY SAFE CIRCUIT) CONDUITS. MAINTAIN 1" SEPARATION BETWEEN 120V POWER CONDUITS AND LOW VOLTAGE (NETWORK, 24V DC CONTROL, OR INTRINSICALLY SAFE CIRCUIT) CONDUITS.
- I. WHERE CONDUIT CROSSES UNDER EXISTING OR FUTURE PAVEMENT, CONDUIT SHALL BE GALVANIZED RIGID STEEL. SAW CUT AND REPAIR EXISTING PAVEMENT AS NECESSARY.
- J. WIRE AND CONDUIT ROUTES AND ELECTRICAL EQUIPMENT LOCATIONS ARE APPROXIMATE. FIELD VERIFY EXACT INSTALLATIONS.
- K. ALL WIRING, CONDUIT, AND TERMINATIONS FURNISHED AND INSTALLED BY CONTRACTOR.
- L. CONTRACTOR SHALL COORDINATE NEW SERVICE AND TRANSFORMER WITH UTILITY.
- M. MAINTAIN 5' MINIMUM SEPARATION BETWEEN VENTED TERMINAL BOXES AND OTHER ELECTRICAL EQUIPMENT.
- N. EXISTING CONDITION INFORMATION PROVIDED ON THIS DRAWING WAS OBTAINED BY SITE VISIT OBSERVATIONS AND FROM ORIGINAL CONSTRUCTION DRAWINGS WHEN AVAILABLE. CONTRACTOR SHALL VERIFY THE SCOPE OF WORK BY SITE INSPECTION PRIOR TO BIDDING. THIS DRAWING SHALL BE CONSIDERED INCOMPLETE AND USED FOR REFERENCE ONLY.

ELECTRICAL KEYED NOTES: ○

1. NEW UNDERGROUND FEEDER FROM NEW UTILITY POLE TO NEW KETEX TO NEW 120/208V 3 PHASE MAIN SERVICE DISCONNECT MOUNTED ON NEW ELECTRICAL EQUIPMENT RACK. SEE ONE-LINE DIAGRAM.
2. NEW 3-PHASE OVERHEAD PRIMARY.
3. NEW RISER POLE AND TRANSFORMER BANK BY UTILITY.
4. NEW 1-PHASE UPGRADED TO 3-PHASE OVERHEAD PRIMARY. SEE SHEET E1 FOR DETAILS.
5. EXISTING UTILITY POLE.
6. EXISTING 1-PHASE PRIMARY.
7. NEW 4" CONCRETE PAD. SEE SHEET CS.12 FOR GENERATOR PAD DETAILS.
8. NEW GENERATOR. SEE SHEET CS.8 FOR ELECTRICAL ONE-LINE DIAGRAM.
9. NEW UTILITY POLE.

PHOTO TAKEN FACING WEST


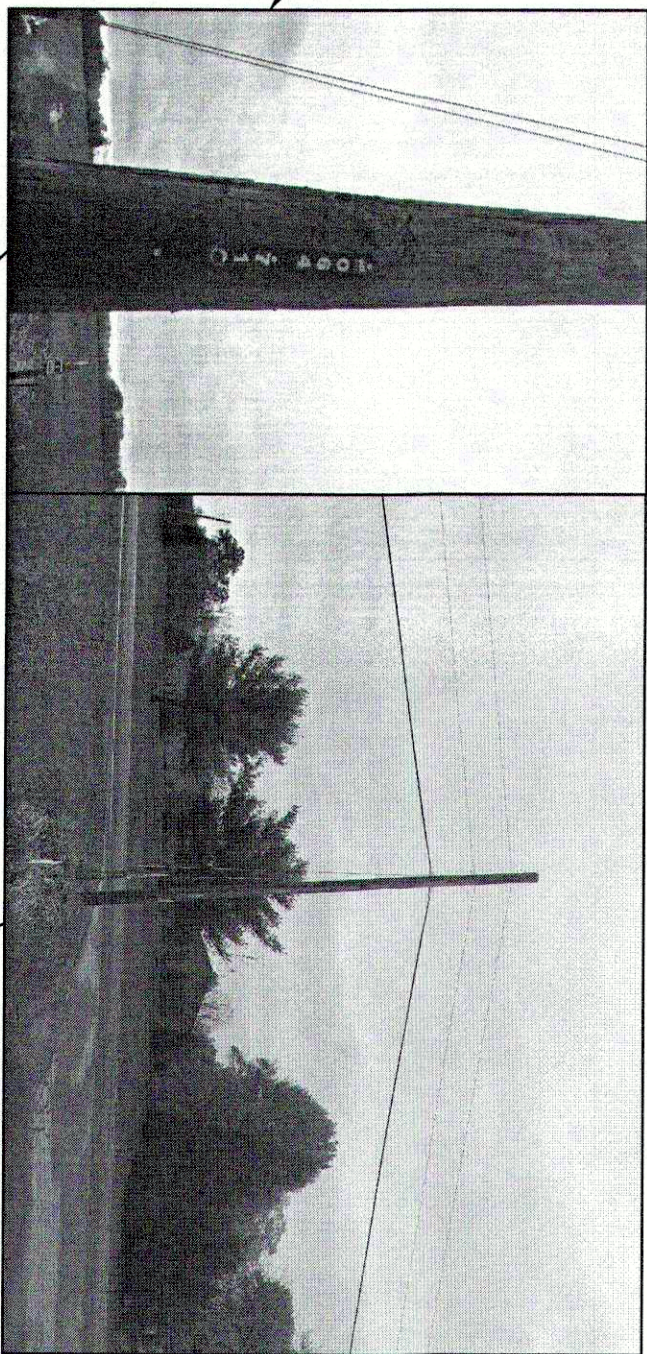


PHOTO TAKEN FACING EAST

EXISTING UTILITY POLE WITH POLE NUMBER

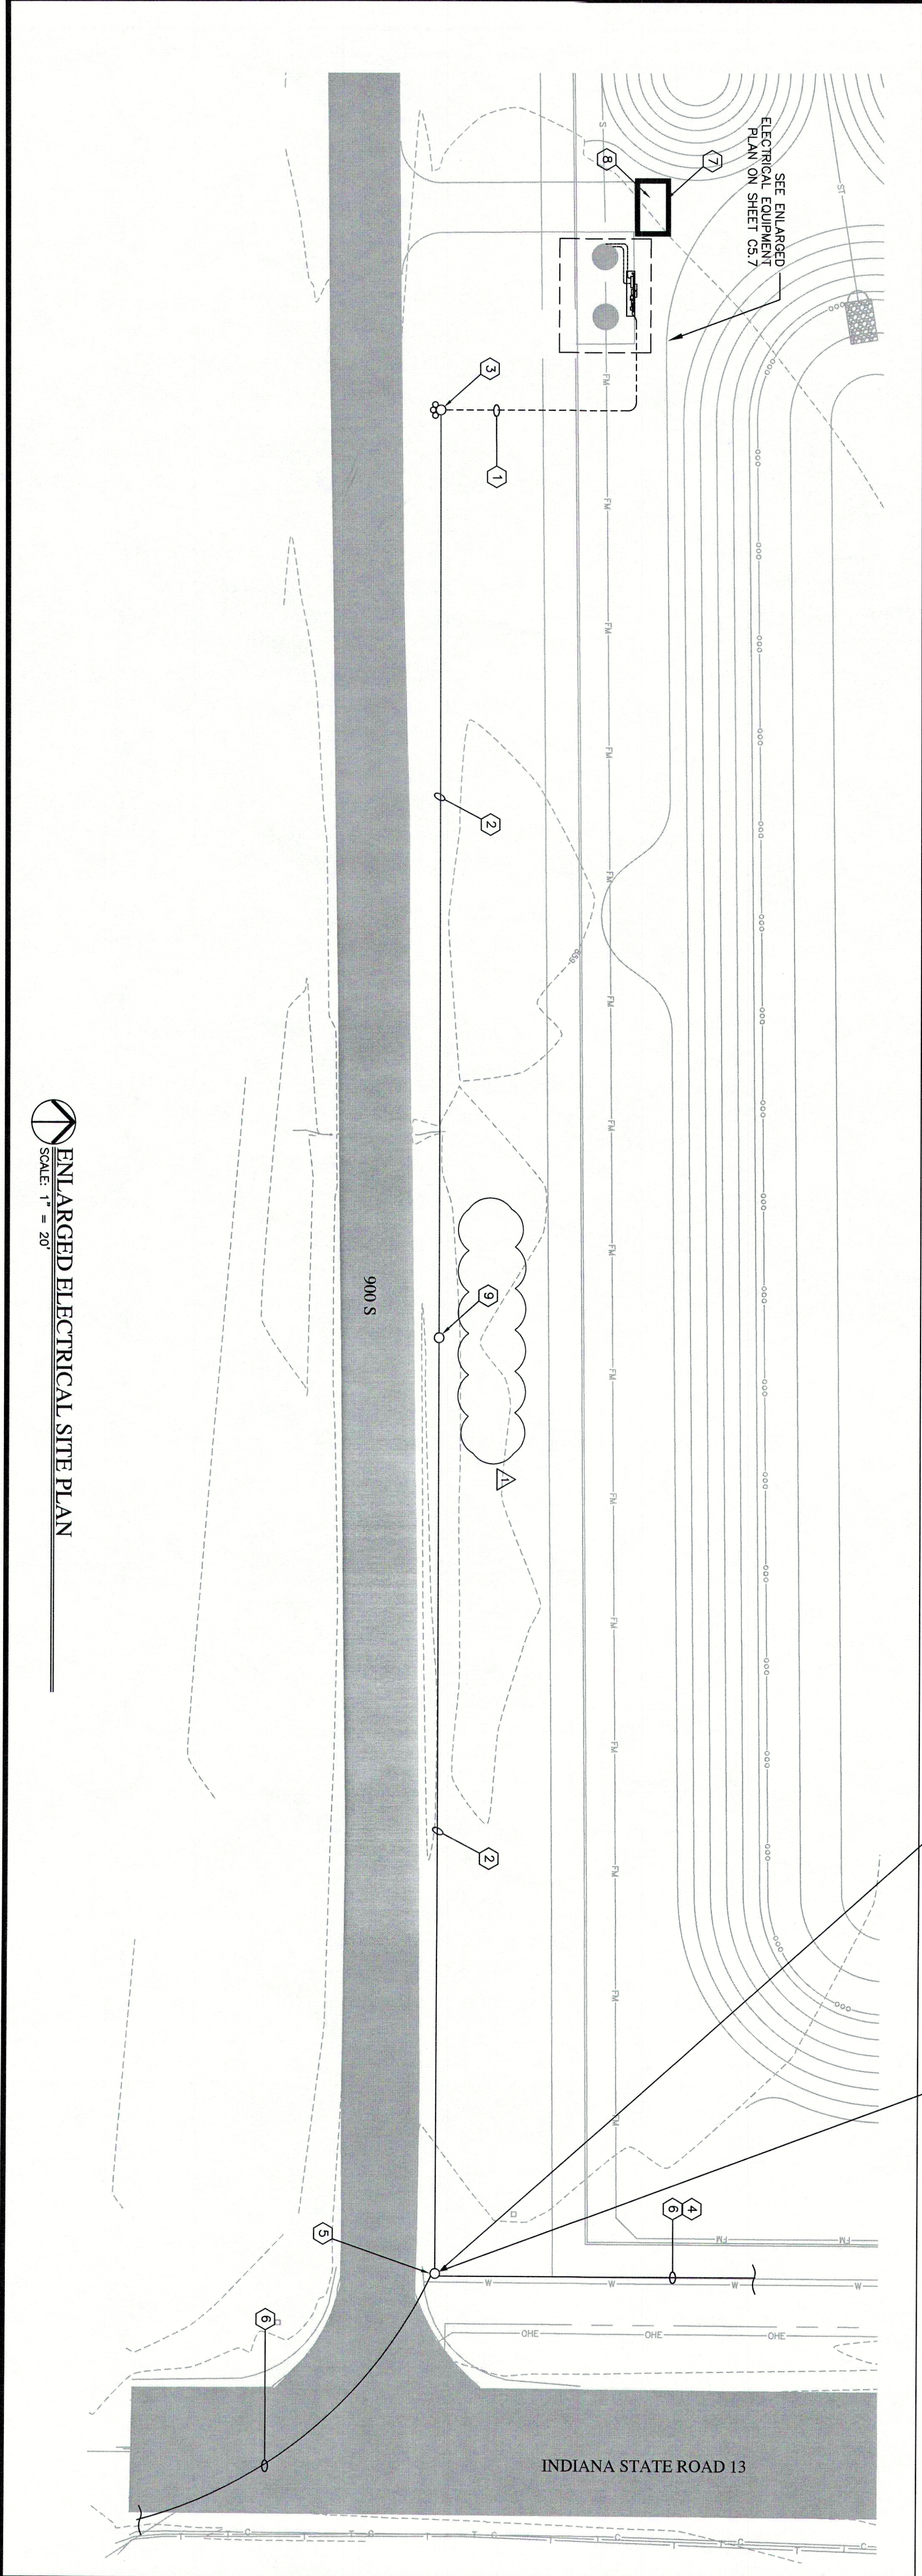

ENLARGED ELECTRICAL SITE PLAN  
SCALE 1" = 20'

REVISIONS


DATE	DESCRIPTION	BY
01/16/19	REV. PER FORM. # 101M COMMENTS	JEF



SIMS-DURKIN ASSOCIATES  
ENGINEERING COMPANY

1405 CO. RD. 100, SUITE 100, MADISON, IN 47050  
PHONE: (317) 266-4455, WEBSITE: WWW.SIMS-DURKIN.COM

SPRINGBROOK PRELIMINARY PLAN  
MADISON COUNTY, INDIANA  
LIFT STATION  
ENLARGED ELECTRICAL SITE PLAN

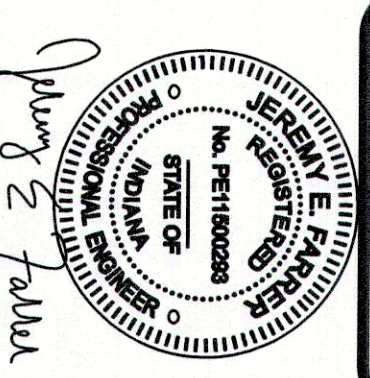

DRAWN BY	IA, SSM
CHECKED BY	JEF
DATE	NOVEMBER 30, 2018
SCALE	AS SHOWN
SHEET	
JOB NUMBER	2017-271

CS.6  
ENLARGED ELECTRICAL  
SITE PLAN