




DRAWING NOT TO SCALE

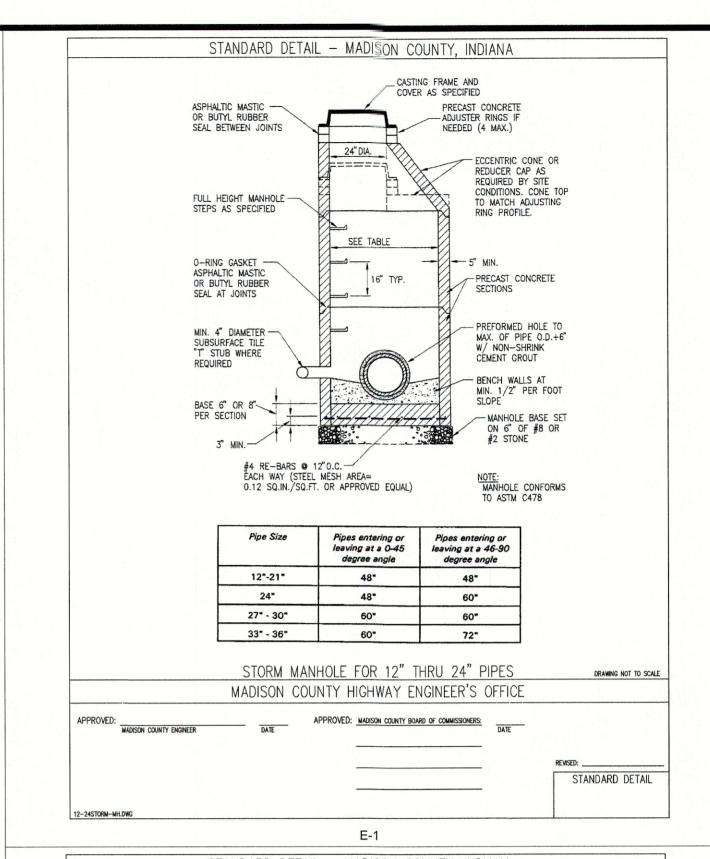

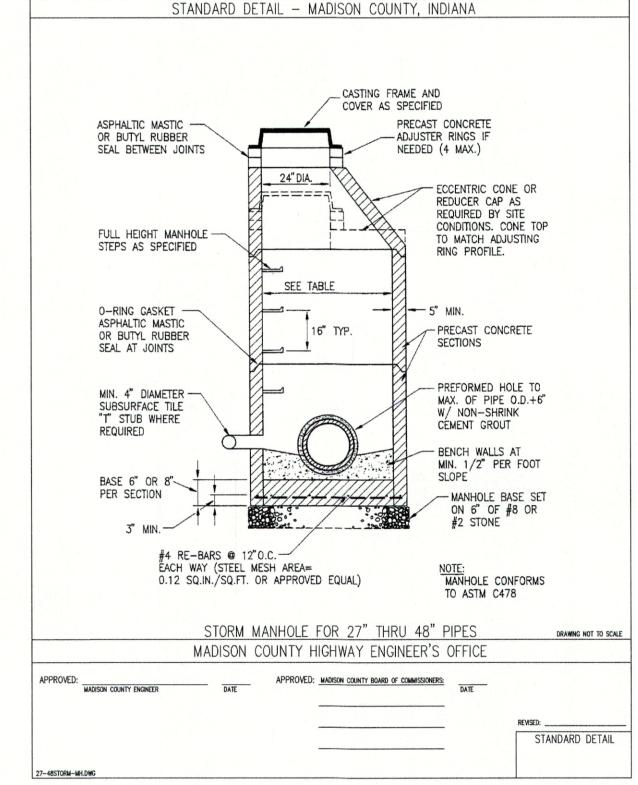

E-2

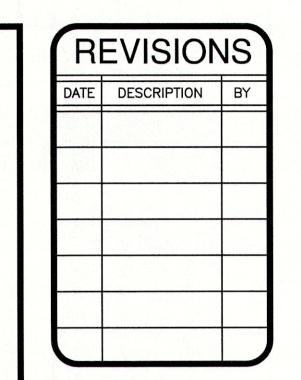



LAFAYETTE - MUNICE - NEW ALBANY www.hwcengineering.com

SPRIN SEC

CHECKED BY MAY 10, 2019 SCALE AS SHOWN

CONSTRUCTION DETAILS