
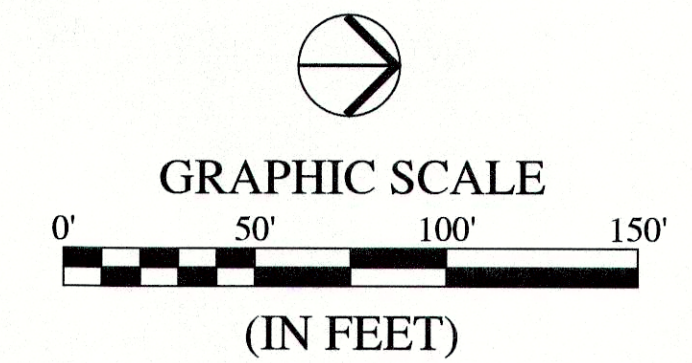
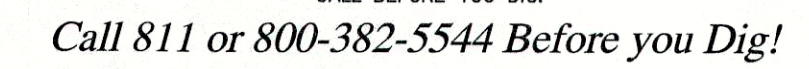


EXISTING		PROPOSED	
	RIGHT-OF-WAY LINE		RIGHT-OF-WAY LINE
	EASEMENT LINE		EASEMENT LINE
	SETBACK LINE		SETBACK LINE
	CENTERLINE		CENTERLINE
	SWALE / FLOWLINE		SWALE / FLOWLINE
	CURB UNDERDRAIN		CURB UNDERDRAIN
	SANITARY SEWER		SANITARY SEWER
	STORM SEWER		STORM SEWER
	STORM CULVERT		STORM CULVERT
	WATER MAIN		WATER MAIN
	SANITARY MANHOLE		SANITARY MANHOLE
	STORM MANHOLE		STORM MANHOLE
	STORM INLET		STORM INLET
	STORM END SECTION		STORM END SECTION
	FIRE HYDRANT		FIRE HYDRANT
	PROFILED PIPELINE		PROFILED PIPELINE
EX	— EXISTING		
INV	— INVERT ELEVATION		
MH	— MANHOLE		
PVC	— POLYVINYL CHLORIDE PIPE		
TC	— TOP OF CASTING GRADE		

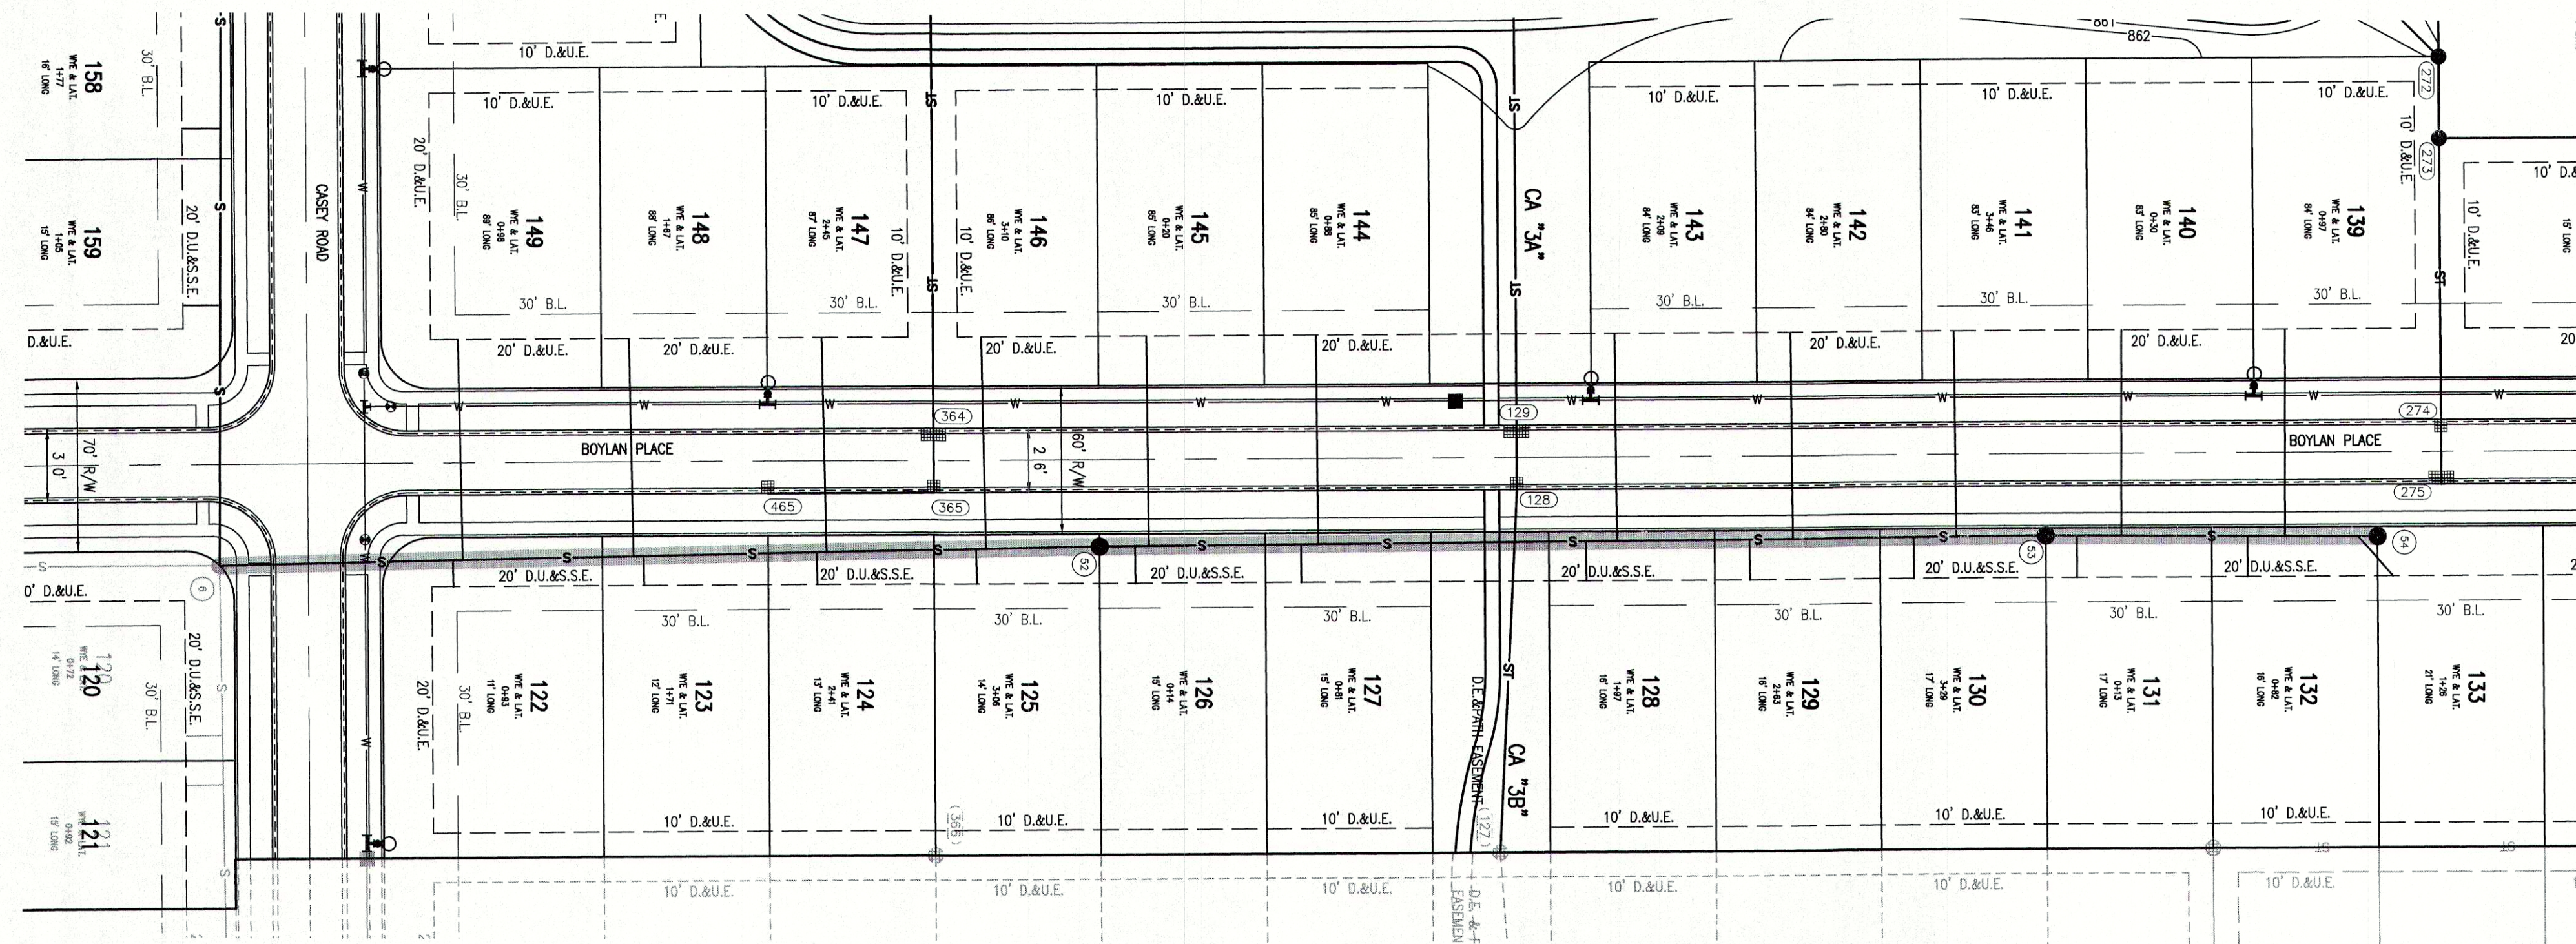

ORIGINATING BENCHMARK: NGS H 236
 NGS DISK AT SOUTHWEST QUADRANT OF STATE ROAD 13 AND
 COUNTY ROAD 900 SOUTH, APPROXIMATELY 30 FEET WEST OF
 CENTERLINE STATE ROAD 13 AND 30 FEET SOUTH OF
 CENTERLINE COUNTY ROAD 900 SOUTH. ELEVATION PER MADISON
 COUNTY STATE PLANE COORDINATE CONTROL NETWORK HELD.
 ELEV = 859.96 (NAVD 88)

TBM #1
BENCH SPIKE 1' UP ON WEST SIDE OF POWER POLE #PSI
189/875 +/-100' SOUTH OF ENTRANCE TO COUNTRY LANE
KENNEL +/-30' EAST OF CL OF SR13
ELEV = 860.60 (NAVD 88)


TBM #2
RR SPIKE 1' UP ON EAST SIDE POWER POLE #064-708 +/-30'
WEST OF CL OF SR13
ELEV = 862.74 (NAVD 88)

TBM #3
SANITARY MANHOLE ON EAST SIDE OF PADDLEBOAT LN.
ELEV = 861.80 (NAVD 88)

TBM #4
SANITARY MANHOLE ON EAST SIDE OF COMET LN.
ELEV = 861.76 (NAVD 88)

TBM #5
BENCH SPIKE 1' UP ON NORTH SIDE OF NINESTAR POLE #12660
ELEV = 862.05 (NAVD 88)

VERTICAL SCALE: 1" = 5'
HORIZONTAL SCALE: 1" = 50'

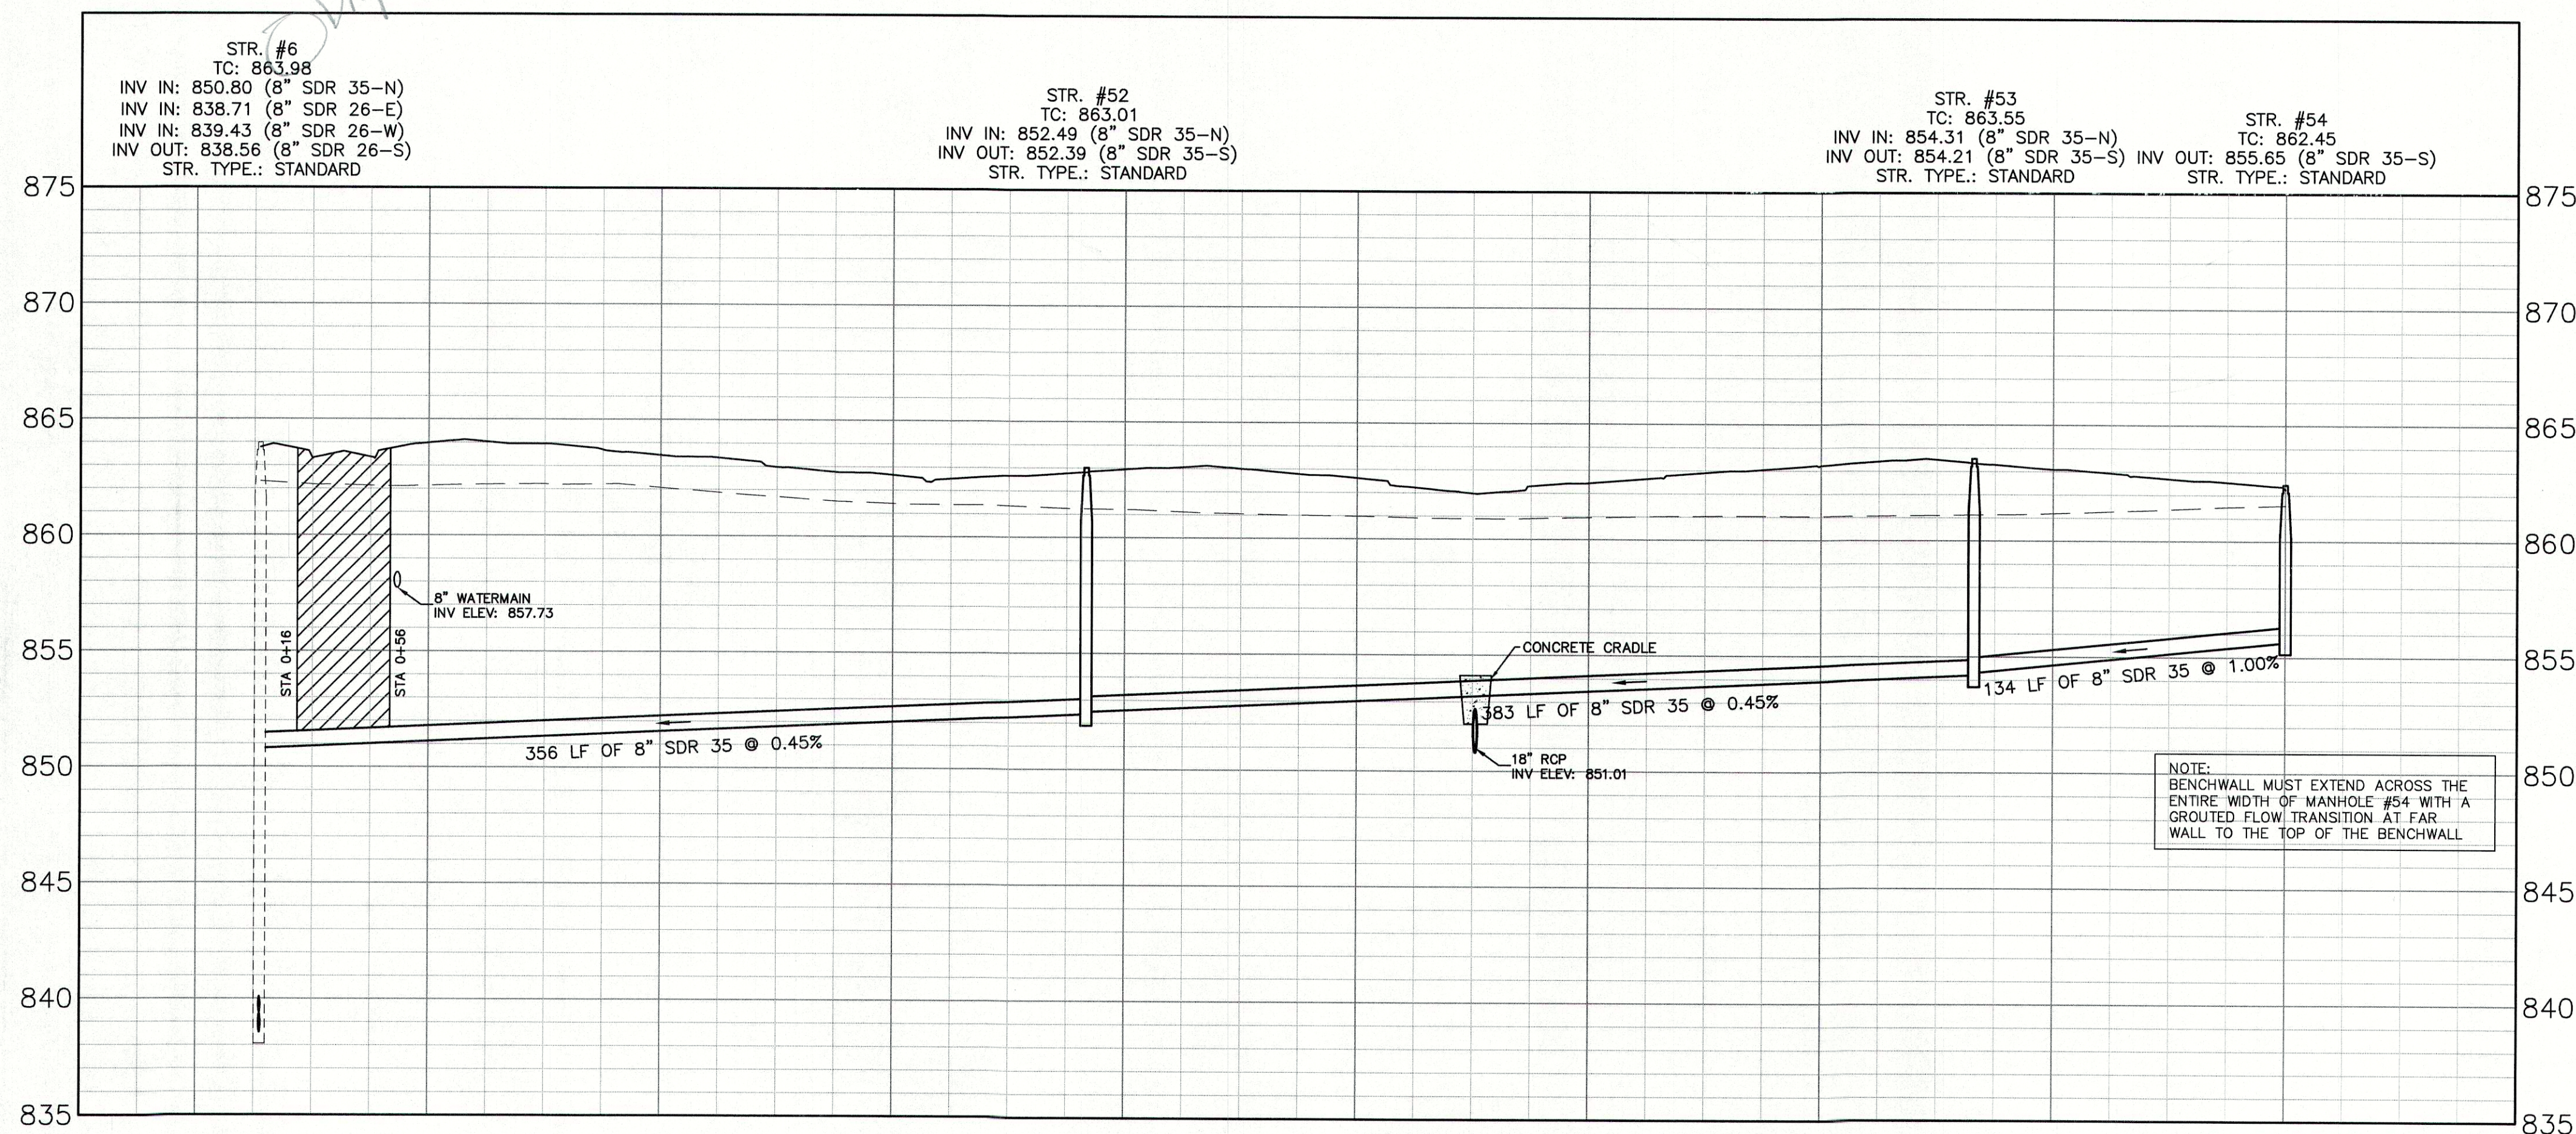

 GRANULAR BACKFILL
 EXISTING GRADE
 PROPOSED GRADE

NOTE:
GRANULAR BACKFILL IS REQUIRED FOR
SANITARY SEWER MAIN AND LATERAL
TRENCHES IN AND WITHIN 5' OF
EXISTING OR PROPOSED PAVEMENT OR
CURB PER THE FLEXIBLE PIPE BEDDING
DETAIL ON C8.4.

[illegible]

INDIANAPOLIS - TERRE HAUTE
FAYETTE - MUNCIE - NEW ALBANY
www.hwcengineering.com

SPRINGBROOK SECTION 3

SANITARY SEWER PLAN & PROFILE

REGISTERED
No. 11400758
STATE OF INDIANA
KRISTOPHER K. EICHORN
PROFESSIONAL ENGINEER

Kristopher K. Eichhorn

DRAWN BY TS	JOB NUMBER 2017-271-C
CHECKED BY KE	
DATE AUGUST 23, 2019	
SCALE AS SHOWN	
SHEET	

C4.0

Sanitary Sewer Plan & Profile