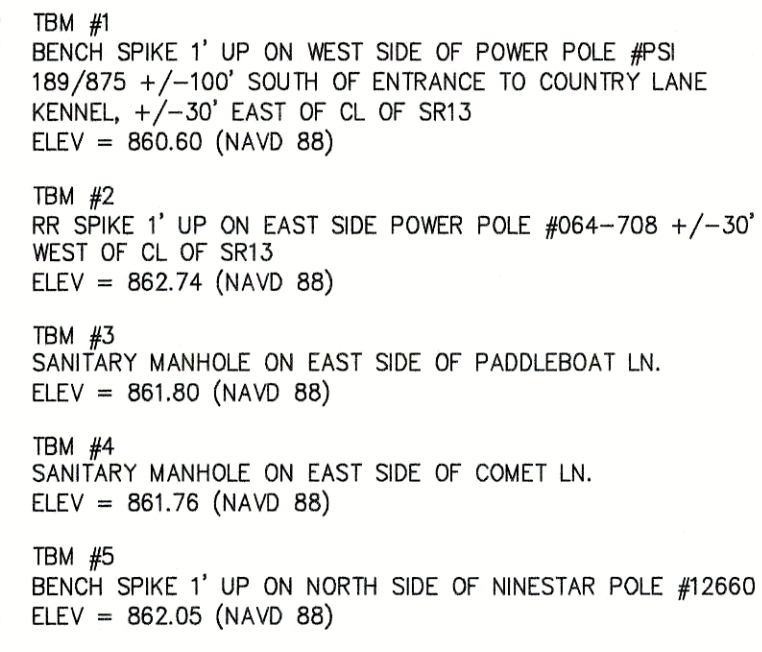


C4.1

SANITARY SEWER PLAN &
PROFILE