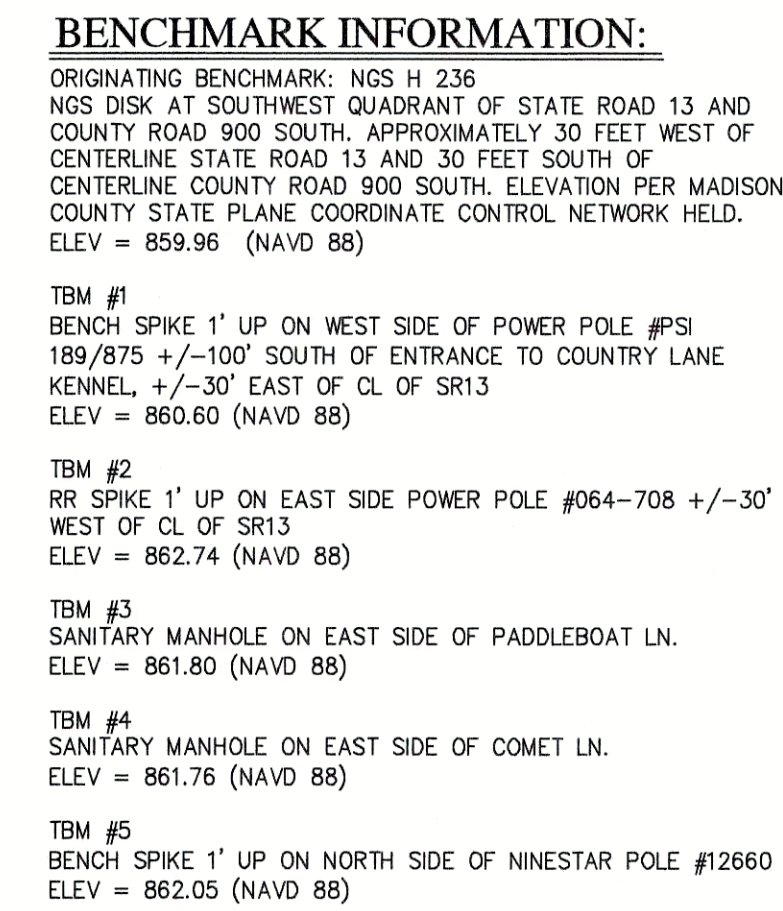
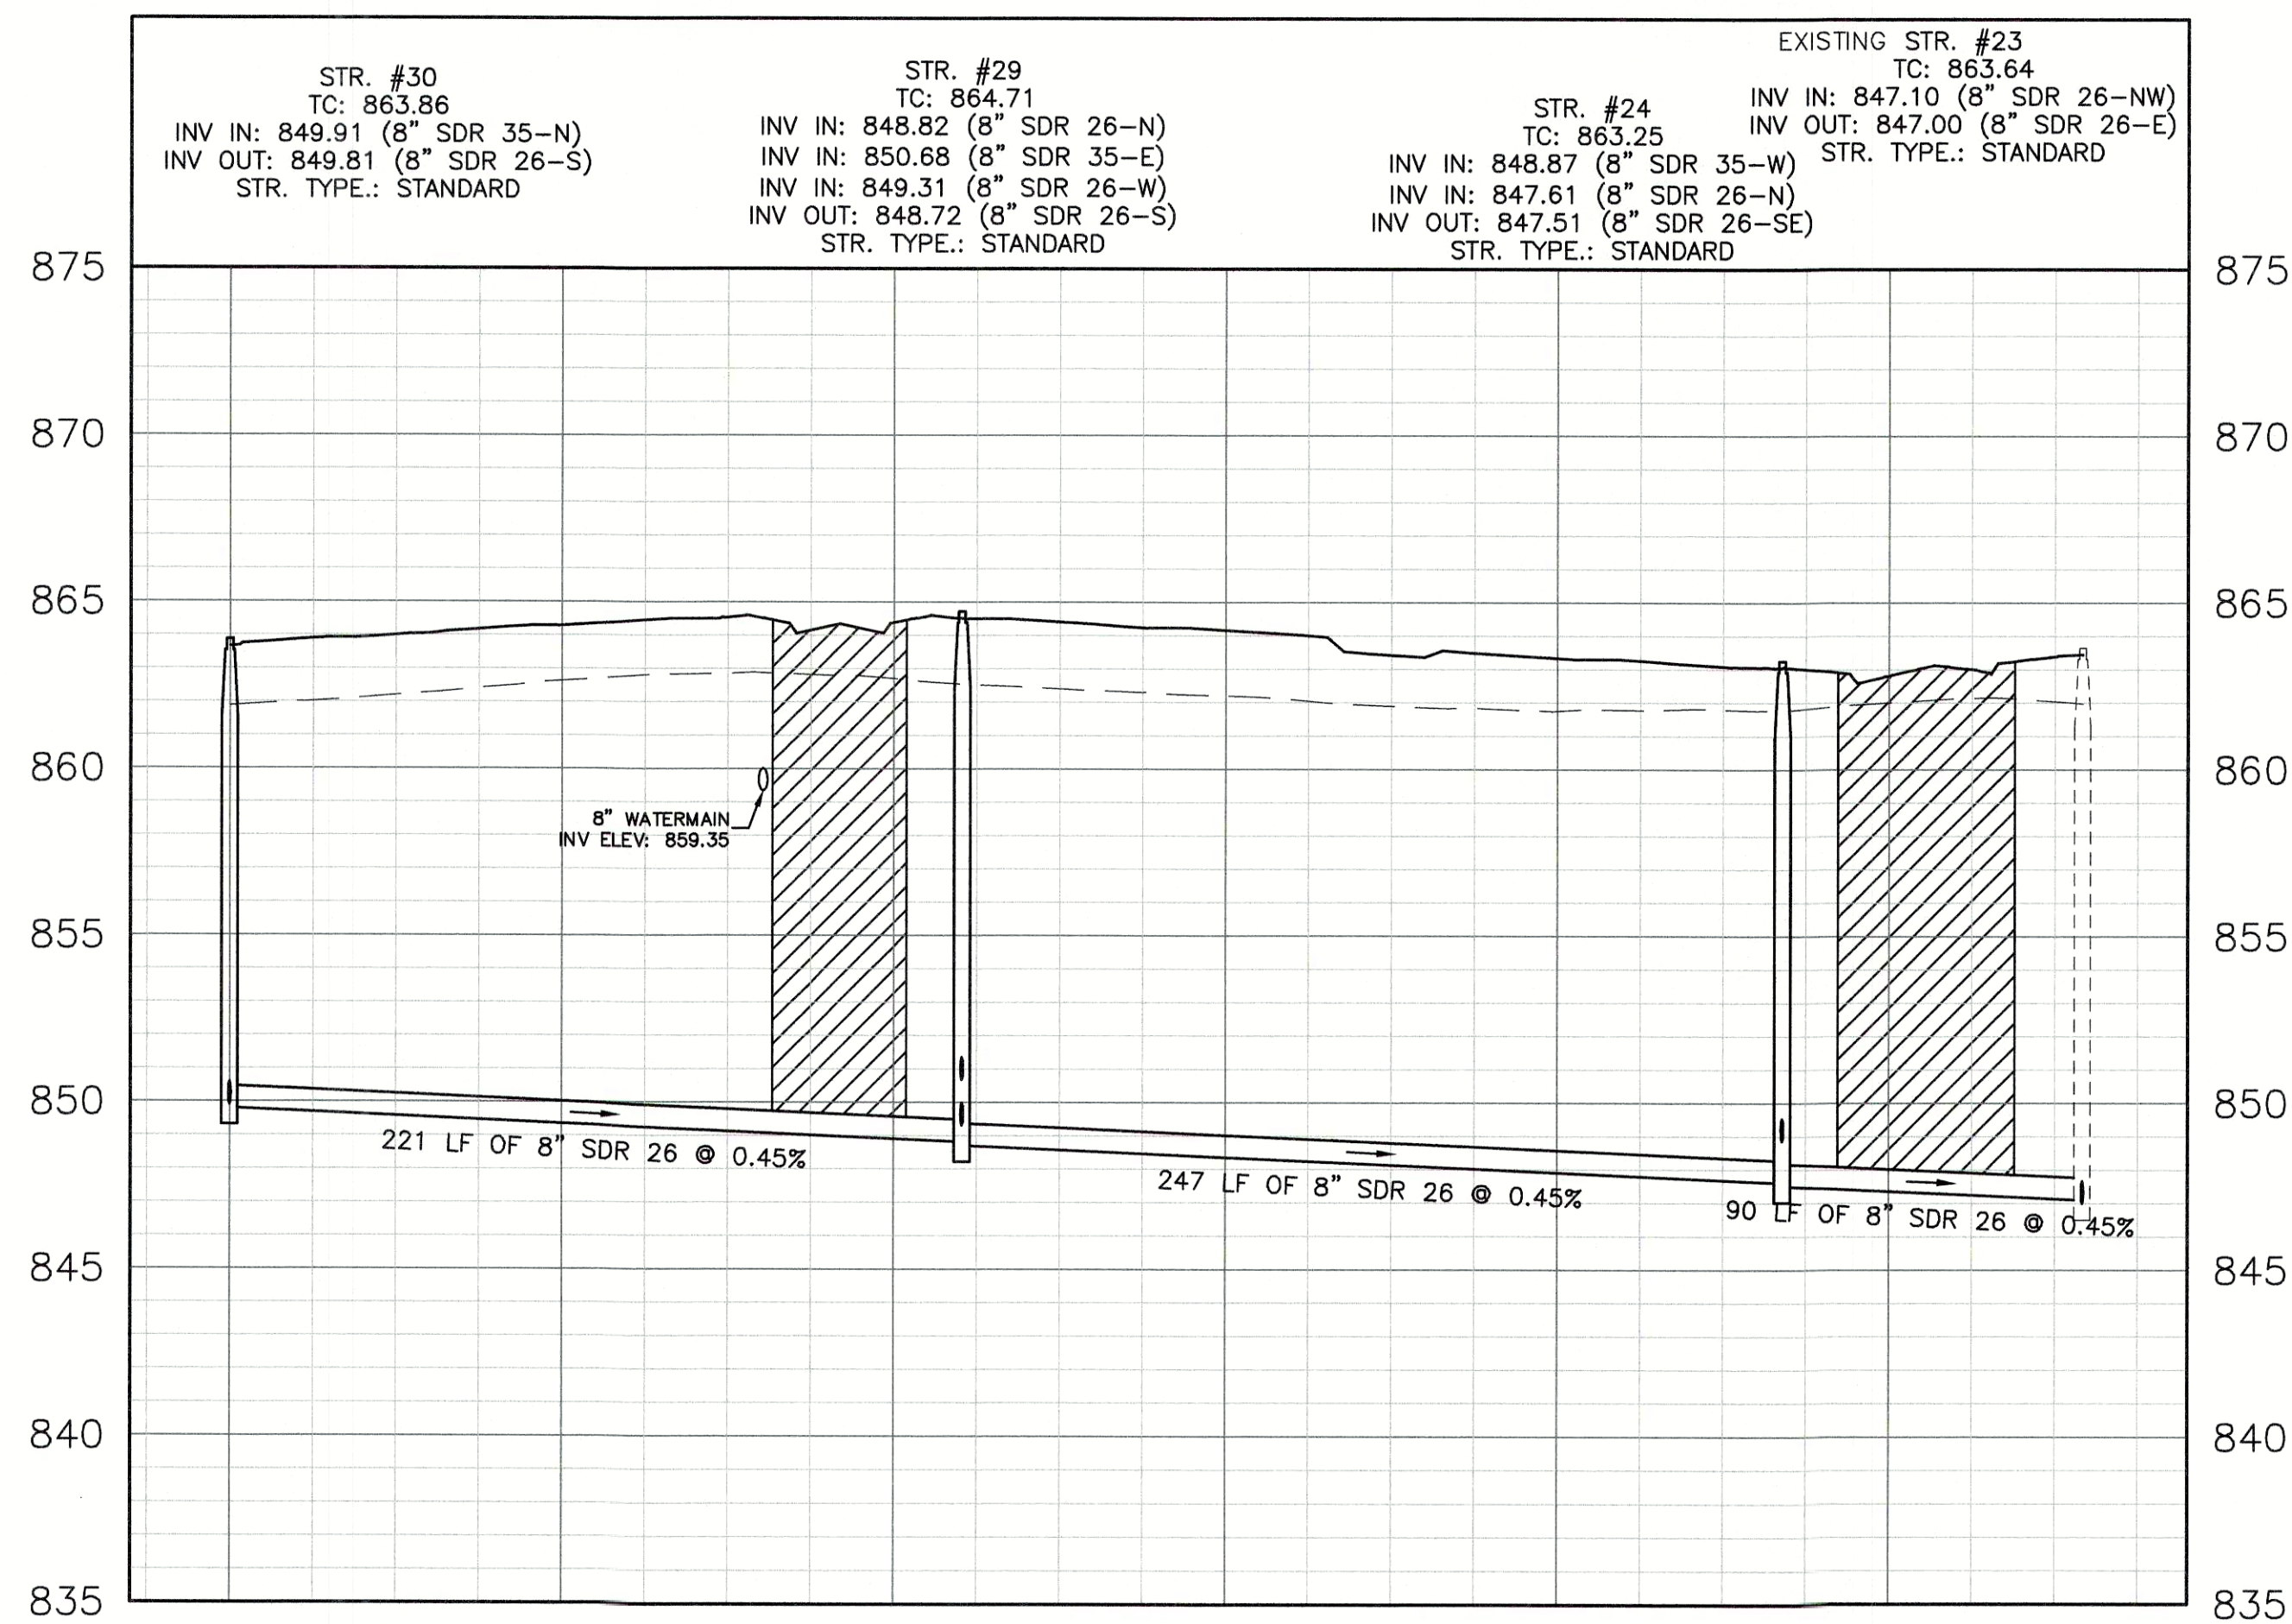


[illegible]

PVC GRAVITY SEWER PIPE AND FITTINGS
MUST, AT A MINIMUM, BE INSTALLED IN
ACCORDANCE WITH THE DIRECTIONS
CONTAINED IN ASTM D 2321.

NOTE:
GRANULAR BACKFILL IS REQUIRED FOR
SANITARY SEWER MAIN AND LATERAL
TRENCHES IN AND WITHIN 5' OF
EXISTING OR PROPOSED PAVEMENT OR
CURB PER THE FLEXIBLE PIPE BEDDING
DETAIL ON C8.4.

 GRANULAR BACKFILL
 - - - - - EXISTING GRADE
 _____ PROPOSED GRADE

[illegible]

**SPRINGBROOK
SECTION 4**

SANITARY SEWER PLAN & PROFILE



DRAWN BY TS/TD/GM	JOB NUMBER 2017-271-D
CHECKED BY KE	
DATE AUGUST 11, 2020	
SCALE AS SHOWN	
SHEET	

C4.2

SANITARY SEWER PLAN &
PROFILE