

AS BUILT DRAWING  
Customer Name F.C.R.W.D.  
Job Name \_\_\_\_\_  
Job Number 23198  
Drawn By Randy  
Date 5/10/04  
CULY CONSTRUCTION & EXCAVATING  
(765) 584-8509

# STATE STREET SANITARY SEWER PROJECT - PHASE III


## PROJECT FOR THE FALL CREEK REGIONAL WASTE DISTRICT PENDLETON, IN.

2003

### SHEET INDEX

SHEET NO.	DESCRIPTION
1	TITLE SHEET
2	PROJECT BASE MAP
3	PROPOSED PLAN & PROFILE
4	PROPOSED PLAN & PROFILE
5	PROPOSED PLAN & PROFILE
6	STANDARD SANITARY SEWER DETAILS

### PLANS PREPARED BY:

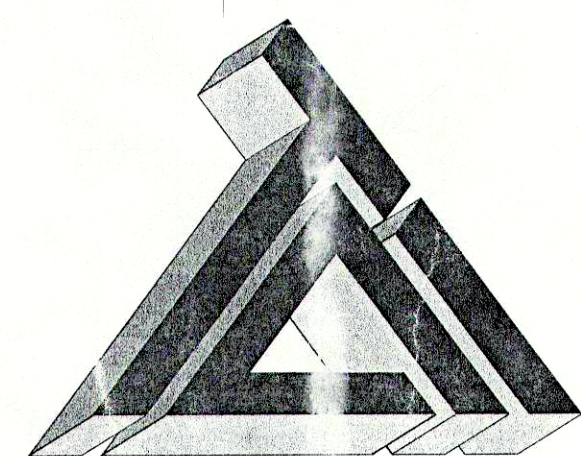


**TRIAD ASSOCIATES INC.**  
5835 LAWTON LOOP EAST DRIVE  
INDIANAPOLIS, INDIANA 46216  
PHONE: 317-377-5230 FAX: 317-377-5241

AREA MAP



AREA  
LOCATION

LOCATION MAP

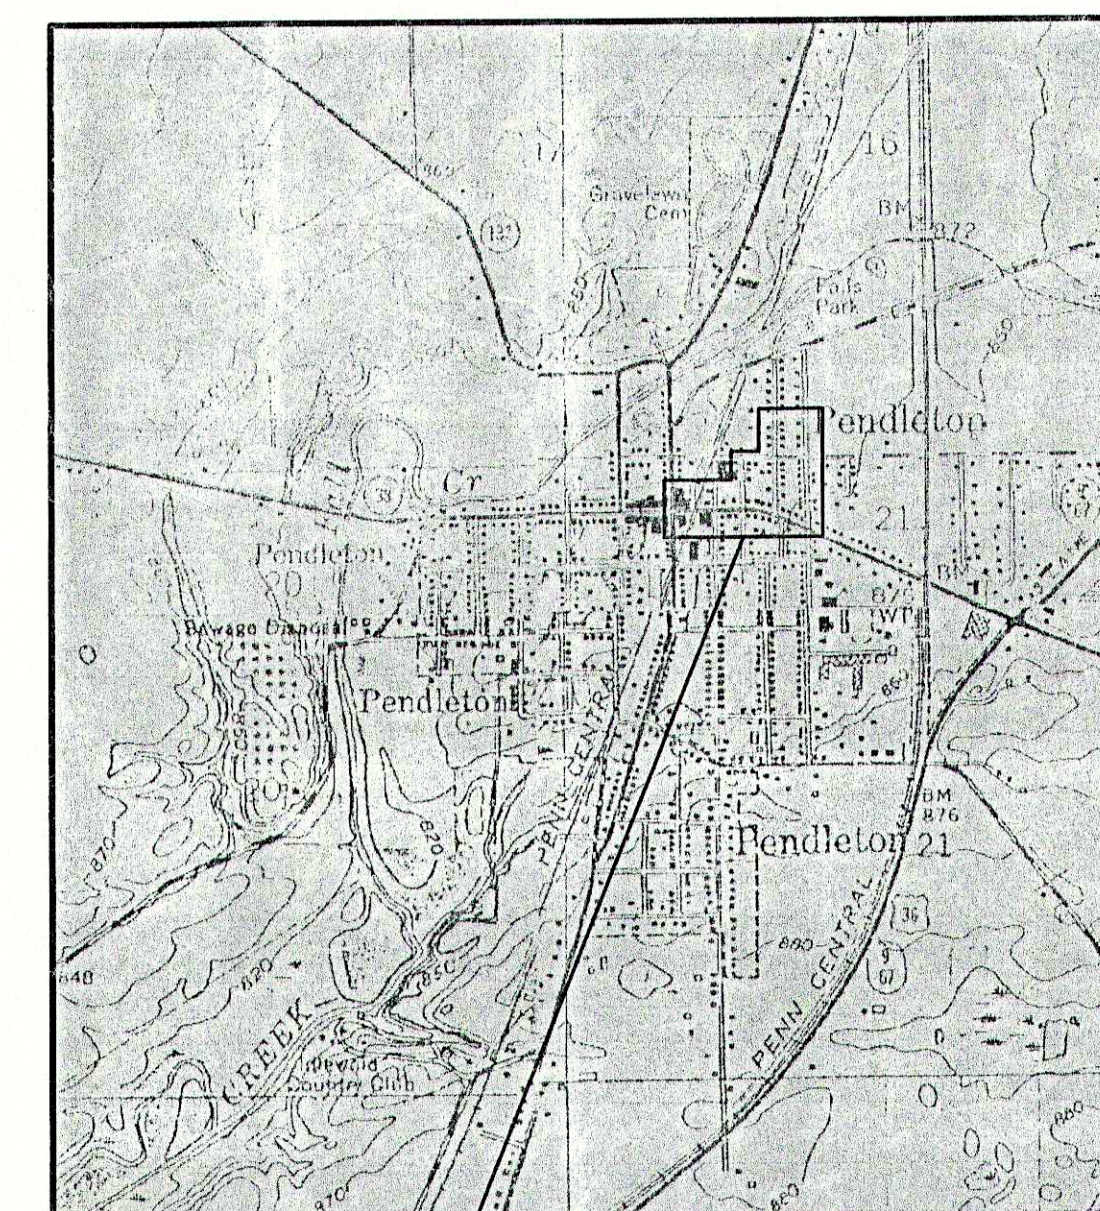


PROJECT  
LOCATION

### FALL CREEK REGIONAL WASTE DISTRICT BOARD


Mr. Morris McCurdy — President  
Mr. Gregory Valentine — Member  
Mr. Agon Tolbert — Member  
Mr. Douglas McGee — Member  
Mr. Dallas Foster — Member  
Mr. Mark Jablonski — Member  
Mr. Timothy McClintick — Member  
Mr. Timothy Green — Member  
Mr. Edward Stergar, Jr. — Member  
Mr. Joe Rowlett — General Manager

### THESE PLANS CERTIFIED BY:

James W. Frazell, Professional Engineer

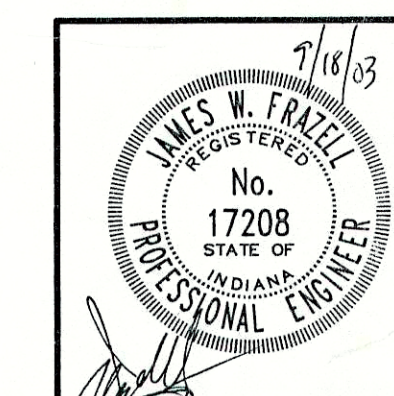

Thomas M. Schubert, Professional Engineer

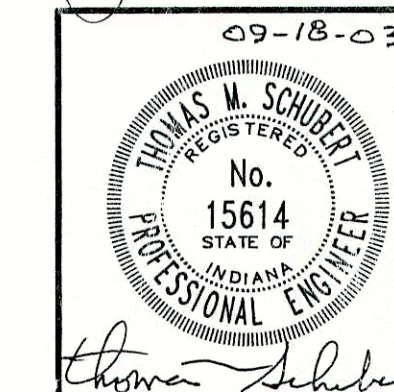

**NOTE:**  
ADDITIONAL RIGHT-OF-WAY OR EASEMENTS MAY  
NEED TO BE ACQUIRED FOR INSTALLATION OF SEWER.



DON'T DIG BLIND  
CALL BEFORE YOU DIG  
TOLL FREE  
1-800-382-5544  
INDIANA  
1-800-428-5200

PER INDIANA STATE LAW IS-69-1991, IT IS  
AGAINST THE LAW TO EXCAVATE WITHOUT  
NOTIFYING THE UNDERGROUND LOCATION SERVICE  
TWO (2) WORKING DAYS BEFORE COMMENCING WORK.  
**NOTE: CONTRACTOR TO VERIFY ALL UTILITY LOCATIONS  
PRIOR TO THE START OF CONSTRUCTION**