


MANHOLE 31 TO THE CLEANOUT PLAN VIEW



MANHOLE 29 TO THE MANHOLE 30 PLAN VIEW

NOTE:
ADDITIONAL RIGHT-OF-WAY OR EASEMENTS MAY
NEED TO BE ACQUIRED FOR INSTALLATION OF UTILITY.

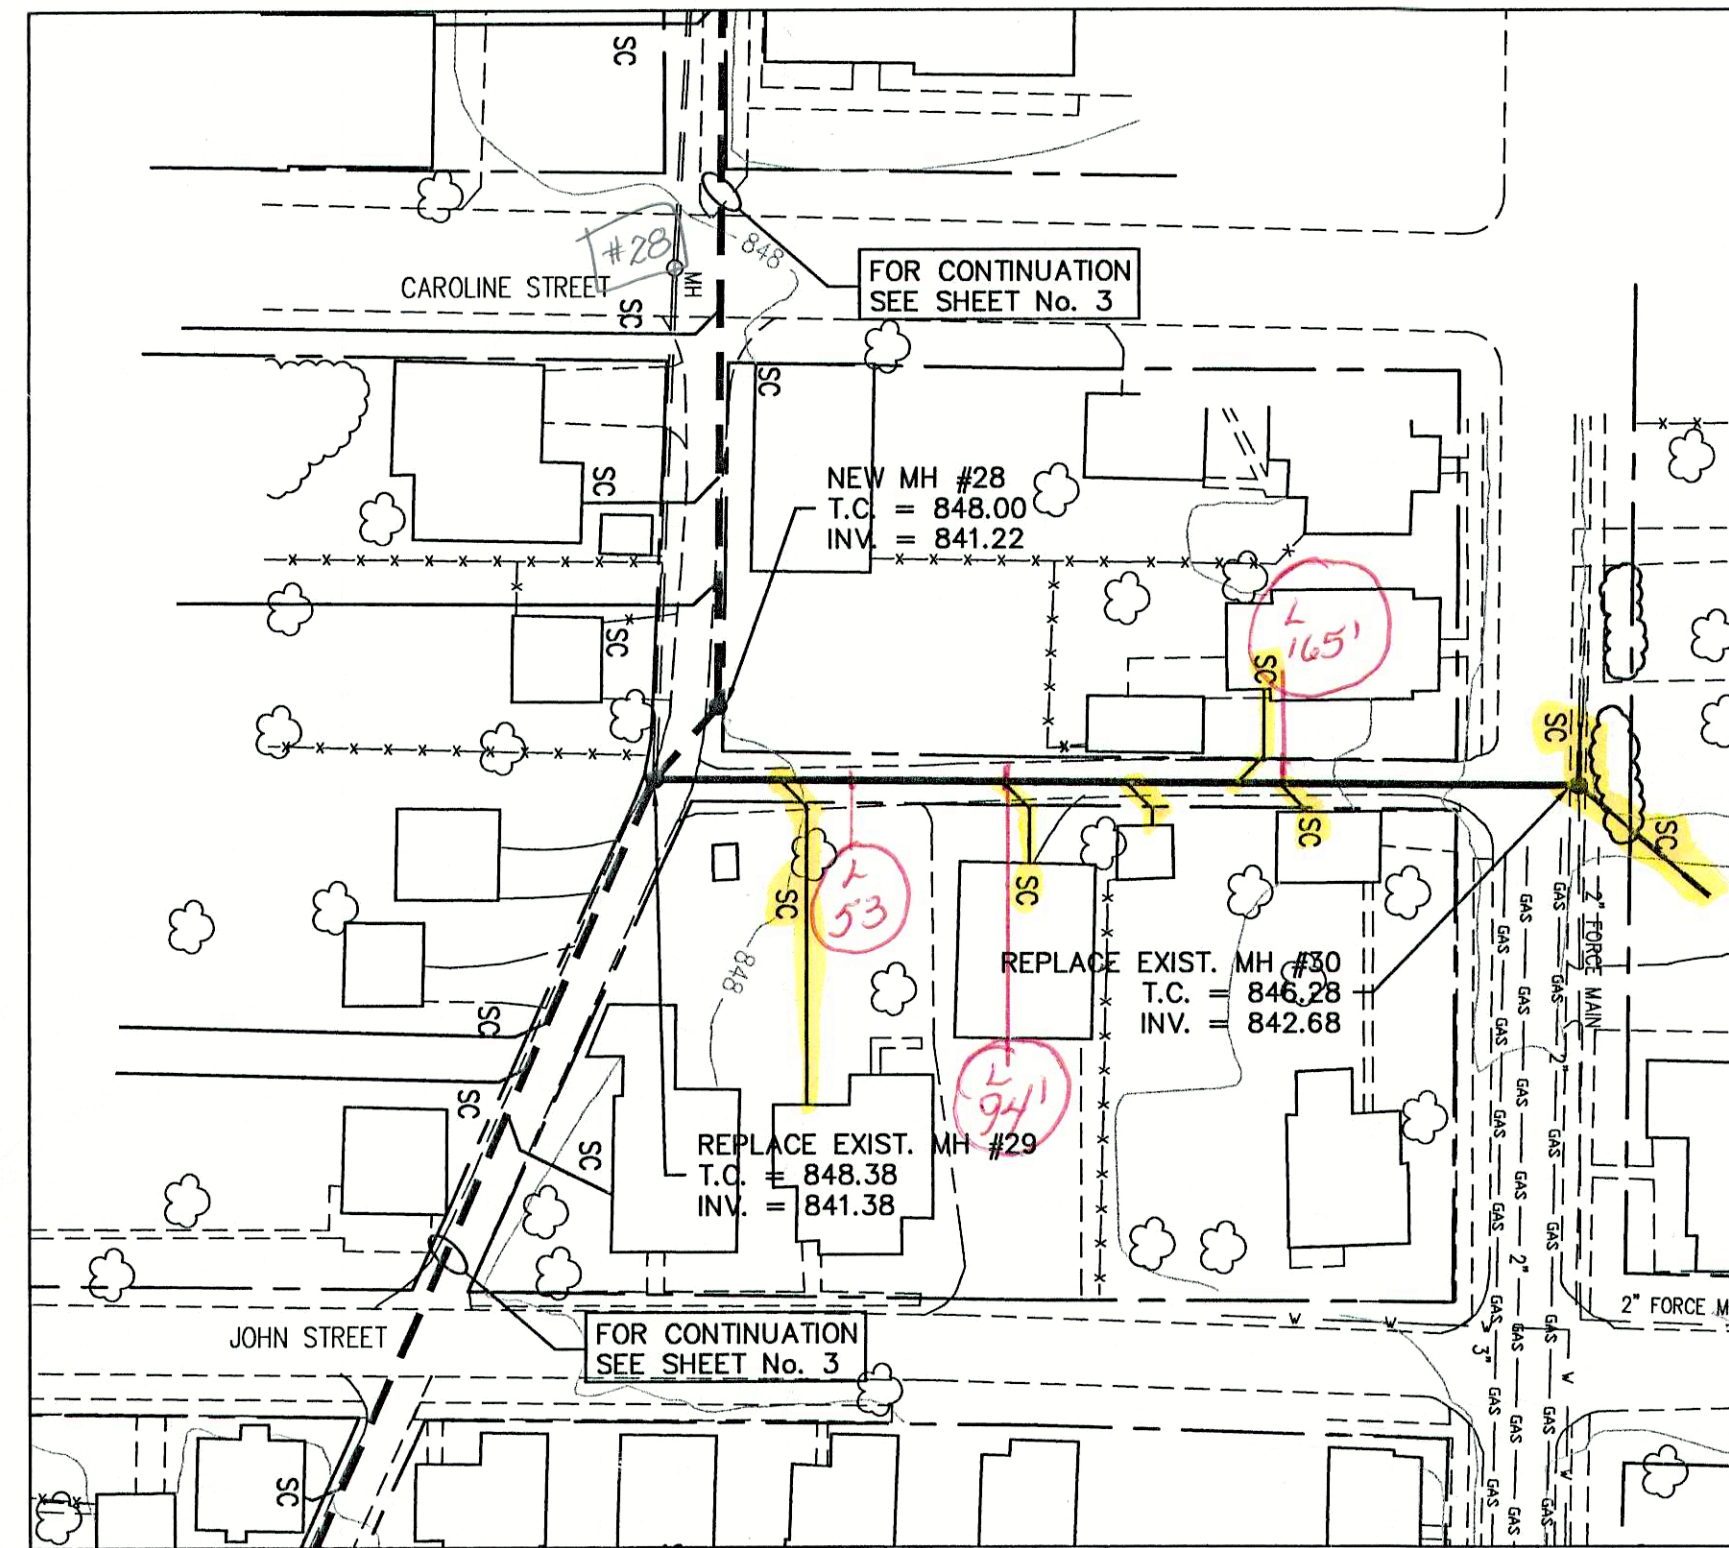

DON'T DIG BLIND
CALL BEFORE YOU DIG
1-800-382-5544
1-800-428-5200

PER INDIANA STATE LAW IS-69-1991, IT IS
AGAINST THE LAW TO EXCAVATE WITHOUT
NOTIFYING THE UNDERGROUND LOCATION SERVICE
TWO (2) WORKING DAYS BEFORE COMMENCING WORK.

LEGEND:

	TREE		PROPOSED GRINDER PUMP
	EXISTING FIRE HYDRANT		PROPOSED SANITARY FORCE MAIN
	PROPOSED FIRE HYDRANT		PROPOSED WATER
	MAILBOX		EXISTING WATER LINE
	SIGN		EXISTING ROAD DRAIN
	SPOT SHOT		GAS LINE
	CONTOUR		UNDERGROUND TELEPHONE LINE
	FENCE		EXISTING FIBER OPTIC LINE
	EXIST. SANITARY SEWER W/MANHOLE		APPROX. PROPERTY LINE
	POWER POLE		PROPOSED UTILITY EASEMENT
	MISCELLANEOUS POSTS		EXISTING UTILITY EASEMENT
	LIGHT POLE		
	INLET		
	ASPHALT SURFACE		
	CONCRETE SURFACE		
	STONE SURFACE		
	NEW GRAVITY SERVICE CONNECTION		
	PROPOSED SANITARY GRAVITY		


NOTE:
TRIAD ASSOCIATES, INC. DOES NOT
GUARANTEE THE ACCURACY OF THE
SURVEY OR ELEVATIONS. THIS
INFORMATION WAS GIVEN TO TRIAD
ASSOCIATES, INC. BY FALL CREEK
REGIONAL WASTE DISTRICT.

GENERAL NOTES:

- ALL UTILITY LOCATIONS ARE APPROXIMATE. THE CONTRACTOR SHALL HAVE ALL UTILITIES FIELD VERIFIED AND MARKED PRIOR TO CONSTRUCTION.
- CONTRACTOR SHALL MAINTAIN A MINIMUM 10'-0" HORIZONTAL AND 18" VERTICAL SEPARATION BETWEEN SEWER AND WATER MAINS.
- ALL PROPOSED TOP OF CASTING ELEVATIONS ARE APPROXIMATE. THE CONTRACTOR SHALL ADJUST FINAL ELEVATIONS AS REQUIRED TO BE FLUSH WITH PAVEMENT.
- ALL SEWER TRENCHES SHALL BE BACKFILLED WITH FULL DEPTH COMPACTED GRANULAR BACKFILL ("B" BORROW) UNDER OR WITHIN 5' OF EDGE OF PAVEMENT.
- THE CONTRACTOR SHALL VISIT THE SITE PRIOR TO BID TO BECOME FAMILIAR WITH ALL SITE CONDITIONS.
- THE CONTRACTOR SHALL PROVIDE THE REQUIRED MEANS FOR MAINTAINING SAFE TRAFFIC AT ALL TIMES.
- CONTRACTOR SHALL RESTORE ALL DISTURBED LAWN AREAS, STREETS, WALKS, DRIVES, ETC. AS SHOWN ON DRAWINGS, IN THE SPECIFICATIONS, OR TO AT LEAST PRE-EXISTING CONDITIONS.
- ALL UTILITY CROSSINGS SHALL BE PROTECTED AND SUPPORTED WITH GRANULAR FILL OR CONCRETE AS REQUIRED PER THE DETAIL SHEET.

BM #66 - STATE HIGHWAY MARKER, SOUTHWEST HEADWALL ON
MAIN STREET BRIDGE OVER FALL CREEK. EL. 840.35

SCALE
HORIZONTAL SCALE: 1" = 50'
VERTICAL SCALE: 1" = 5'

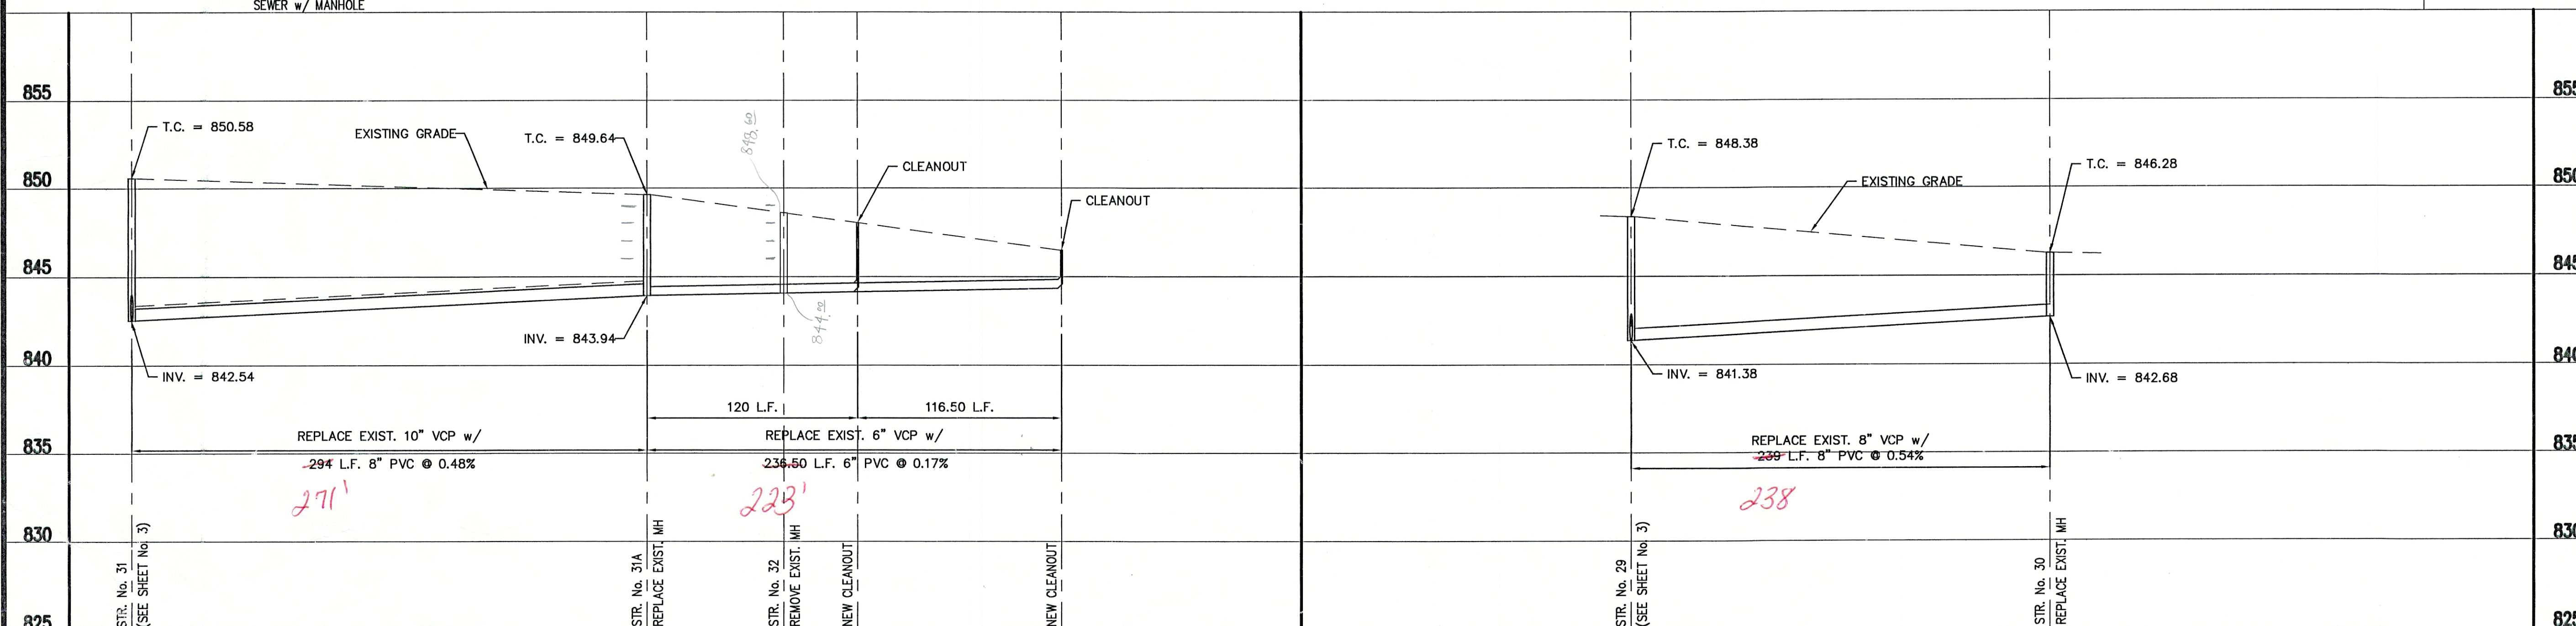

CONSULTANT:

REVISIONS:

DATE	DESCRIPTION	BY

APPROVED BY:
09-18-03
THOMAS M. SCHUBERT
No. 15614
STATE OF INDIANA
PROFESSIONAL ENGINEER
thomas schubert

DESIGNED FOR:
STATE STREET SANITARY SEWER
PROJECT - PHASE III

SHEET TITLE:
STATE STREET PLAN AND PROFILE

JOB NUMBER: 200302G

SCALE: AS NOTED

CHECKED BY: T.M.S.

PLOT SCALE: 1" = 50'

PLOT DATE: 09/23/03

DRAWN BY: J.E.C.

DATE: 09/19/03

DESIGNED BY: T.M.S.

DRAWING NAME: FCRWD3-BASE

SHEET No.
4
OF 6