

# SUNVIEW ADDITION, ALFONT AND REFORMATORY ROAD SANITARY SEWER PROJECT

PROJECT FOR THE  
FALL CREEK REGIONAL WASTE DISTRICT  
MADISON CO., IN.

1998

SRF PROJECT NO. CS 18207701

DIVISION II


CONTRACT 'C'

JOE ROWLETT - GENERAL MANAGER

## SHEET INDEX


| SHEET NO. | DESCRIPTION                           |
|-----------|---------------------------------------|
| 1         | TITLE SHEET AND INDEX                 |
| 2-4       | PROJECT BASE MAP                      |
| 5-27      | PLAN AND PROFILES FOR                 |
| 28        | SUNVIEW LIFT STATION DETAILS          |
| 29        | REFORMATORY ROAD LIFT STATION DETAILS |
| 30        | ALFONT LIFT STATION DETAILS           |
| 31        | WEST INGALLS LIFT STATION             |
| 32-33     | STANDARD SANITARY SEWER DETAILS       |

AREA MAP

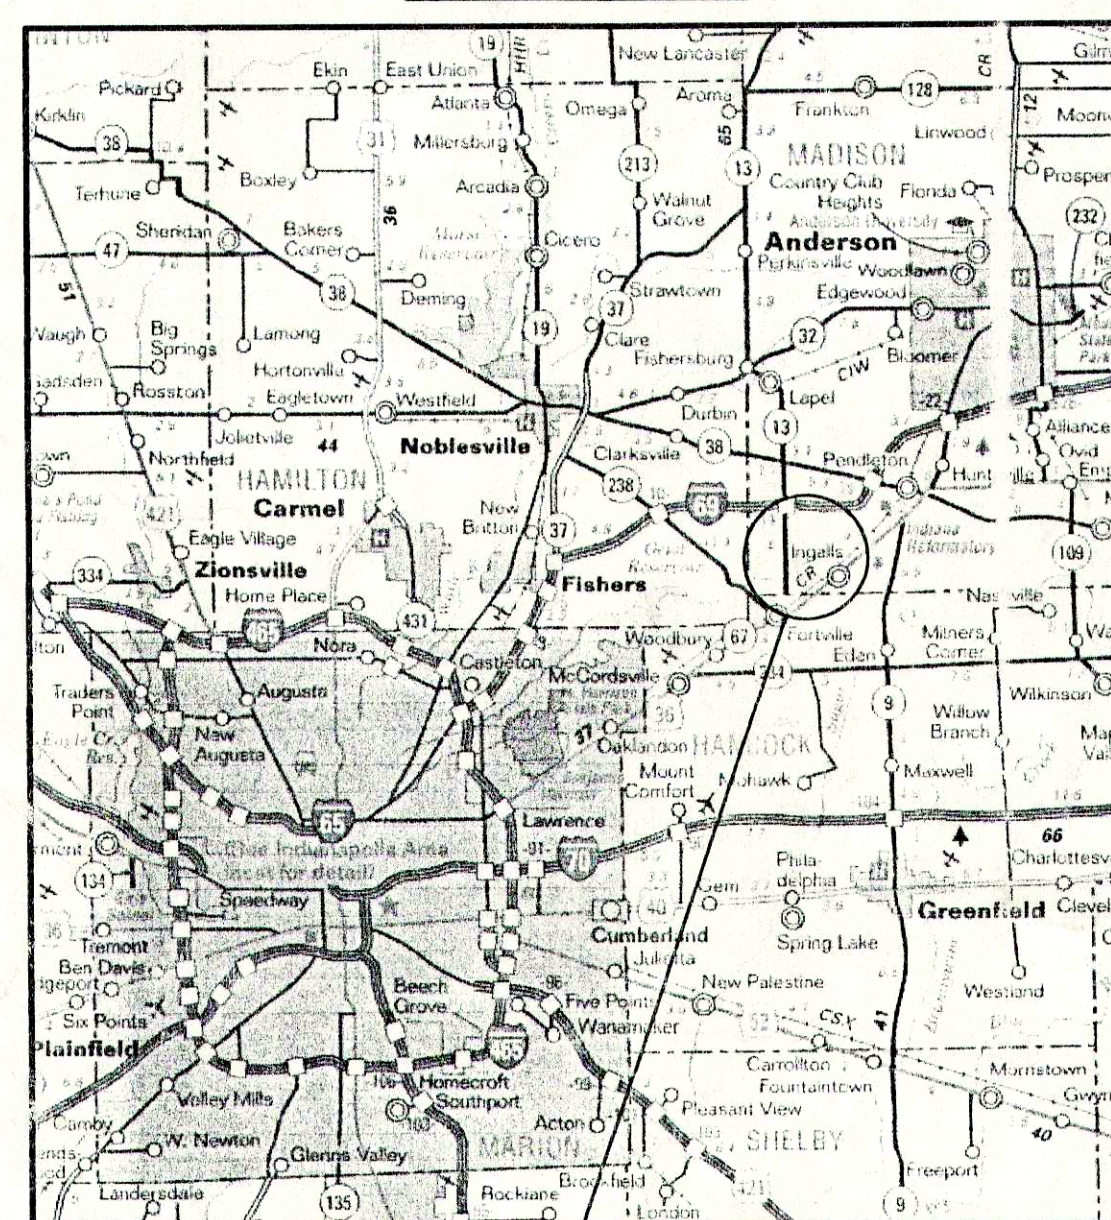

AREA  
LOCATION

LOCATION MAP

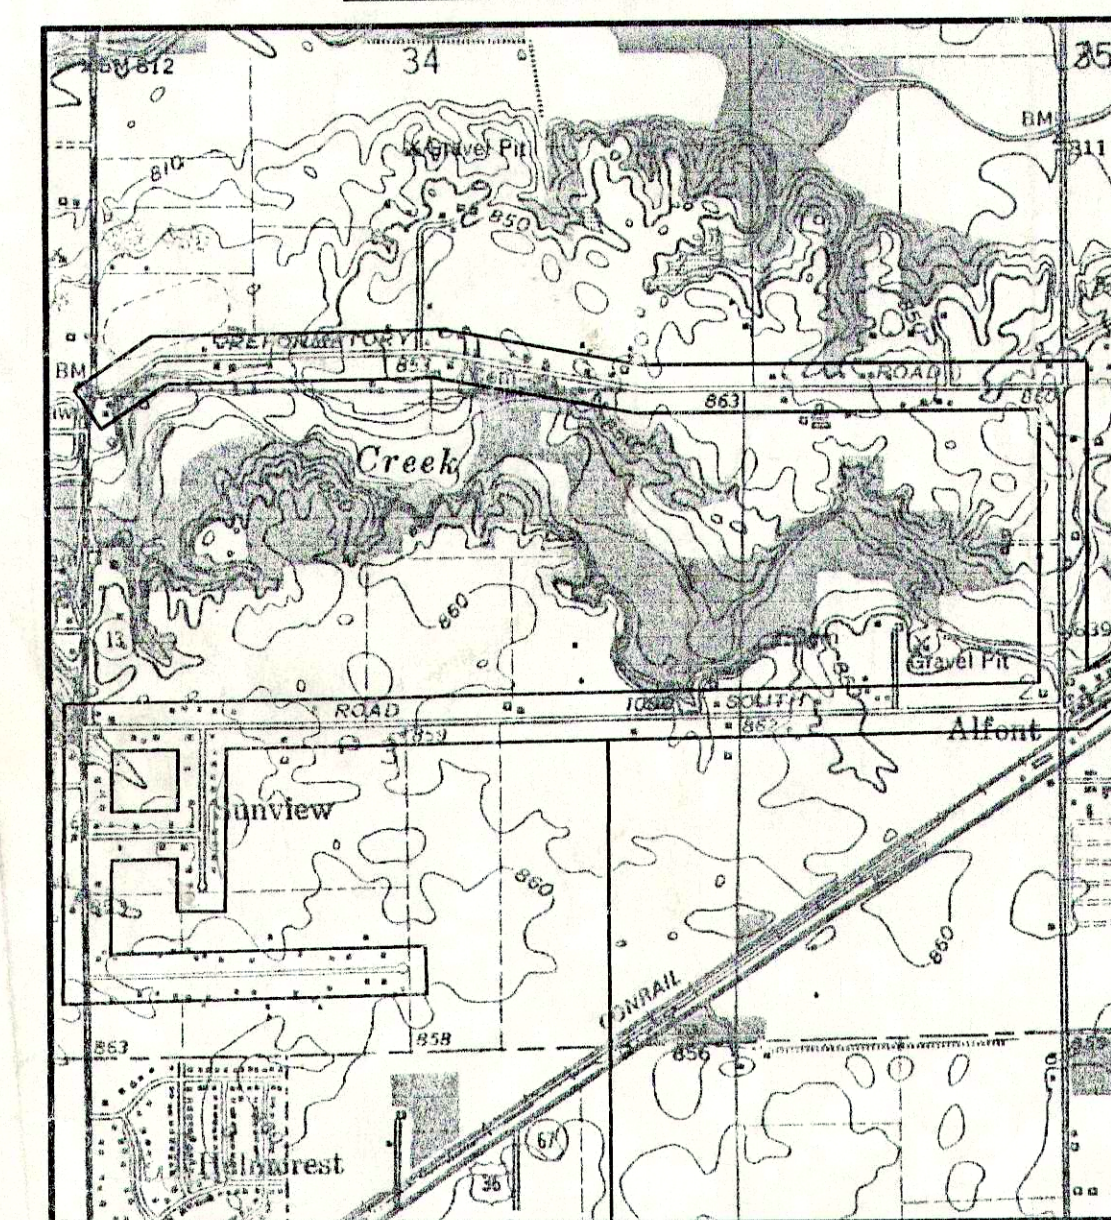

PROJECT  
LOCATION

## FALL CREEK REGIONAL WASTE DISTRICT BOARD

Mr. William Clark - President  
Mr. Morris McCurdy - Member  
Mr. Doug McGee - Member  
Mr. Mark Jablonski - Member  
Mr. Agon Tolbert - Member  
Mr. Dallas Foster - Member  
Mr. Jack Kasdorf - Member  
Mr. Timothy Green - Member  
Mr. John Ellingwood - Member  
Mr. Joe Rowlett - General Manager

## ATTORNEY

Mr. Randall Sorrell

## PLANS PREPARED BY:

**TRIAD**  
ASSOCIATES  
INC.  
INDIANAPOLIS, INDIANA

NOTE:  
ADDITIONAL RIGHT-OF-WAY OR EASEMENTS MAY  
NEED TO BE ACQUIRED FOR INSTALLATION OF SEWER.



DON'T DIG BLIND  
CALL BEFORE YOU DIG  
1-800-392-5544  
1-800-428-5200

PER INDIANA STATE LAW 15-69-1991, IT IS  
AGAINST THE LAW TO EXCAVATE WITHOUT  
NOTIFYING THE UNDERGROUND LOCATION SERVICE  
TWO (2) WORKING DAYS BEFORE COMMENCING WORK.  
NOTE: CONTRACTOR TO VERIFY ALL UTILITY LOCATIONS  
PRIOR TO THE START OF CONSTRUCTION

## THESE PLANS CERTIFIED BY:

James W. Frazell, Professional Engineer

**RECORD DRAWING**

August 23, 2001

Thomas M. Schubert, Professional Engineer

