


NOTE: CONTRACTOR TO VERIFY ALL UTILITY LOCATIONS
PRIOR TO THE START OF CONSTRUCTION

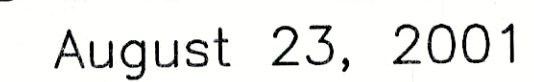

TCI OF CENTRAL INDIANA
335 E. 10th STREET
ANDERSON, INDIANA 46016
1 (765) 649-0407

DRAWN BY: DAP	DATE 04/12/98	PROJECT No. 98008A	SHEET No. 2
	SCALE AS NOTED		
DESIGNED BY: D.A. Pauling		33 OF	
CHECKED BY: James W. Frazell, P.E.			

C:\Dwg\SUNV\TMSU\3ASE1.dwg, 11/06/01 09:57:21 AM, 1:180