

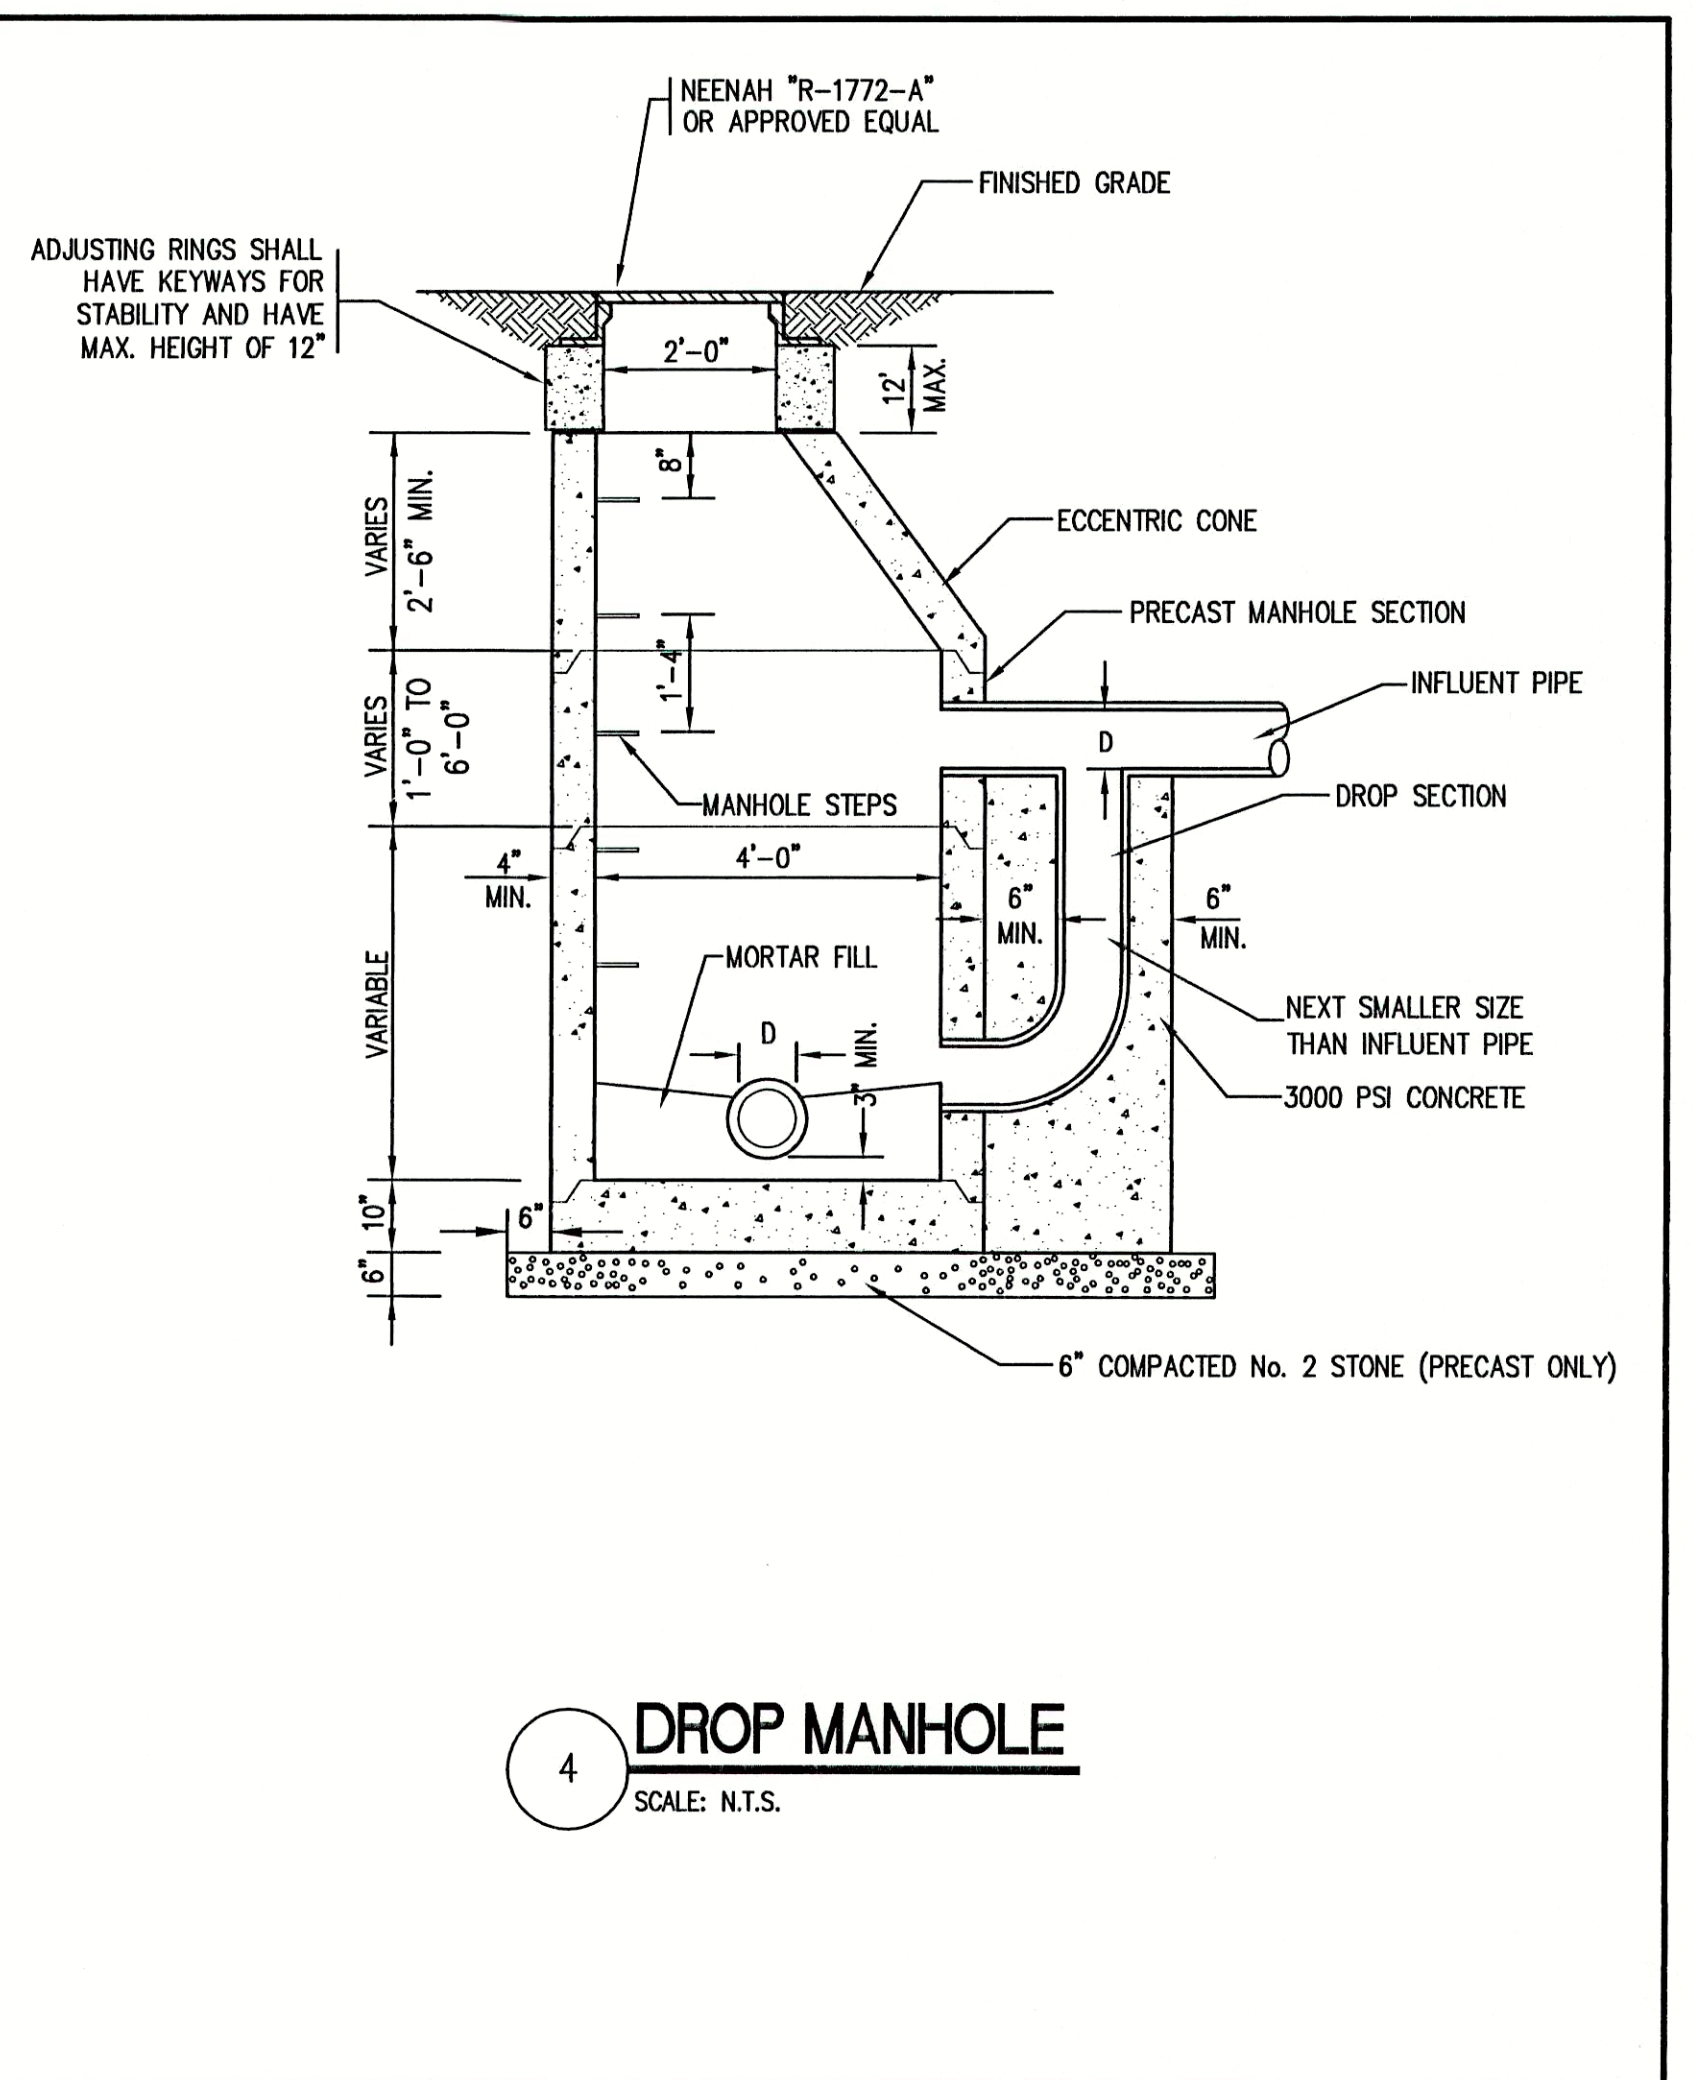
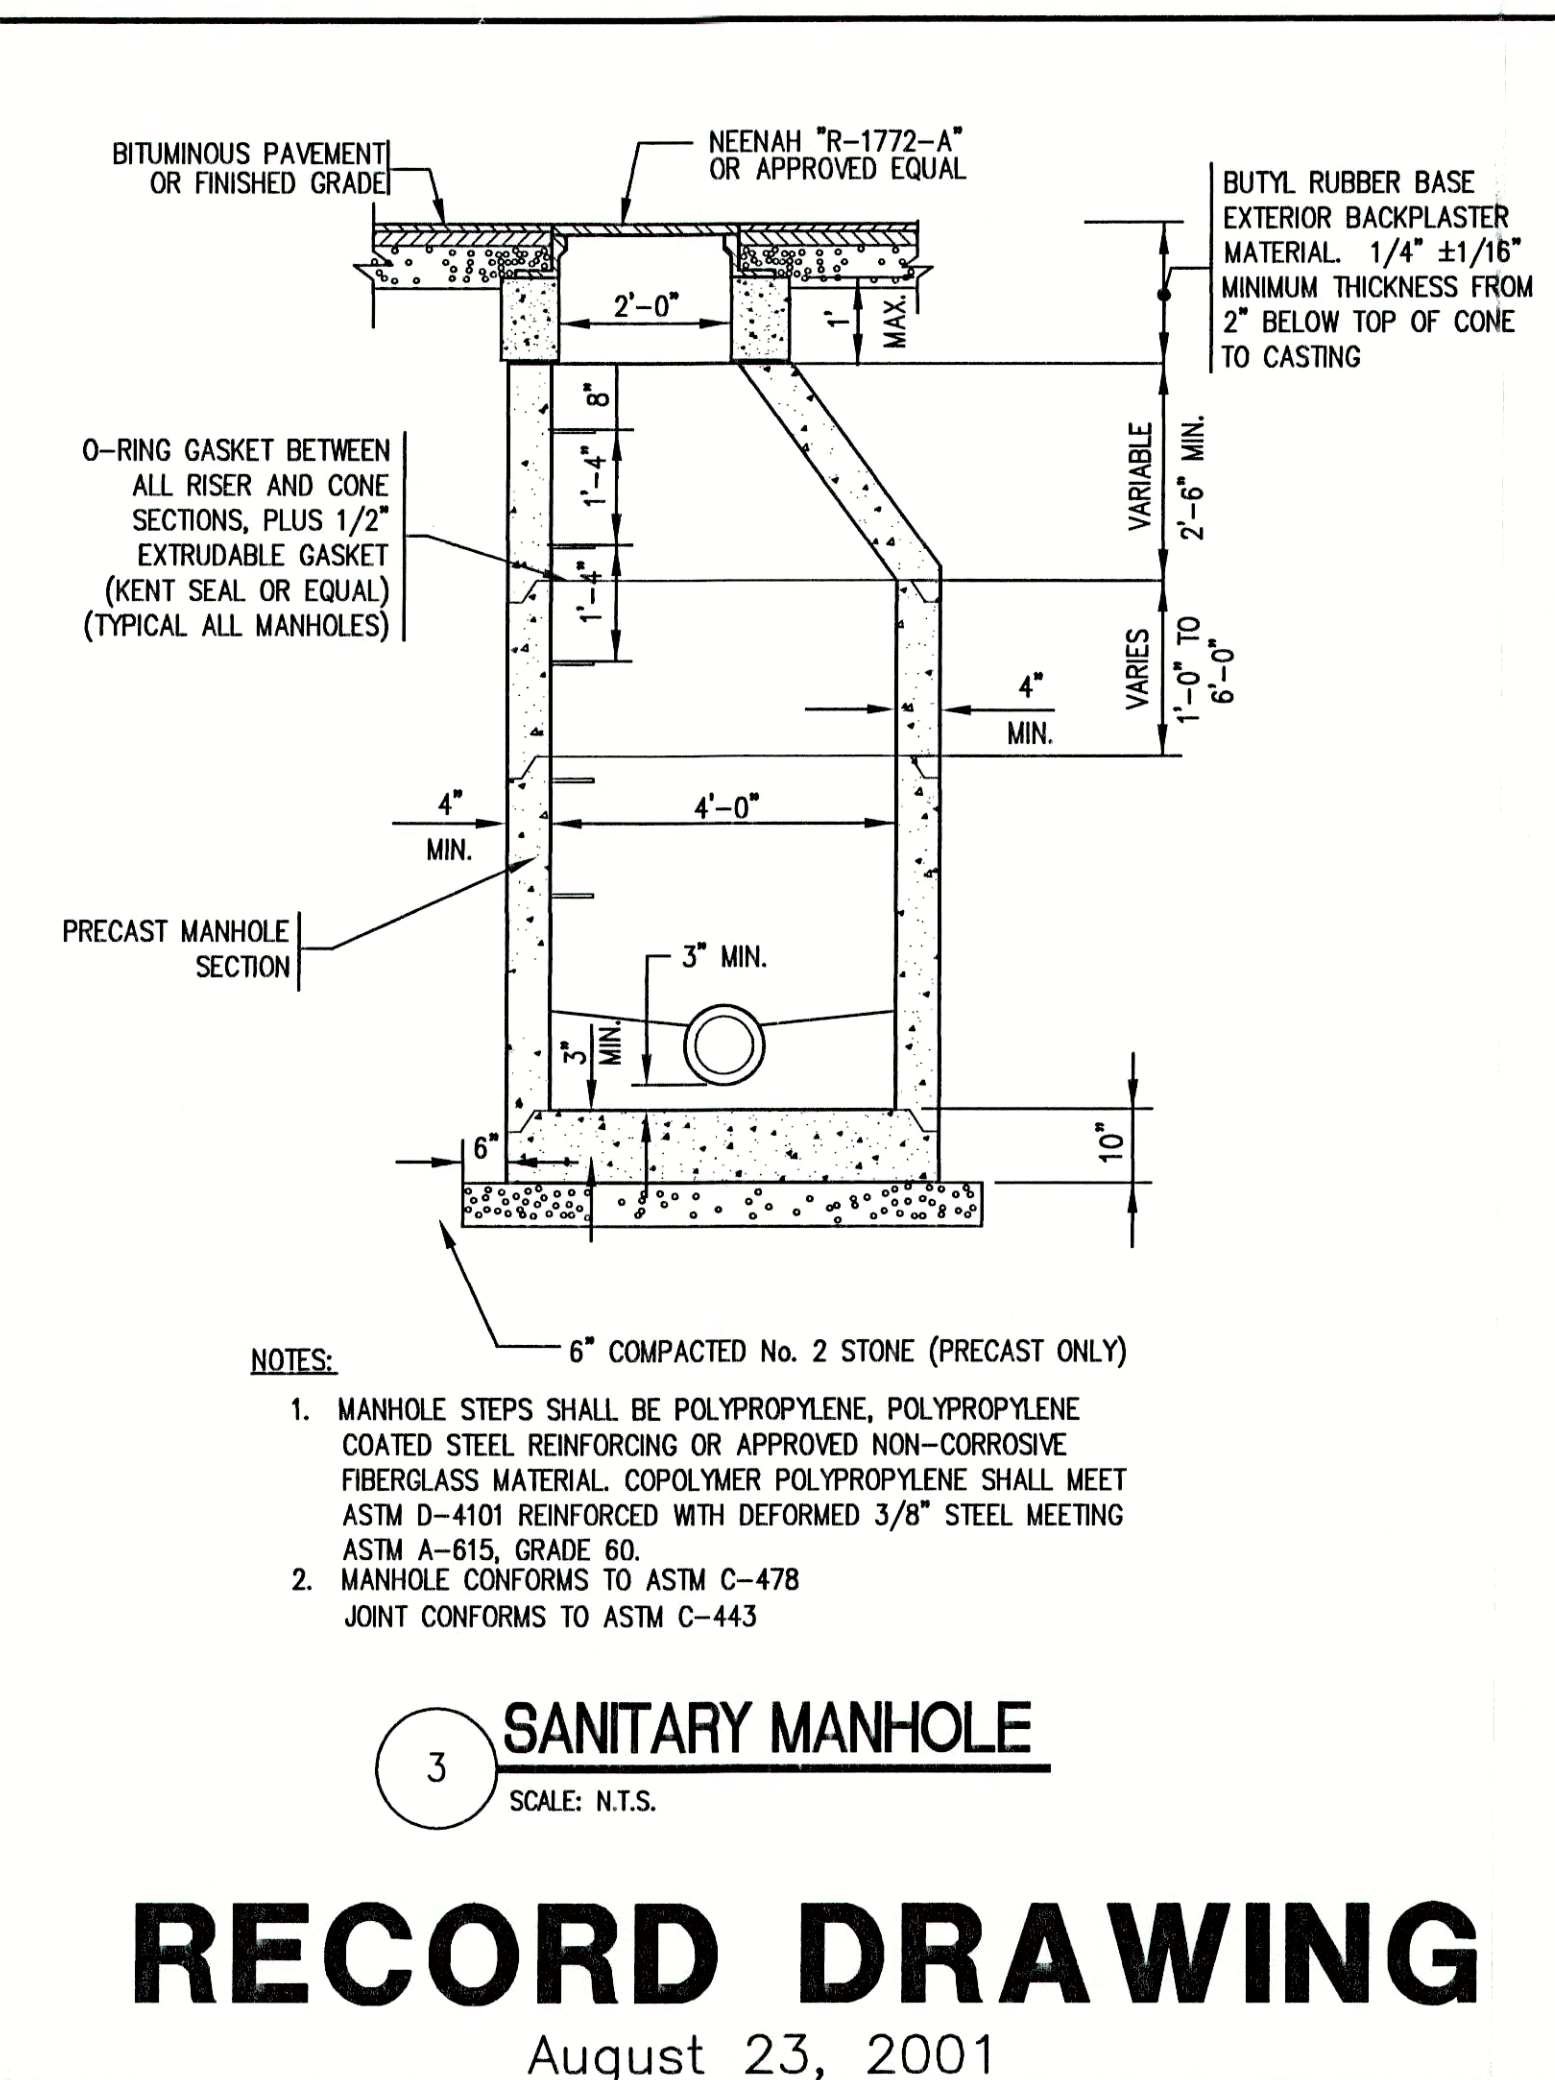
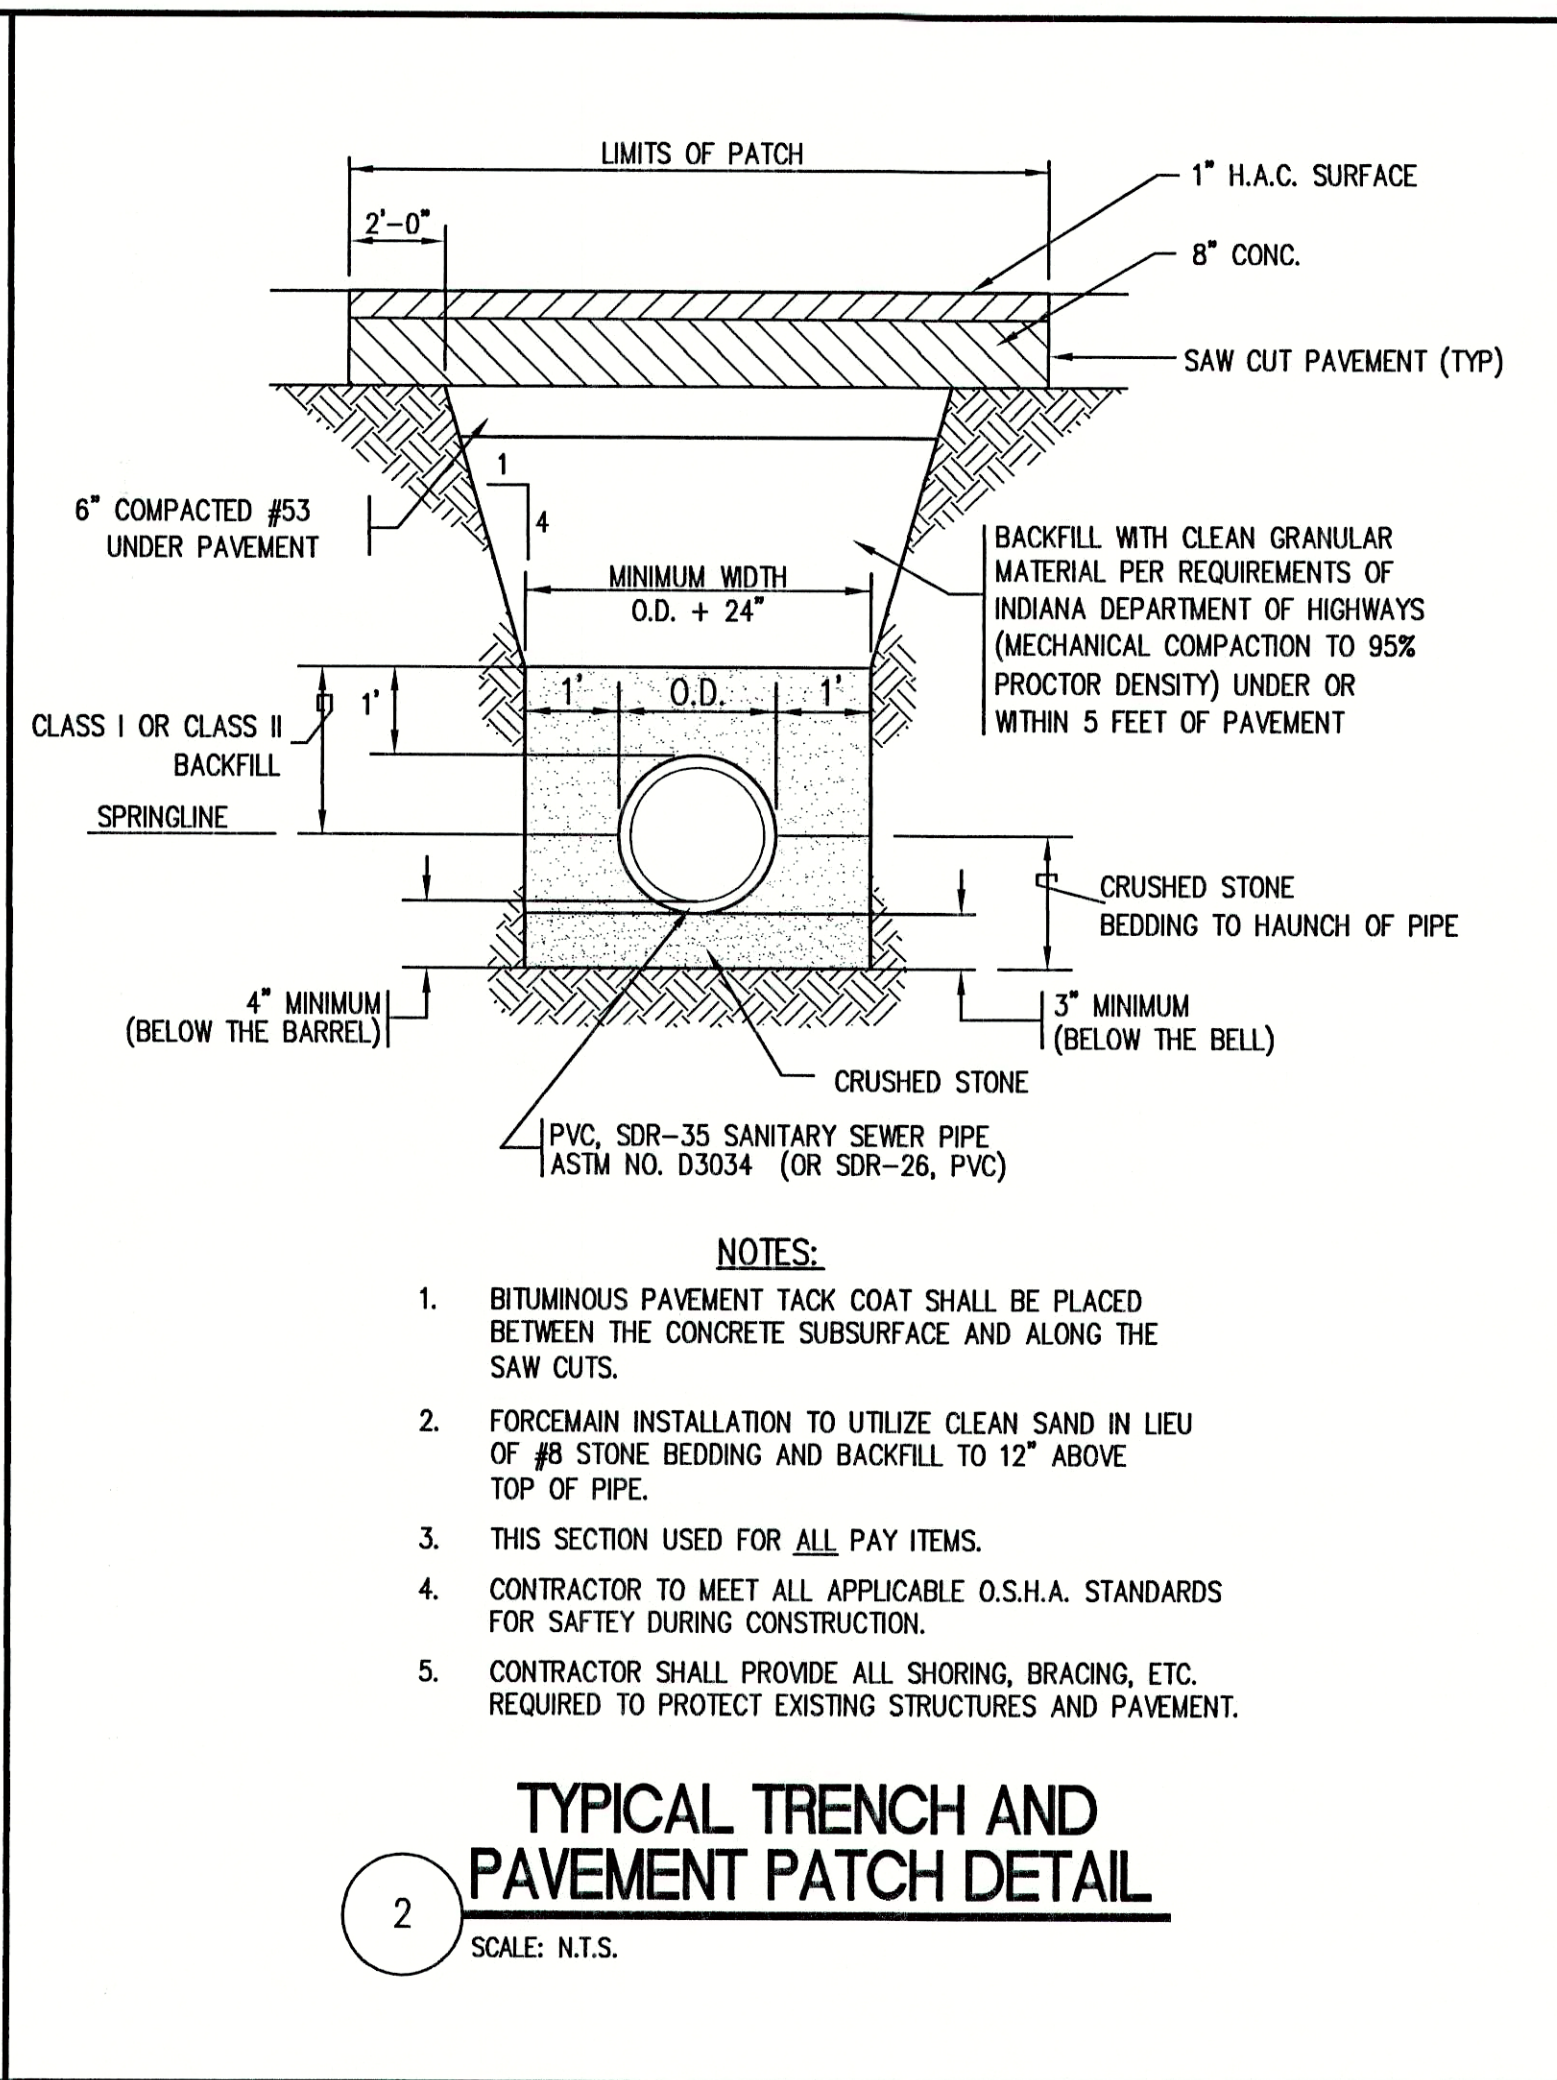
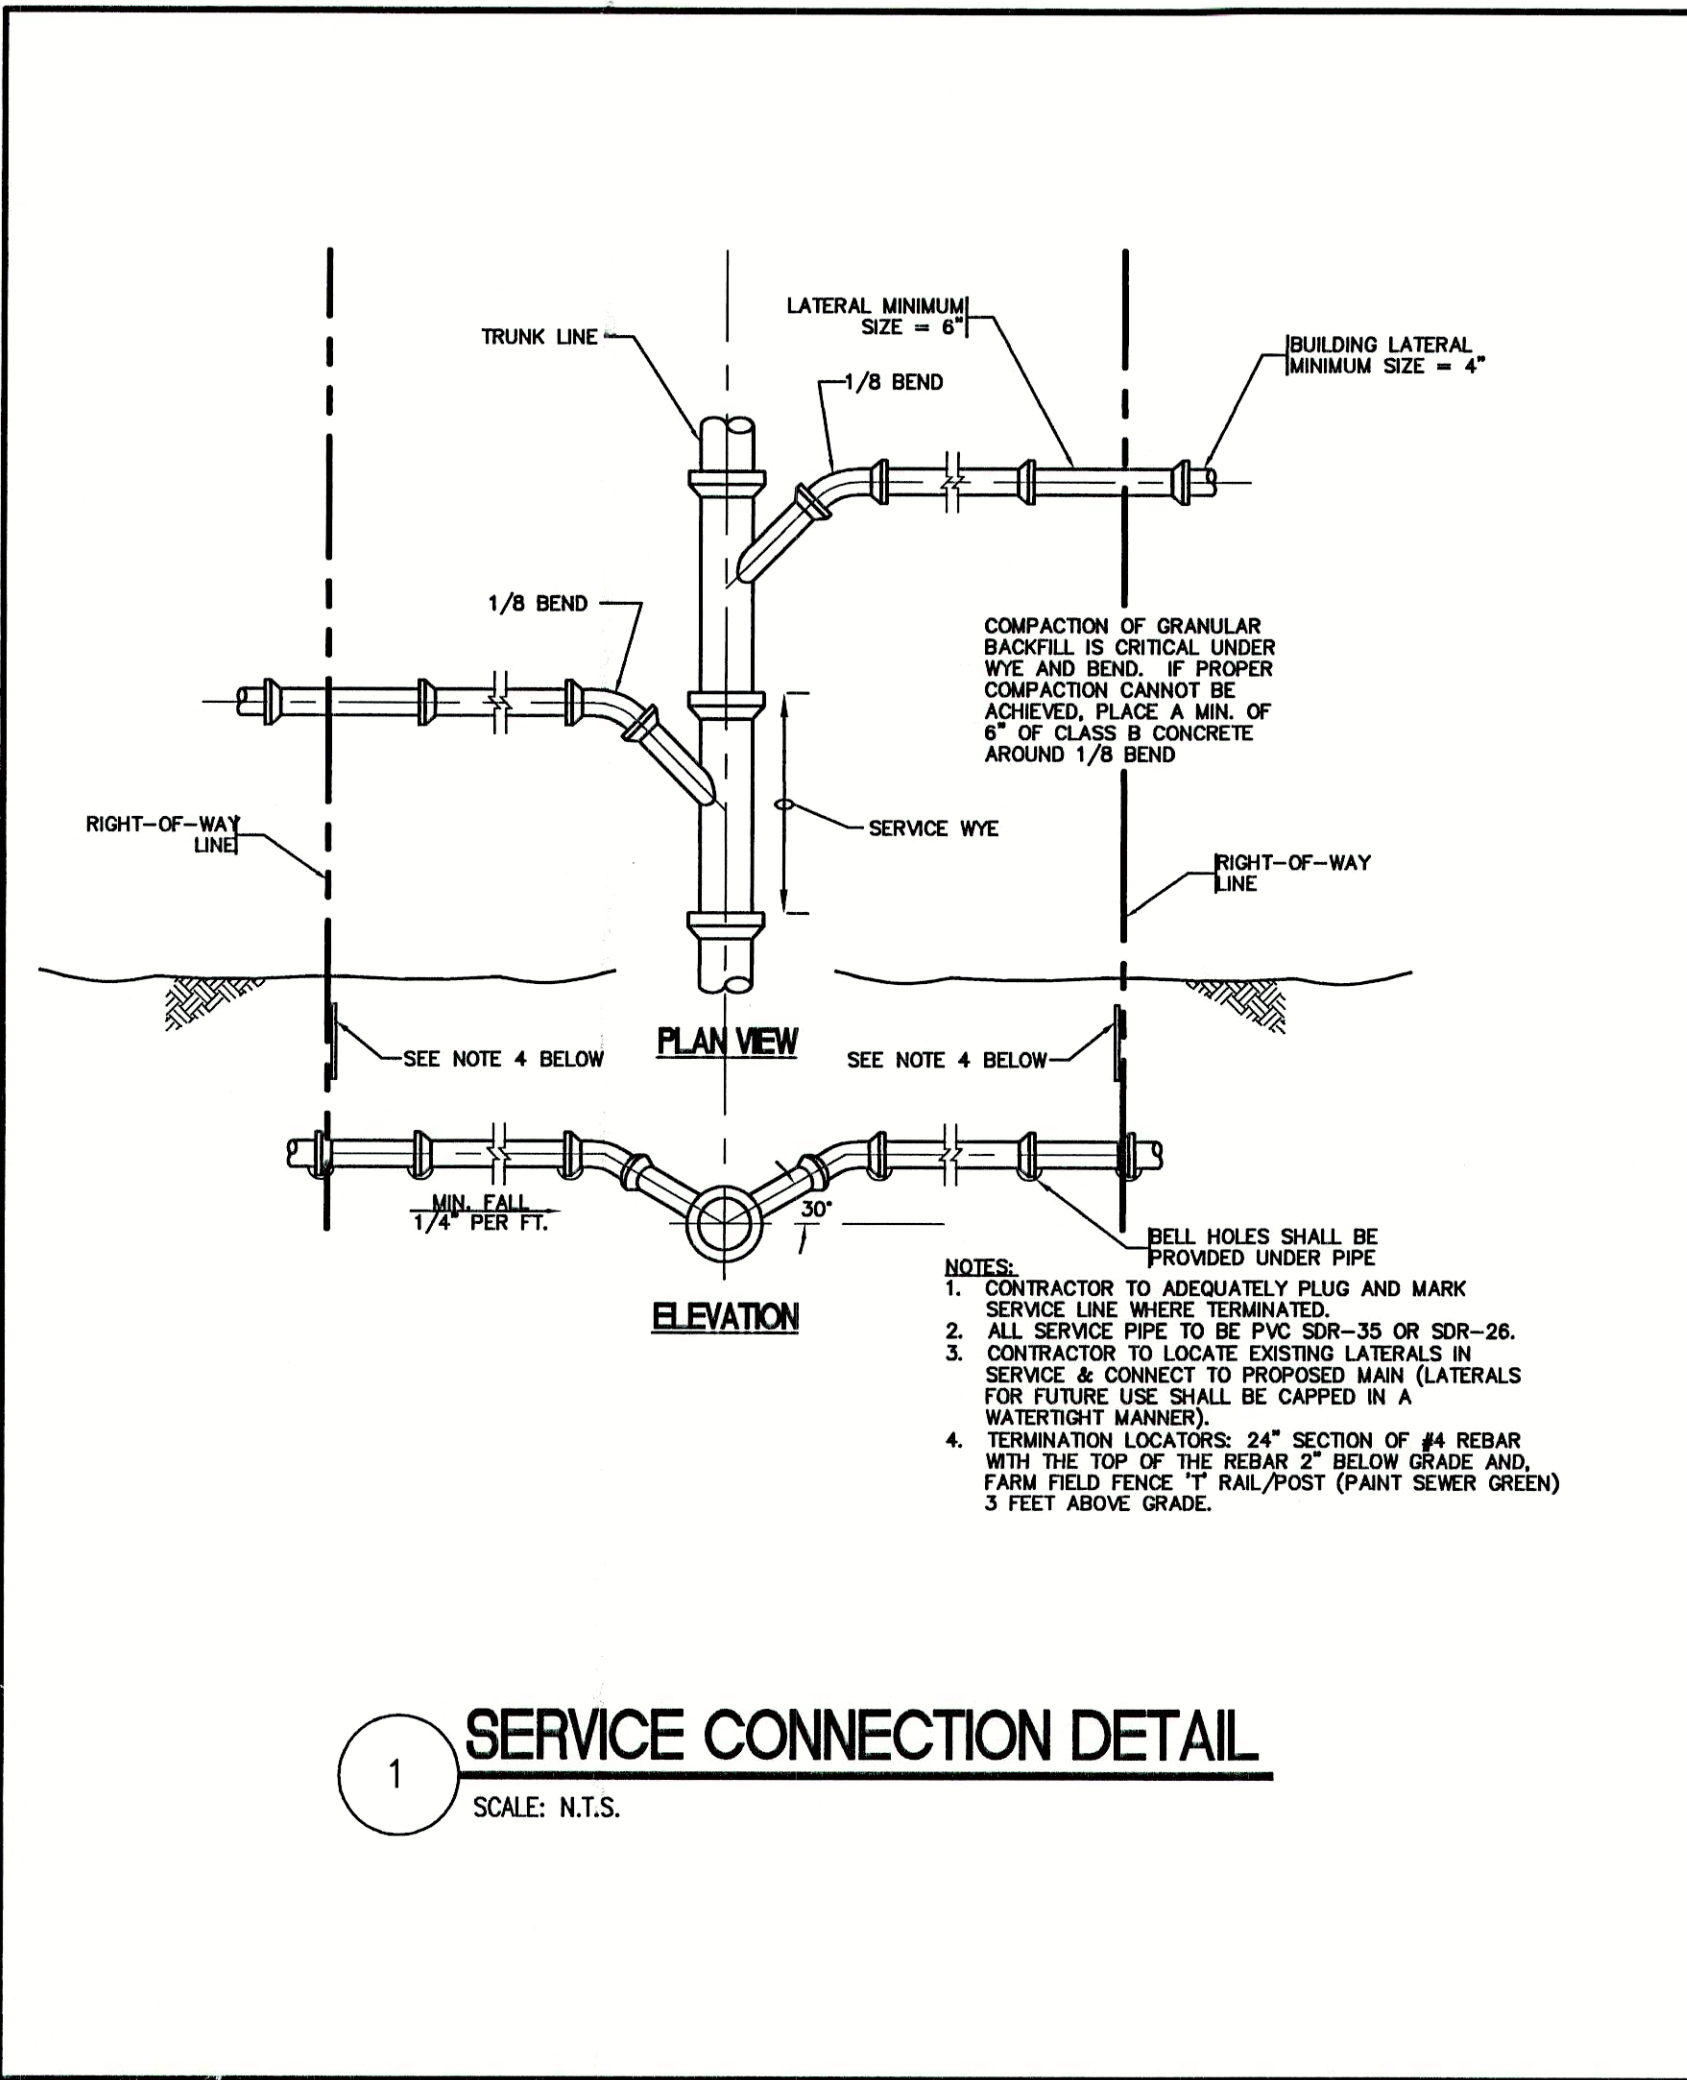
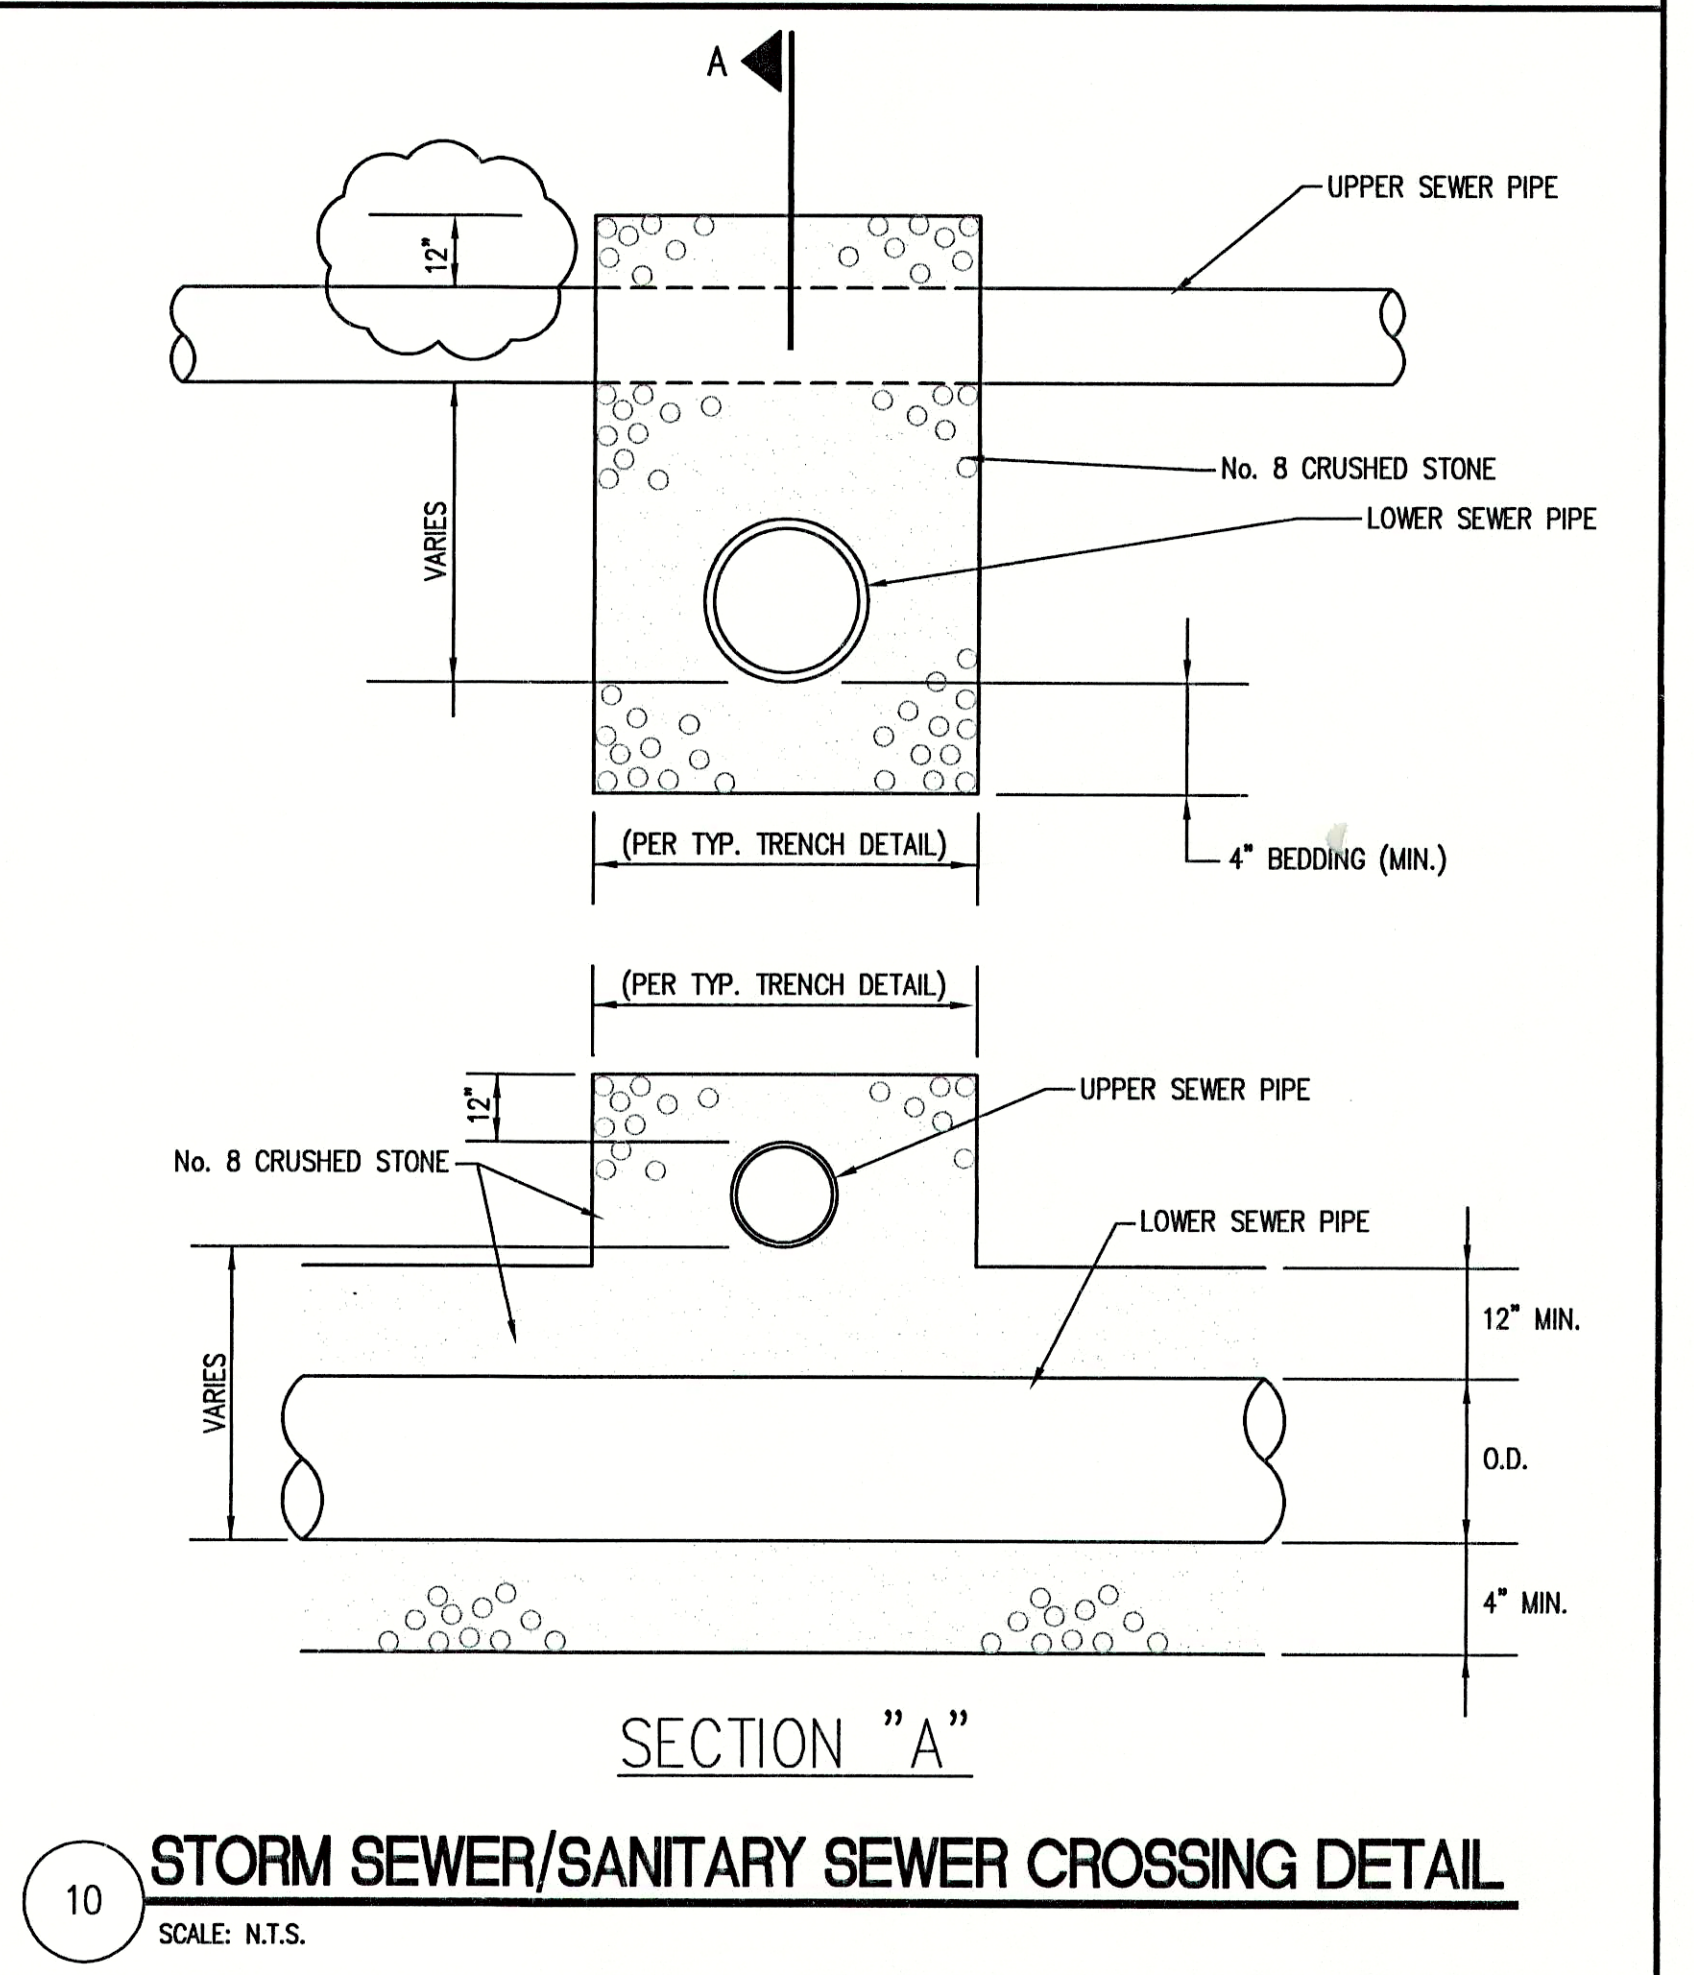
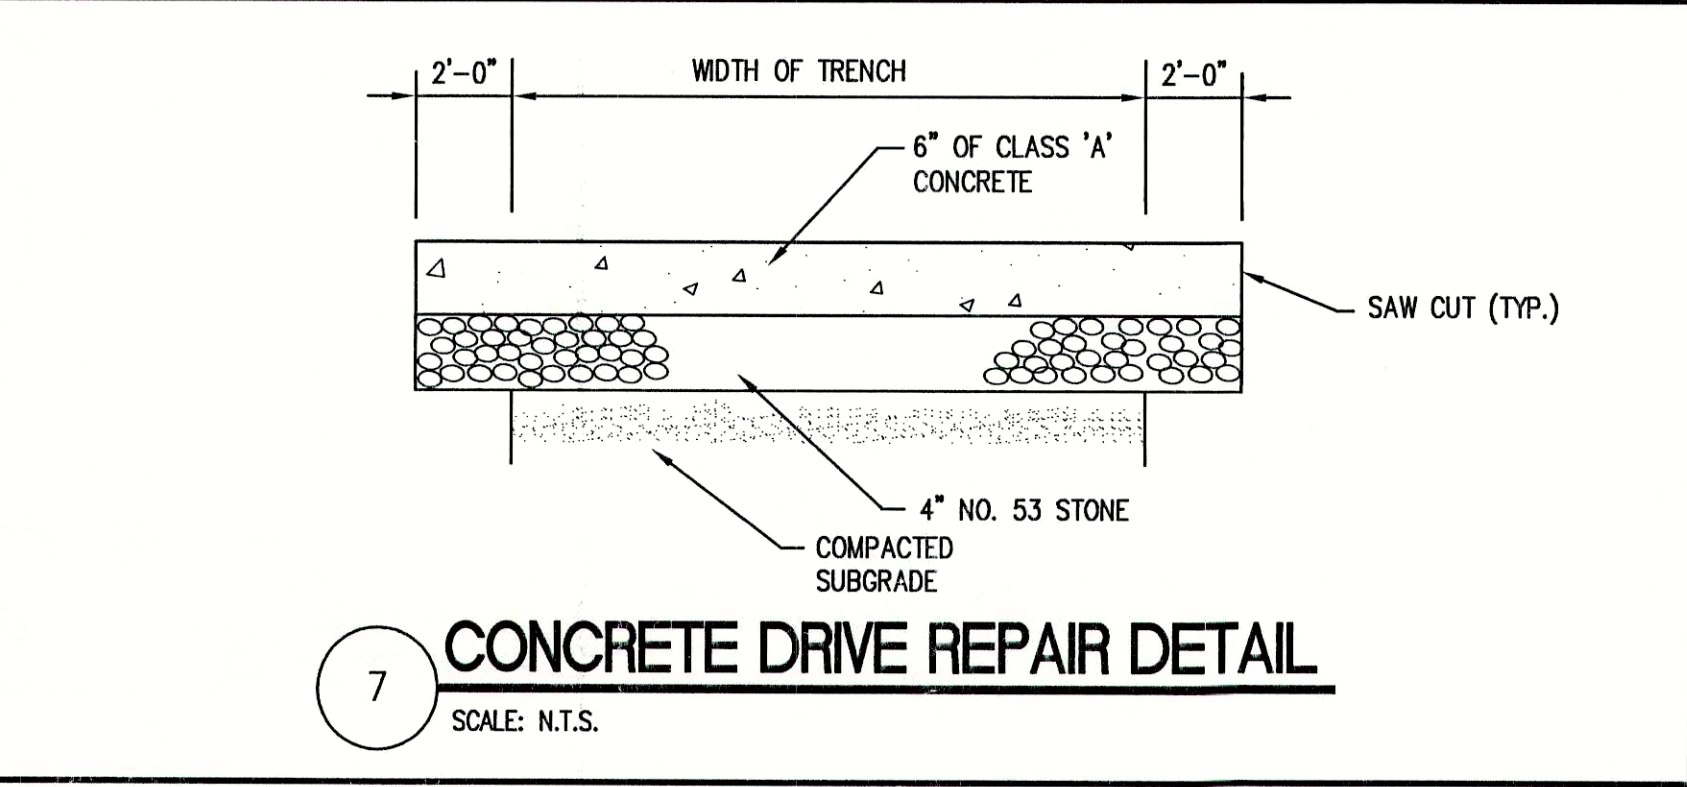
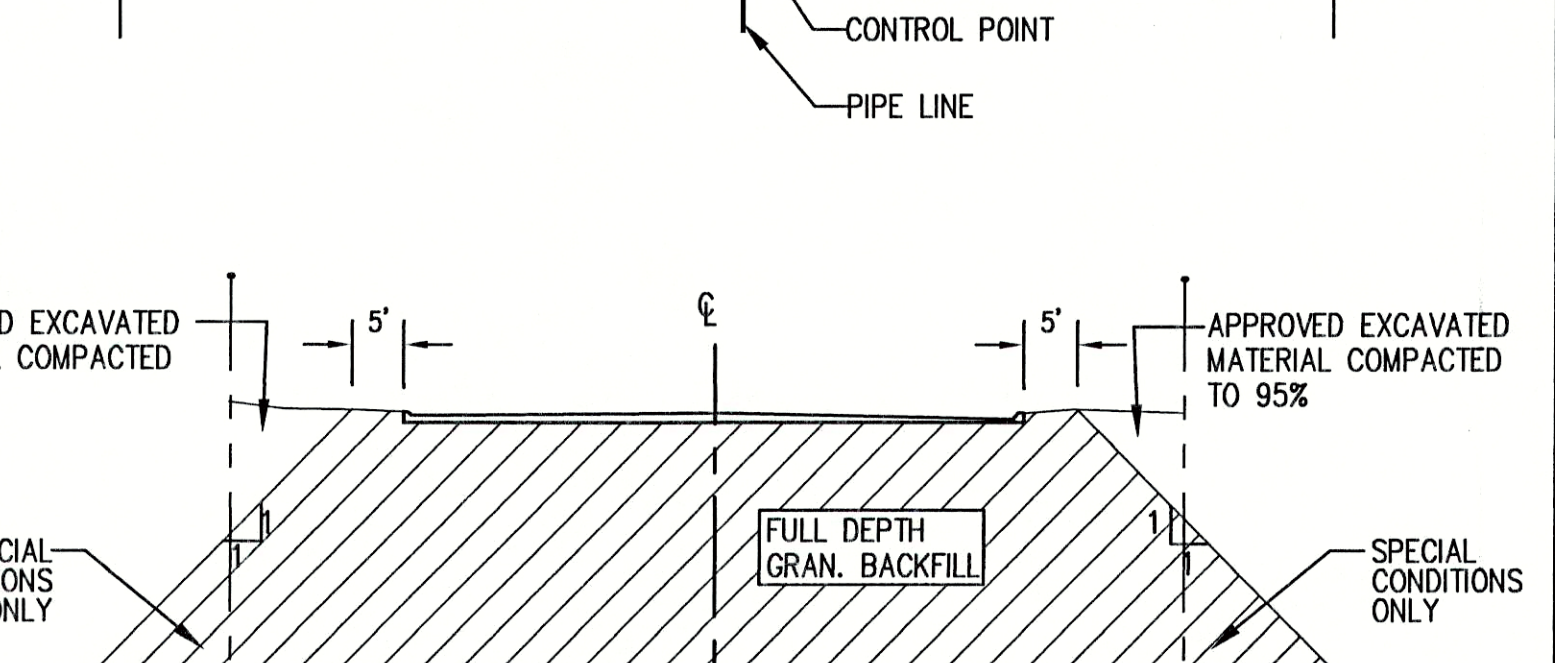
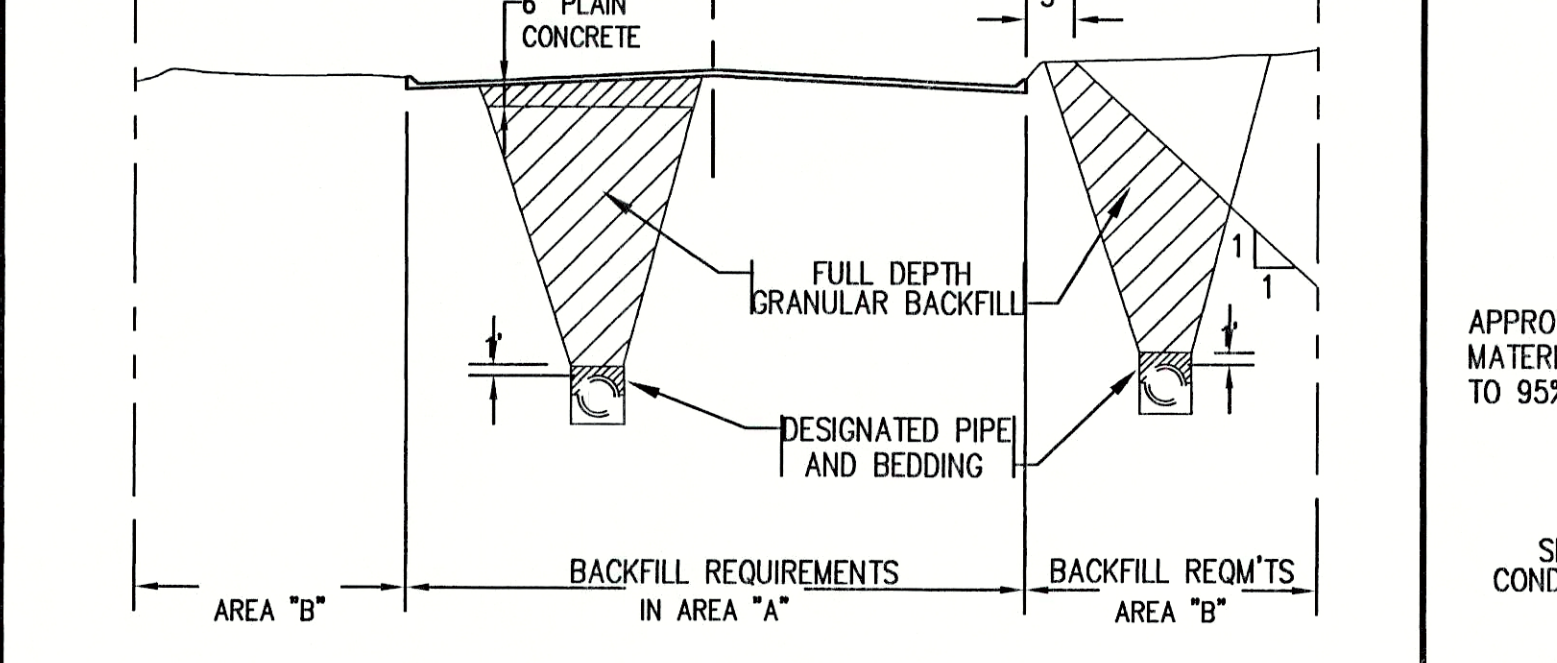
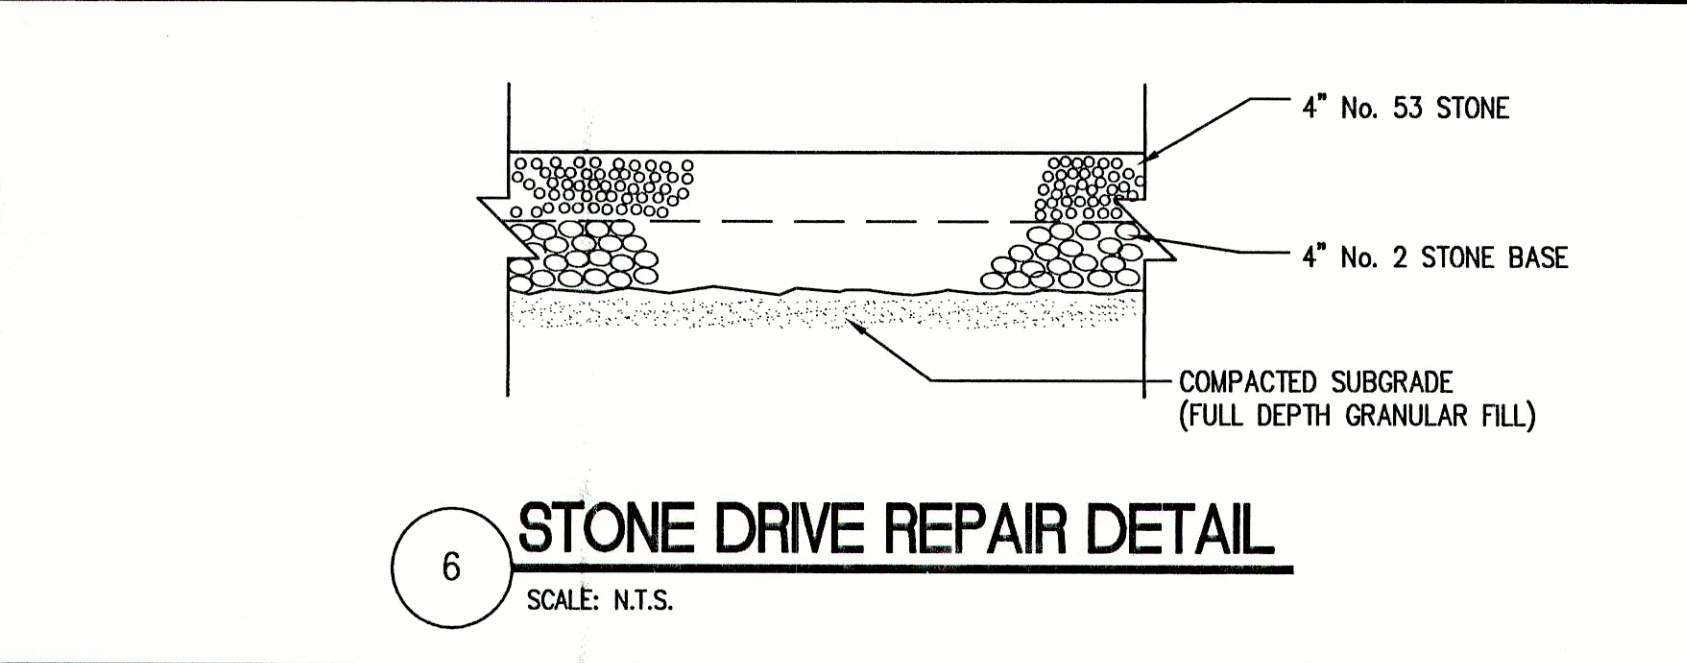
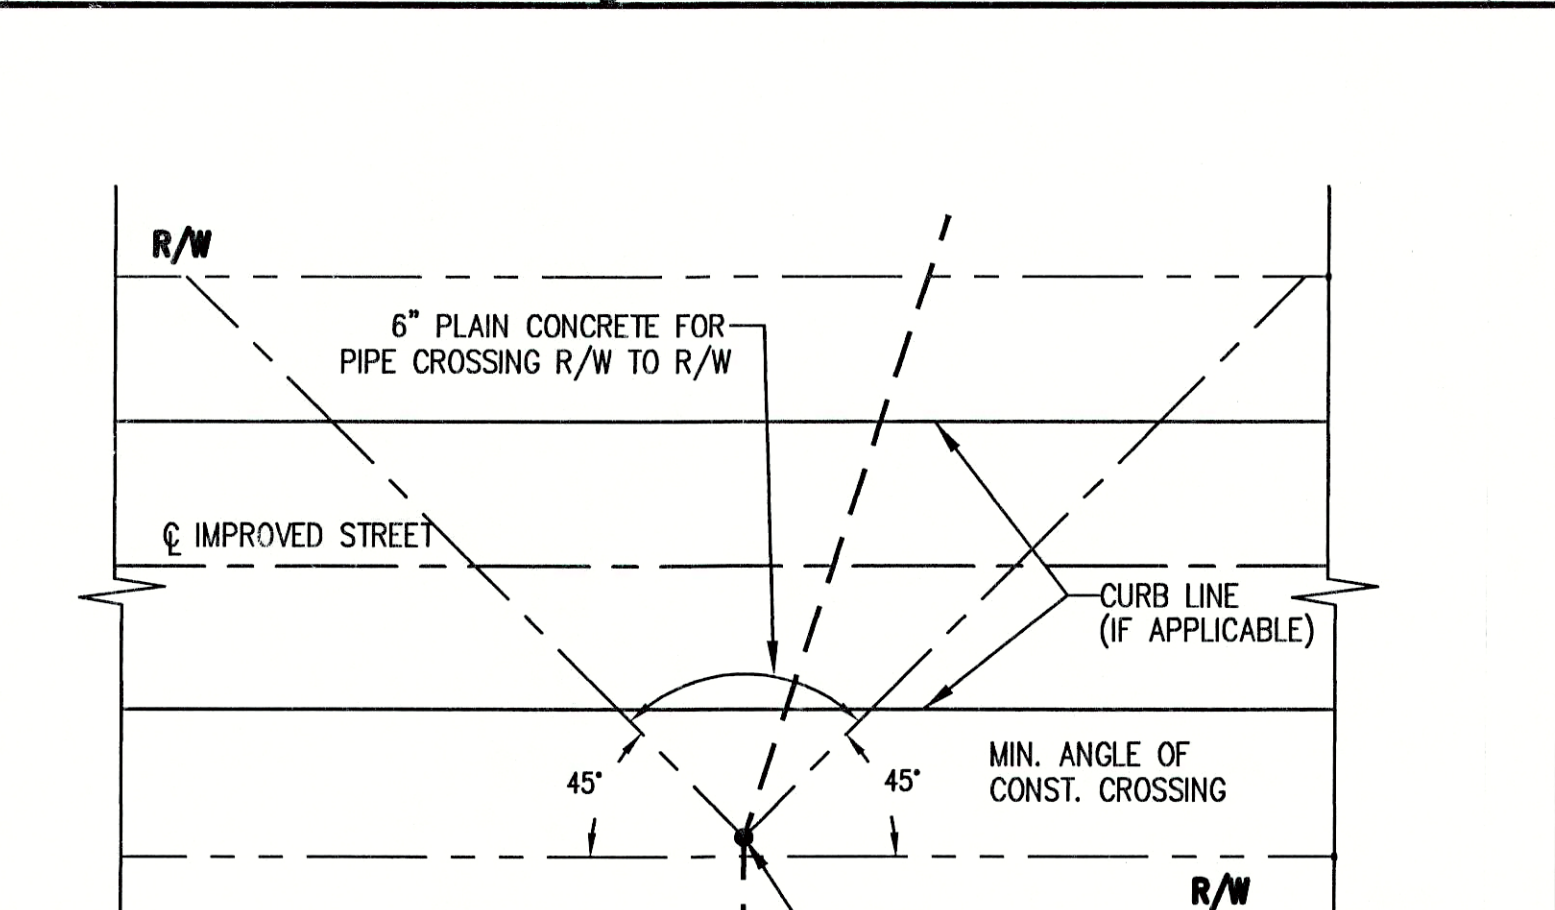


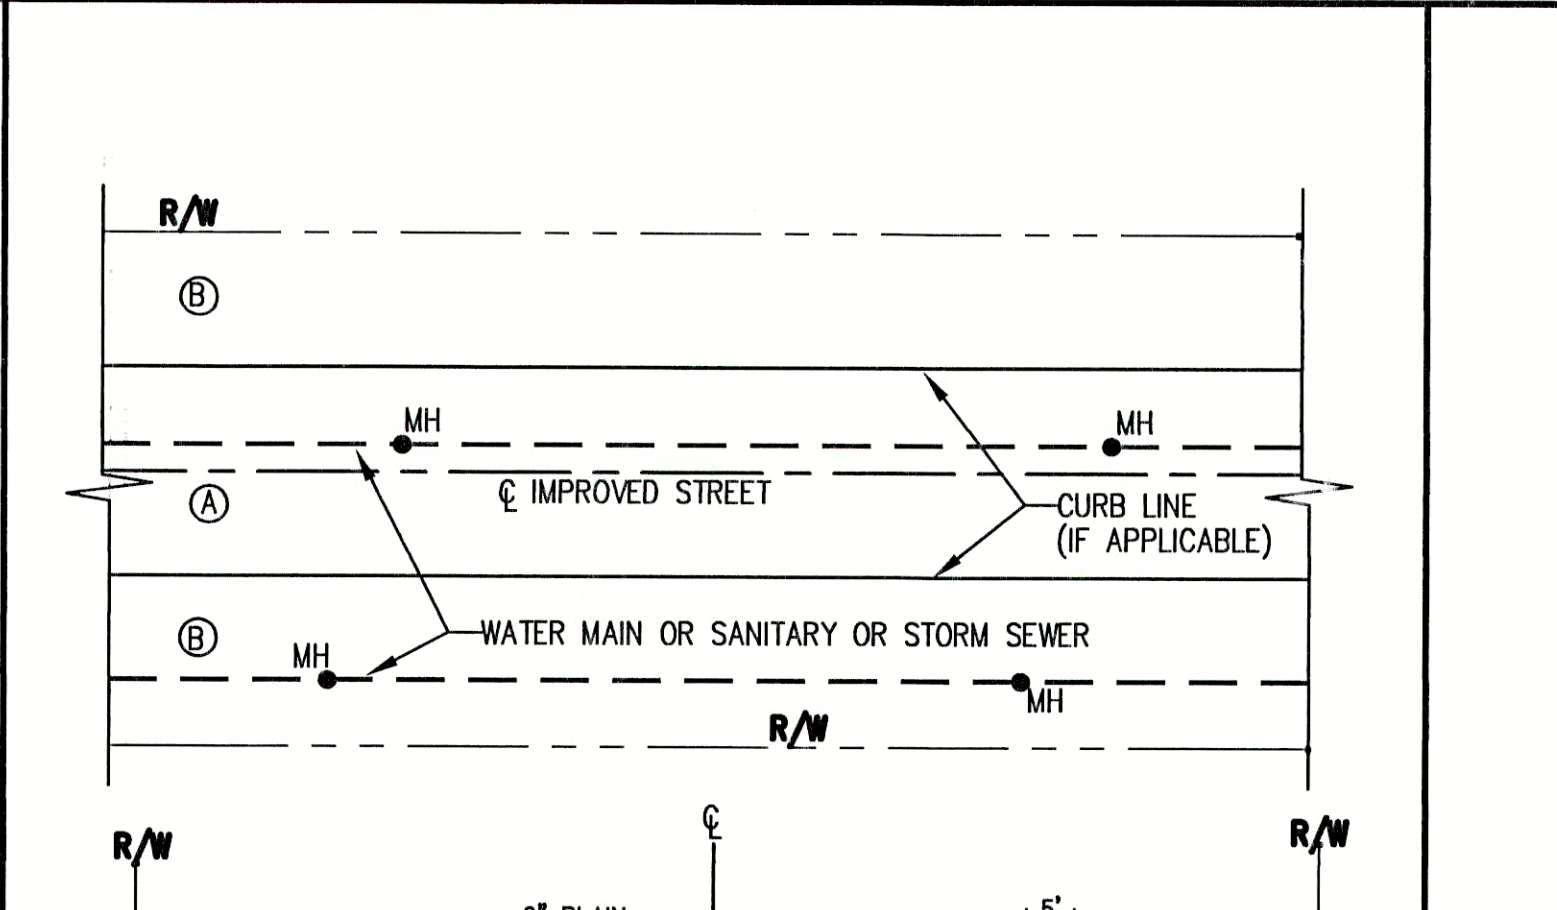

RECORD DRAWING August 23, 2001

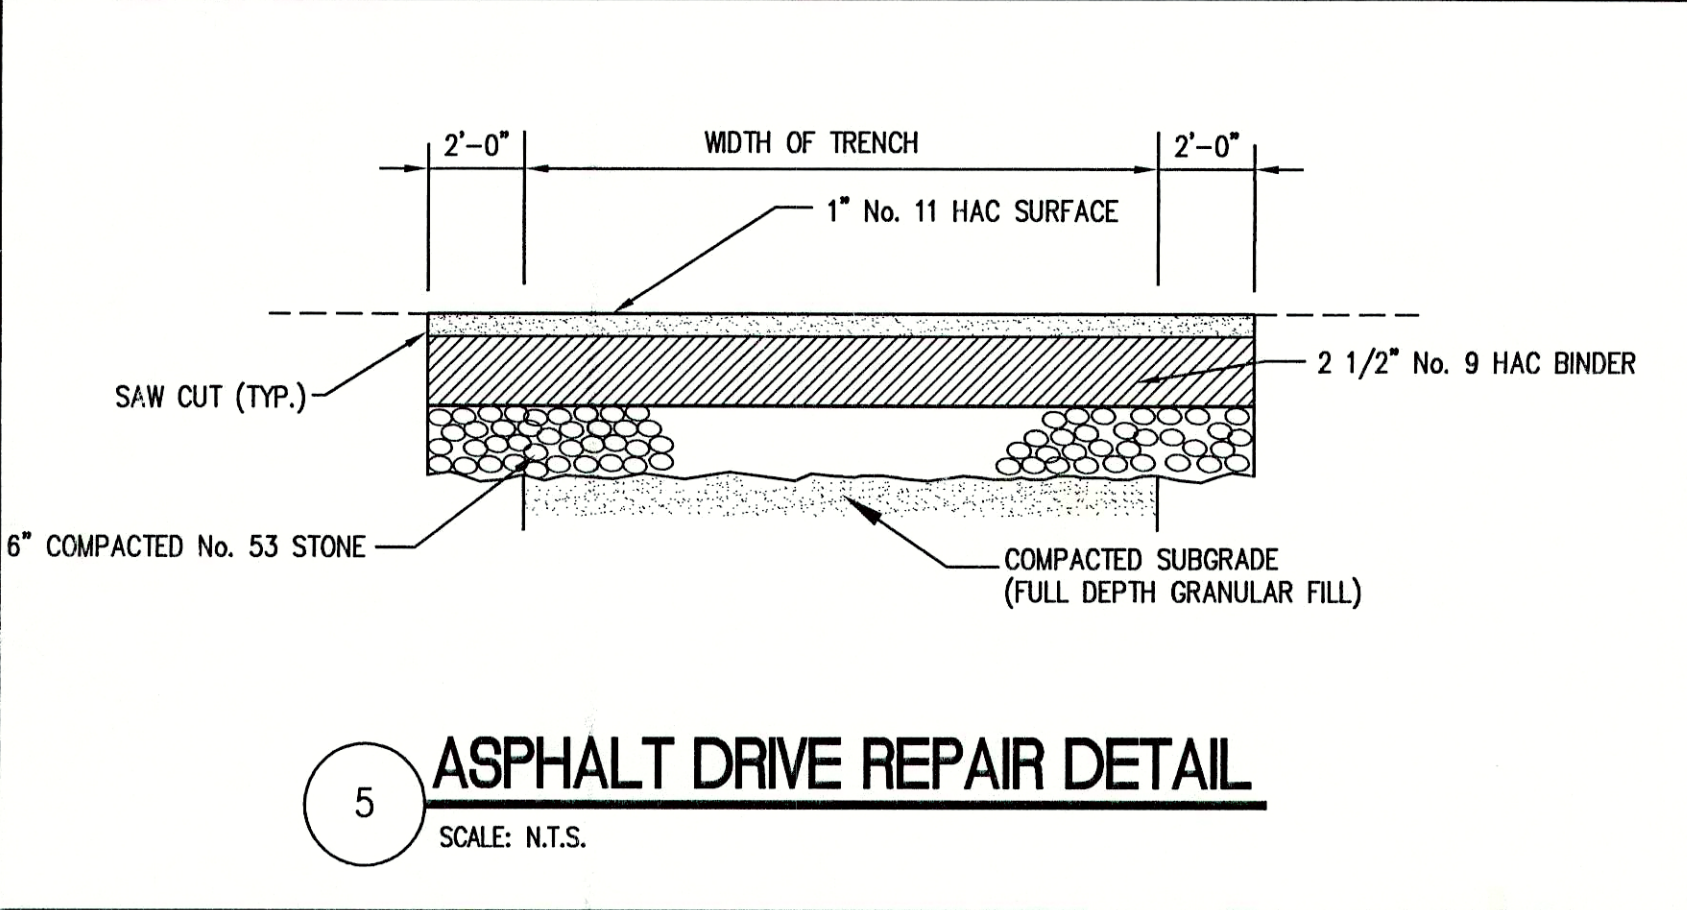

FILE NAME: SUN_DETIR-RD PLOT SCALE: 1=1 PLOT DATE: 11/06				TRIAD ASSOCIATES INC. INDIANAPOLIS, INDIANA	
APPROVED BY: THOMAS M. SCHUBERT, P.E. No. 15614 STATE OF INDIANA REGISTERED PROFESSIONAL ENGINEER				SUNVIEW, ALFONTO, REFORMATORY ROAD FALL CREEK REGIONAL WASTE DISTRICT STANDARD SANITARY SEWER DETAILS	
DRAWN BY: DAP SCALE: AS NOTED		DATE: 04/12/98 PROJECT No.: 98008A		SHEET No.: 32 OF 33	
DESIGNED BY: D.A. Pauling		CHECKED BY: James W. Frazell, P.E.		33	