

U.S. 36 FORCEMAIN REPLACEMENT

FALL CREEK REGIONAL WASTE DISTRICT - PENDLETON, INDIANA



FCRWD MEMBERS


MARK A. JABLONSKI	- PRESIDENT
MICHELLE W. PATISHALL	- VICE PRESIDENT
GREGORY L. VALENTINE	- TREASURER
DAVID K. PADGETT	- SECRETARY
STEPHEN J. BILL	- DEPUTY SECRETARY/TREASURER
TIMOTHY E. GREEN	- BOARD MEMBER
KURT L. KAHL	- BOARD MEMBER
JACK C. WEIST	- BOARD MEMBER
ALBERT B. STEWART	- BOARD MEMBER
TERESA HUTTON	- GENERAL MANAGER
STEVE UNGER	- ATTORNEY



engineering | architecture | geospatial

www.grwinc.com

This document, originally issued, sealed, and signed by Joseph P. Tierney, Indiana Professional Engineer, No. 19300407, on 7.2.2018, shall not be used in lieu of a certified document.

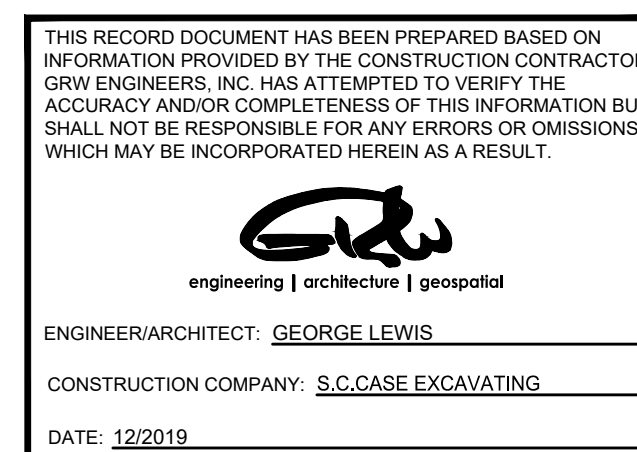

This document, originally issued, sealed, and signed by George W. Lewis, Indiana Professional Engineer, No. 10403303, on 7.2.2018, shall not be used in lieu of a certified document.

JOSEPH P. TIERNEY, P.E.
INDIANA REG. NO. 19300407

DATE: 7/2/2018

GEORGE W. LEWIS, P.E.
INDIANA REG. NO. 10403303

DATE: 7/2/2018

JULY 2018



SCALE: 1" = 2,000'

PLAN SET IS FULL SCALE ON 24"X36"
AND HALF SCALE ON 12"X18"

FALL CREEK REGIONAL WASTE DISTRICT
DISTRICT OFFICE
9378 COUNTY ROAD SOUTH 650 WEST
PENDLETON, INDIANA 46064

GRW PROJECT NO. 4635
SRF PROJECT NO. WW 16 07 48 03

RECORD DRAWINGS