



FILE NAME: G:\4635-FCRWD-US 36\Working Drawings\AutoCAD\4635-C-04.dwg
PRINTED: 12/19/2019 @ 4:46PM
PLOTTED BY: Johnson

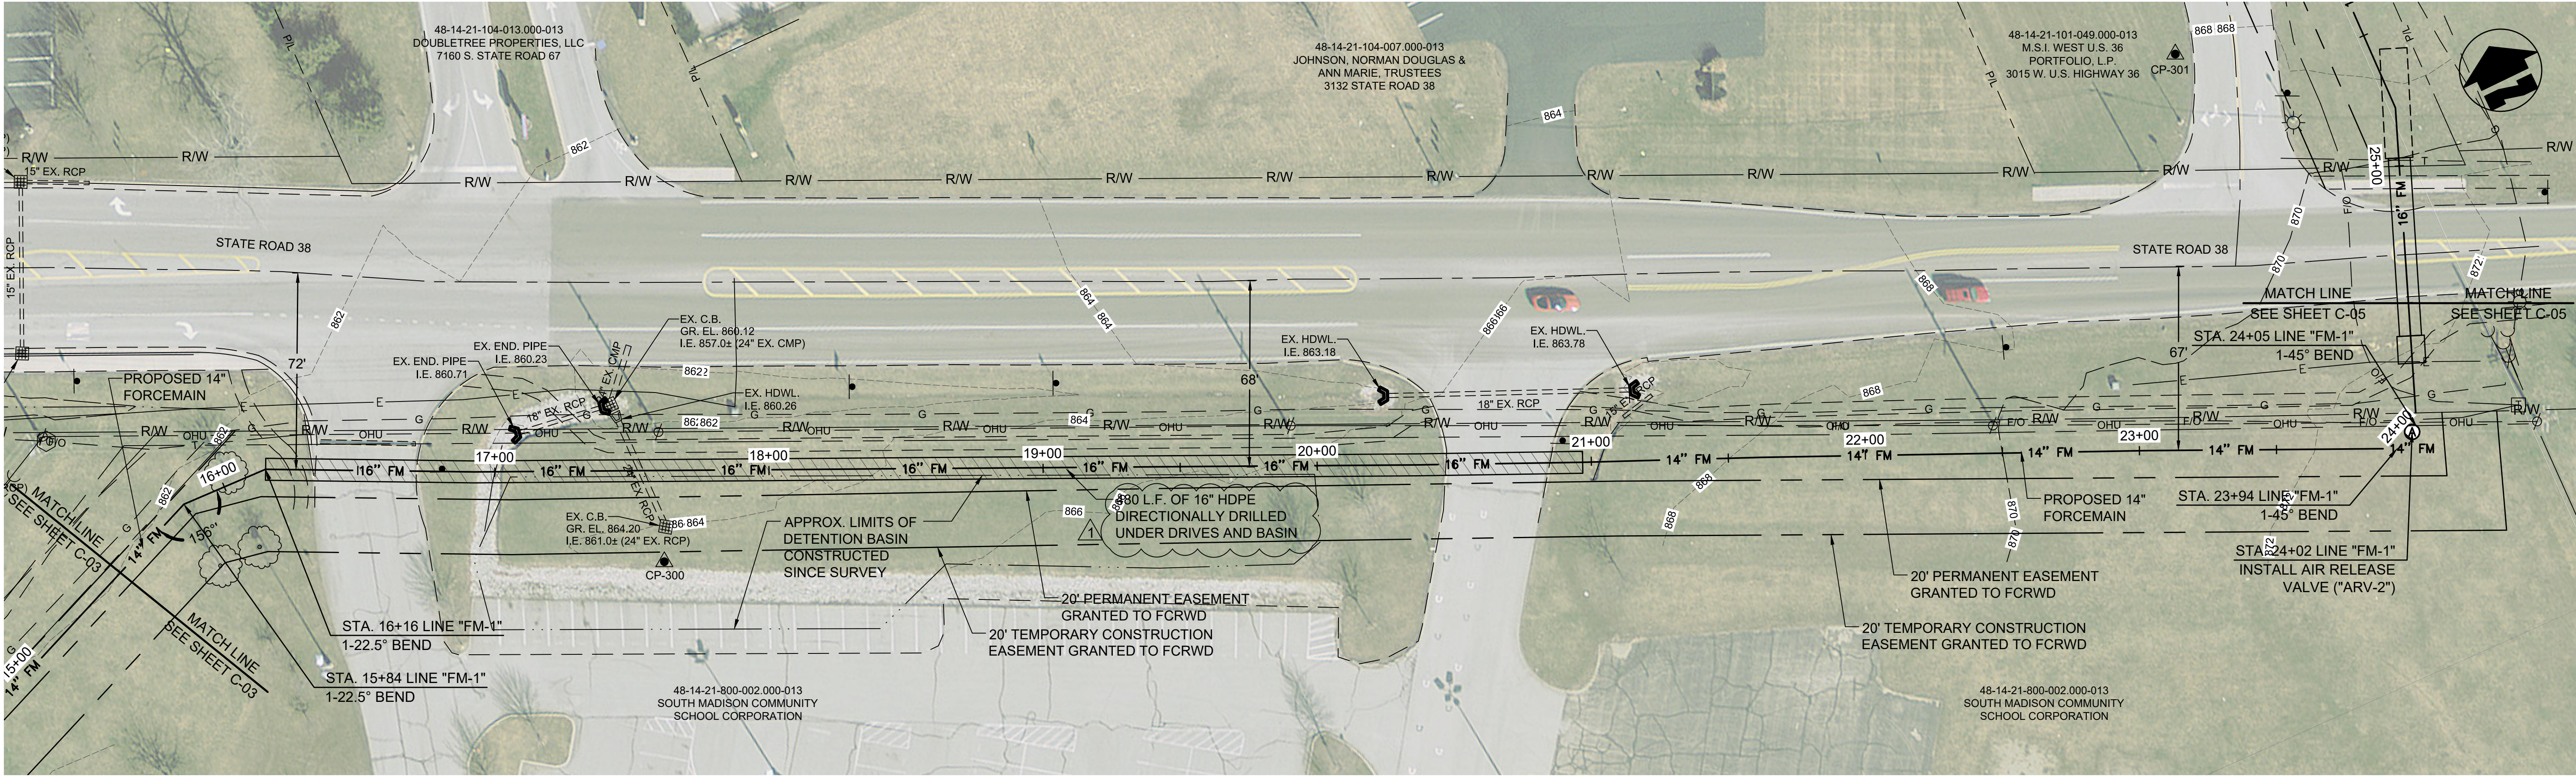

PLAN VIEW - STA. 15+50 TO STA. 24+50 LINE "FM-1"

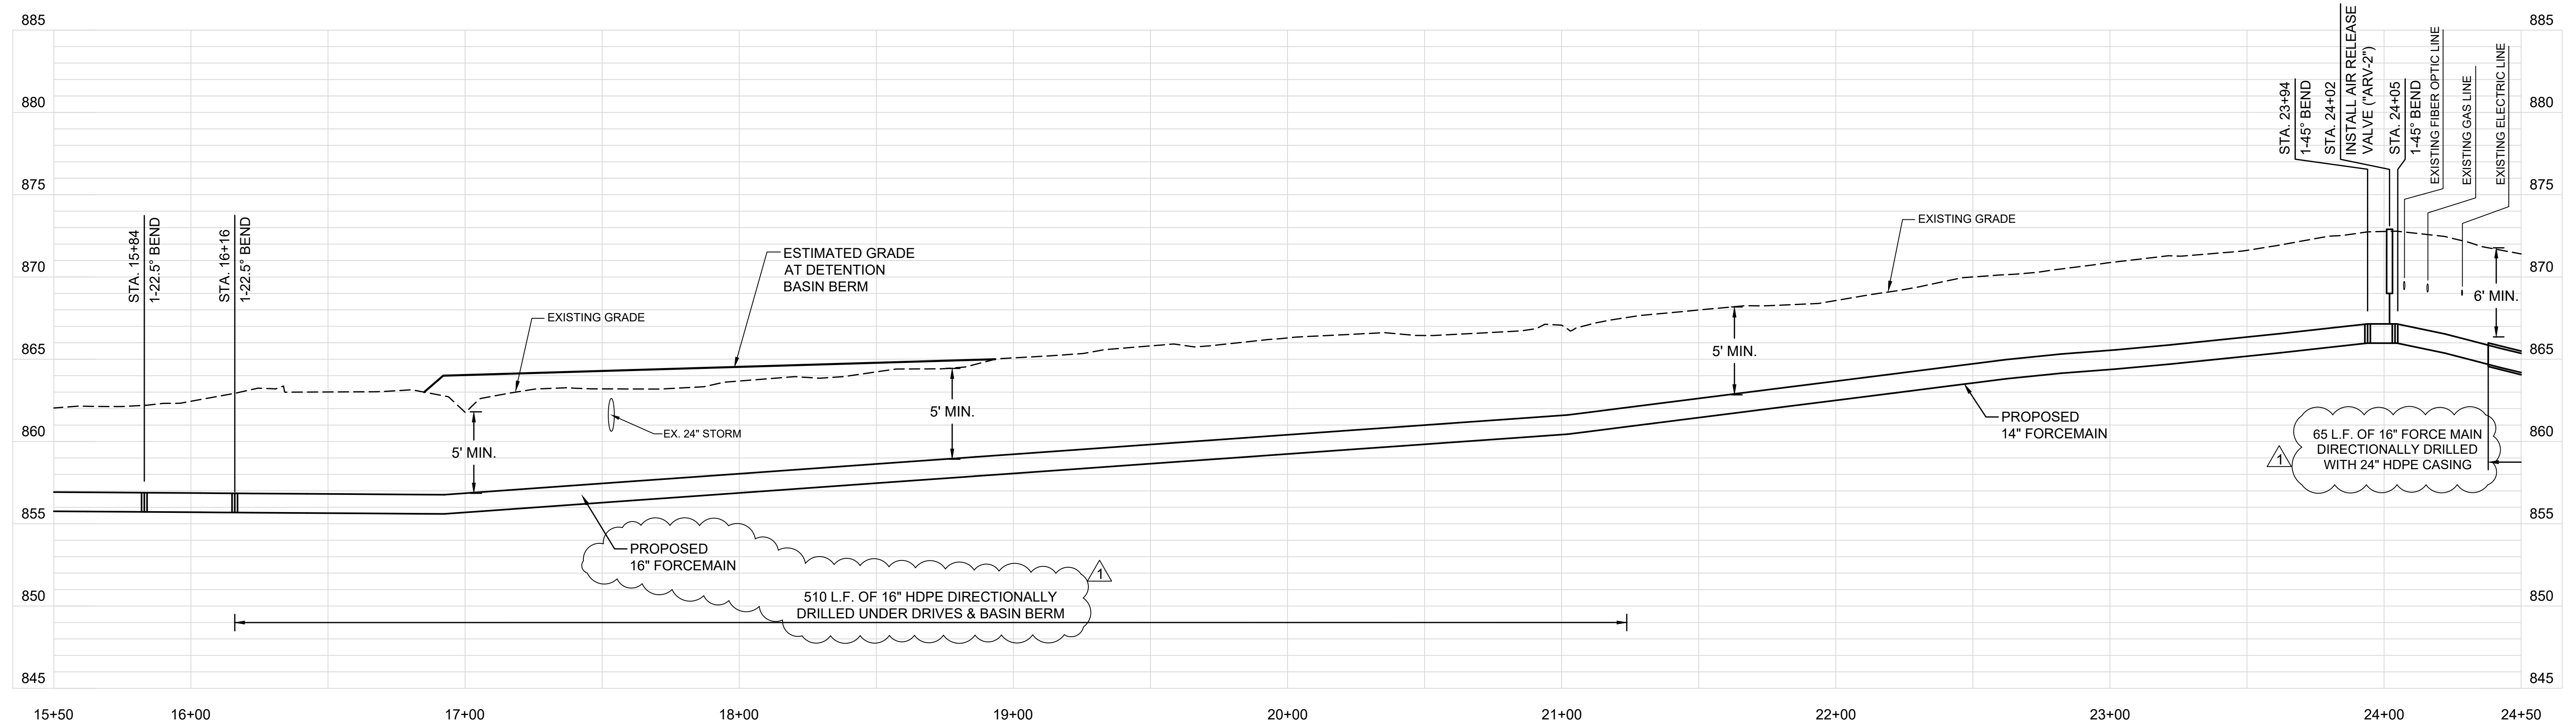


PROFILE - STA. 15+50 TO STA. 24+50 LINE "FM-1"

THIS RECORD DOCUMENT HAS BEEN PREPARED BASED ON INFORMATION PROVIDED BY THE CONSTRUCTION CONTRACTOR. GRW ENGINEERS, INC. HAS ATTEMPTED TO VERIFY THE ACCURACY AND/OR COMPLETENESS OF THIS INFORMATION BUT SHALL NOT BE RESPONSIBLE FOR ANY ERRORS OR OMISSIONS WHICH MAY BE INCORPORATED HEREIN AS A RESULT.

GRW
engineering | architecture | geospatial

ENGINEER/ARCHITECT: GEORGE LEWIS
CONSTRUCTION COMPANY: S.C. CASE EXCAVATING
DATE: 12/2019

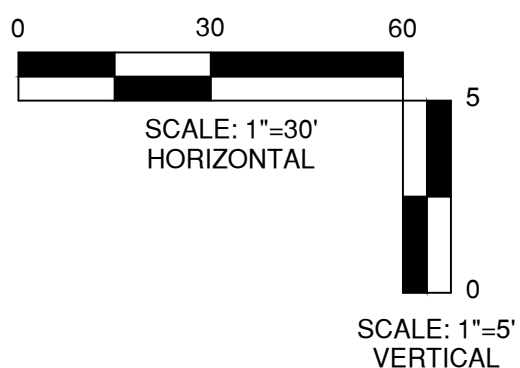

This document, originally issued, sealed, and signed by George W. Lewis, Indiana Professional Engineer, No. 10403303, on 7.2.2018, shall not be used in lieu of a certified document.

GRW PROJECT NO. 4635

CLIENT PROJECT NO. -

ALL RIGHTS RESERVED. THIS DOCUMENT IS THE PROPERTY OF GRW ENGINEERS, INC. AND SHALL BE REPRODUCED IN WHOLE OR IN PART WITHOUT WRITTEN PERMISSION.

GRW
engineering | architecture | geospatial
www.grwinc.com

PLAN AND PROFILE
LINE "FM-1"
US 36 FORCEMAIN REPLACEMENT
TOWN OF PENDLETON, INDIANA

DESIGNED:	GWL
DRAWN:	JRD
REVIEWED:	GWL
APPROVED:	GWL

REVISIONS

NO.	DATE	DESCRIPTION
1	9-18	PIPE SIZE REVISION

DATE: **JULY 2018**
SCALE: **1"=30'**
SHEET NO. **C-04**