



PROFILE - STA. 24+50 TO STA. 30+50 LINE "FM-1"

NOTE:

INSTALL FORCEMAIN ON EVEN GRADE TO PREVENT HIGH POINT

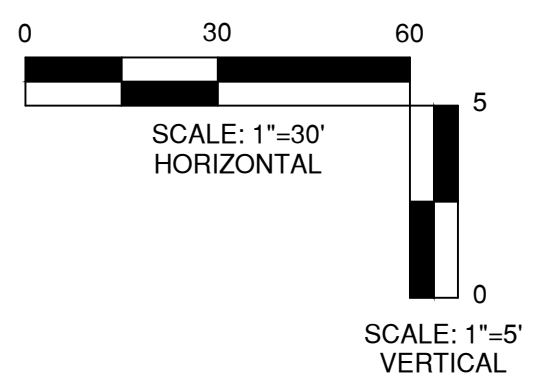

THIS RECORD DOCUMENT HAS BEEN PREPARED BASED ON INFORMATION PROVIDED BY THE CONSTRUCTION CONTRACTOR GWS ENGINEERS, INC. HAS ATTEMPTED TO VERIFY THE ACCURACY AND/OR COMPLETENESS OF THIS INFORMATION BUT SHALL NOT BE RESPONSIBLE FOR ANY ERRORS OR OMISSIONS WHICH MAY BE INCORPORATED HEREIN AS A RESULT.

  
engineering | architecture | geospatial

ENGINEER/ARCHITECT: GEORGE LEWIS

CONSTRUCTION COMPANY: S.C.CASE EXCAVATING

DATE: 12/2019

This document, originally issued, sealed, and signed by George W. Lewis, Indiana Professional Engineer, No. 10403303, on 7.2.2018, shall not be used in lieu of a certified document.

GRW PROJECT NO. 4635

CLIENT PROJECT NO. --

ALL RIGHTS RESERVED:  
THIS DOCUMENT IS THE PROPERTY OF  
GRW ENGINEERS, INC. AND SHALL NOT  
BE REPRODUCED IN WHOLE OR IN PART  
OR USED FOR CONSTRUCTION OF  
OTHER THAN THIS SPECIFIC PROJECT  
WITHOUT WRITTEN PERMISSION



engineering | architecture | geospatial

[www.grwinc.com](http://www.grwinc.com)

# PLAN AND PROFILE LINE "FM-1" US 36 FORCEMAIN REPLACEMENT TOWN OF PENDLETON, INDIANA

REVISIONS				DESIGNED:	GWL
NO.	DESCRIPTION	DATE	BY	DRAWN	JRD
1	PIPE SIZE REVISION	9-18	GWL		
					REVIEWED:
					GWL
					APPROVED:
SCALE CHECK: <input type="checkbox"/> THIS MARK SHOULD MEASURE EXACTLY 1" WHEN PLOTTED				GWL	

DATE: JULY 2018

SCALE: 1"=30'

SHEET NO. \_\_\_\_\_