

WHITE OAKS ADDITION SANITARY SEWER PROJECT

PROJECT FOR THE FALL CREEK REGIONAL WASTE DISTRICT MADISON CO., IN.

1999

SRF PROJECT NO. CS 18207701

DIVISION II

CONTRACT 'A-1'

JOE ROWLETT - GENERAL MANAGER

FALL CREEK REGIONAL WASTE DISTRICT BOARD

Mr. Morris McCurdy - President
Mr. Doug McGee - Member
Mr. Mark Jablonski - Member
Mr. Agon Tolbert - Member
Mr. Dallas Foster - Member
Mr. Jack Kasdorf - Member
Mr. Timothy Green - Member
Mr. John Ellingwood - Member
Mr. Ed Stergar - Member
Mr. Joe Rowlett - General Manager

ATTORNEY

Mr. Chris Janak

MADISON COUNTY COMMISSIONERS

Mr. Paul Wilson
Mr. Otis E. Cox
Ms. Sandra S. Huntzinger

AUDITOR

Ms. Patricia Dillion


ATTORNEY

Mr. Gerald Shine

SHEET INDEX


<u>SHEET NO.</u>	<u>DESCRIPTION</u>
1	TITLE SHEET AND INDEX
2	PROJECT BASE MAP
3-9	PLAN AND PROFILE SHEETS
10-11	SANITARY SEWER DETAILS

AREA MAP

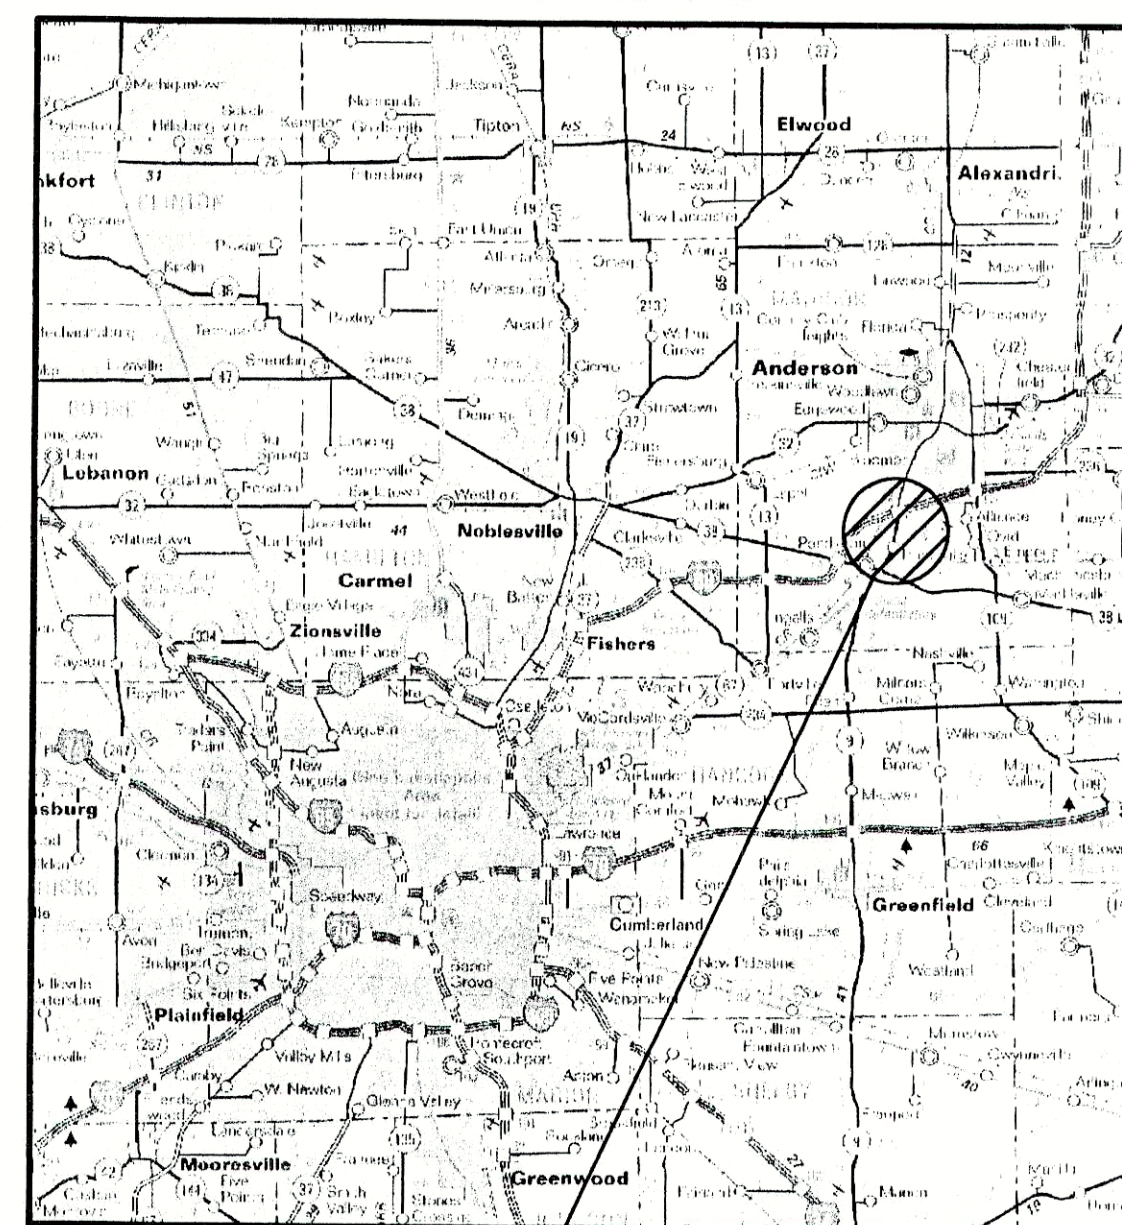

AREA
LOCATION

LOCATION MAP

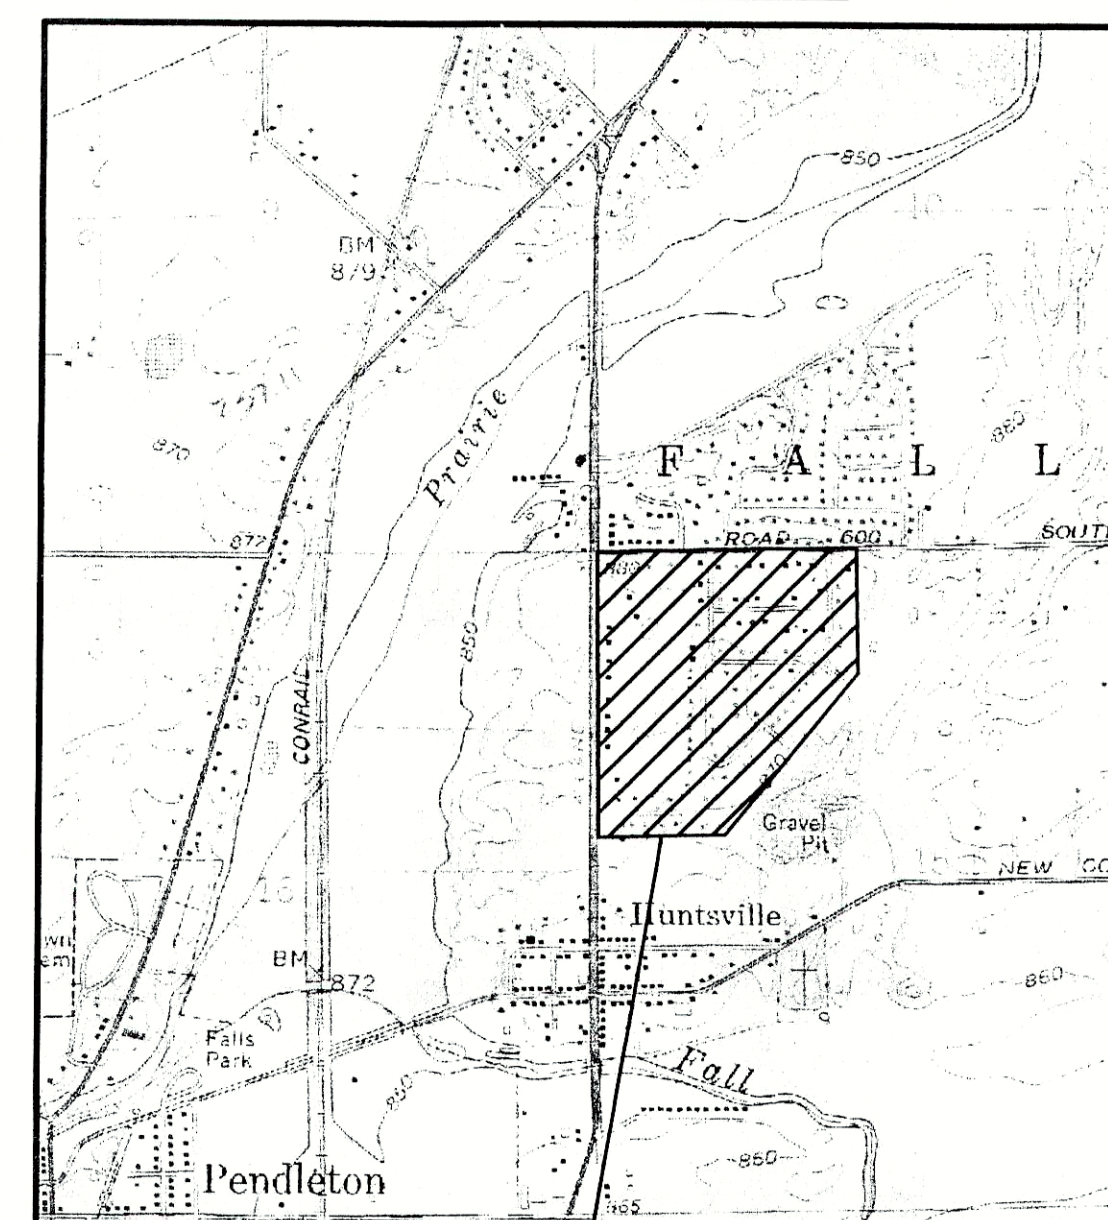

PROJECT
LOCATION

PLANS PREPARED BY:

**TRIAD
ASSOCIATES
INC.**
INDIANAPOLIS, INDIANA

NOTE:
ADDITIONAL RIGHT-OF-WAY OR EASEMENTS MAY
NEED TO BE ACQUIRED FOR INSTALLATION OF SEWER.



DON'T DIG BLIND
CALL BEFORE YOU DIG
1-800-362-5544
1-800-428-5200

PER INDIANA STATE LAW IS-69-1991, IT IS
AGAINST THE LAW TO EXCAVATE WITHOUT
NOTIFYING THE UNDERGROUND LOCATION SERVICE
TWO (2) WORKING DAYS BEFORE COMMENCING WORK.
NOTE: CONTRACTOR TO VERIFY ALL UTILITY LOCATIONS
PRIOR TO THE START OF CONSTRUCTION

THESE PLANS CERTIFIED BY:

James W. Frazell, Professional Engineer

RECORD DRAWING

February 15, 2001

Thomas M. Schubert, Professional Engineer

