

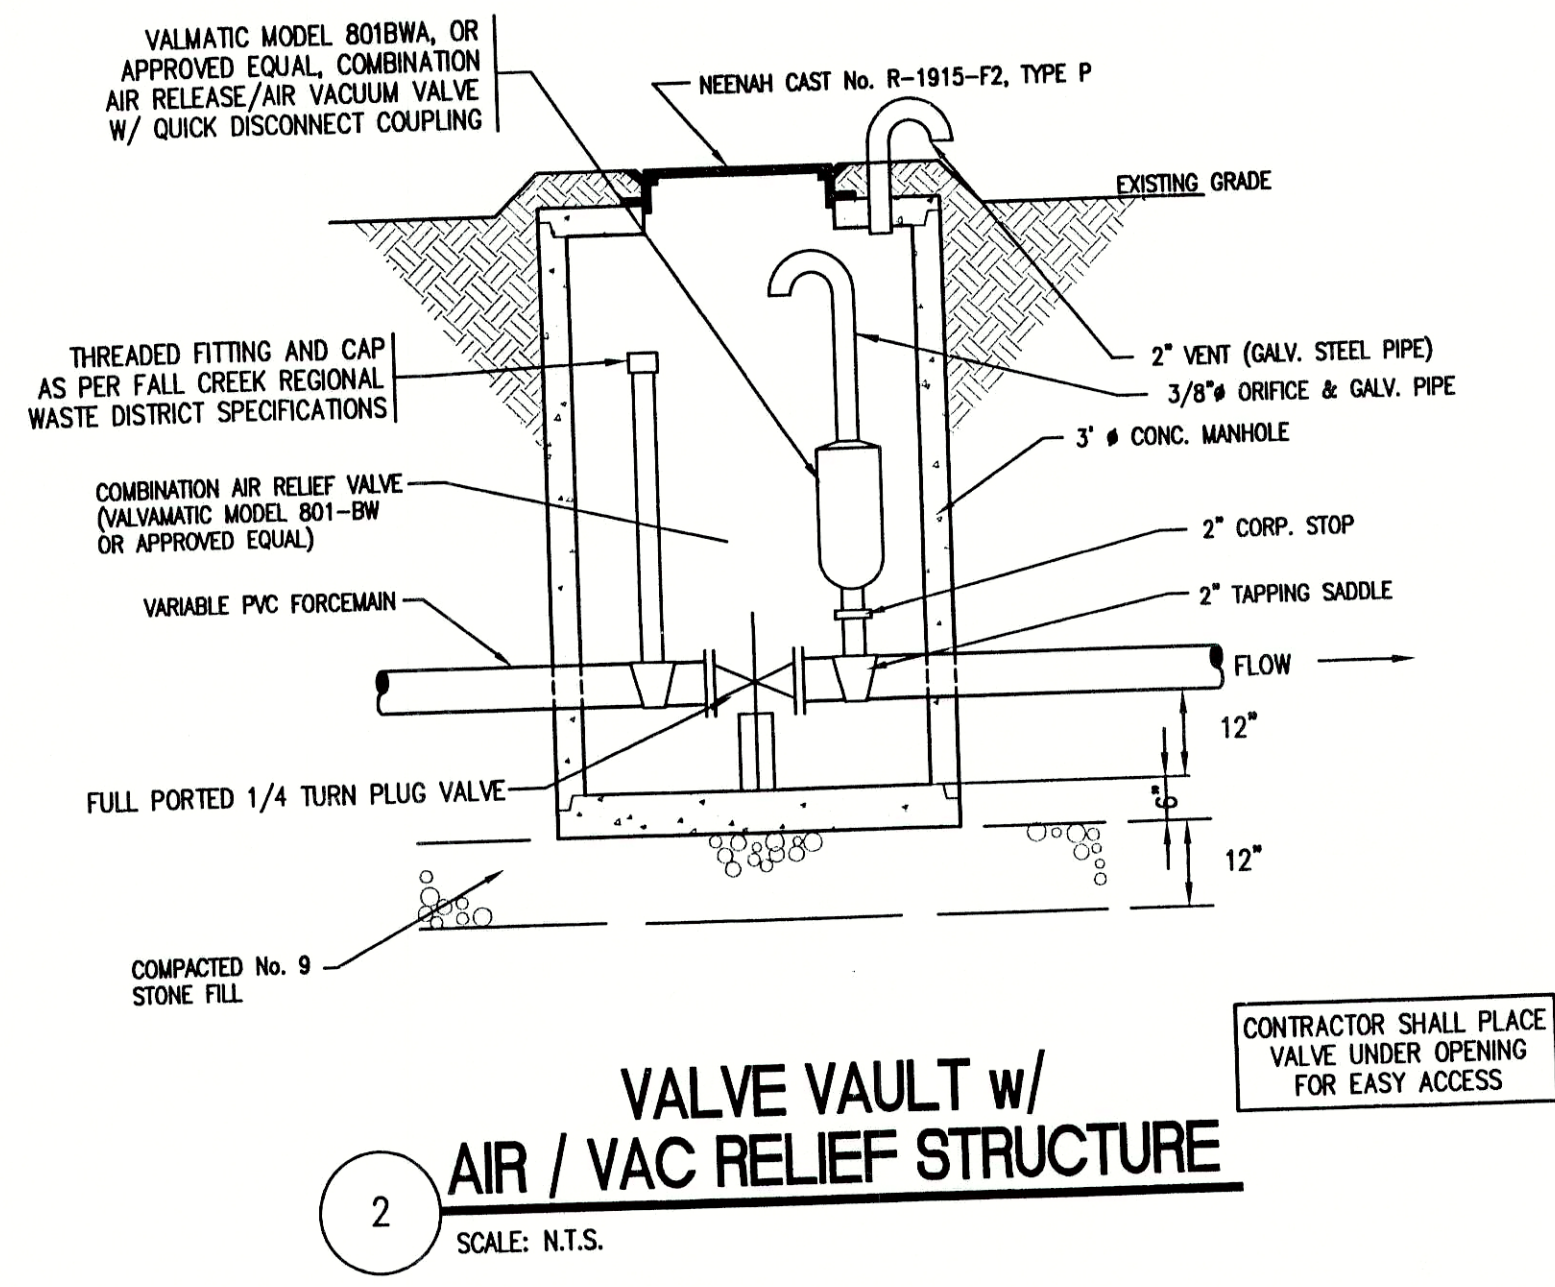


**RECORD DRAWING**  
February 15, 2001

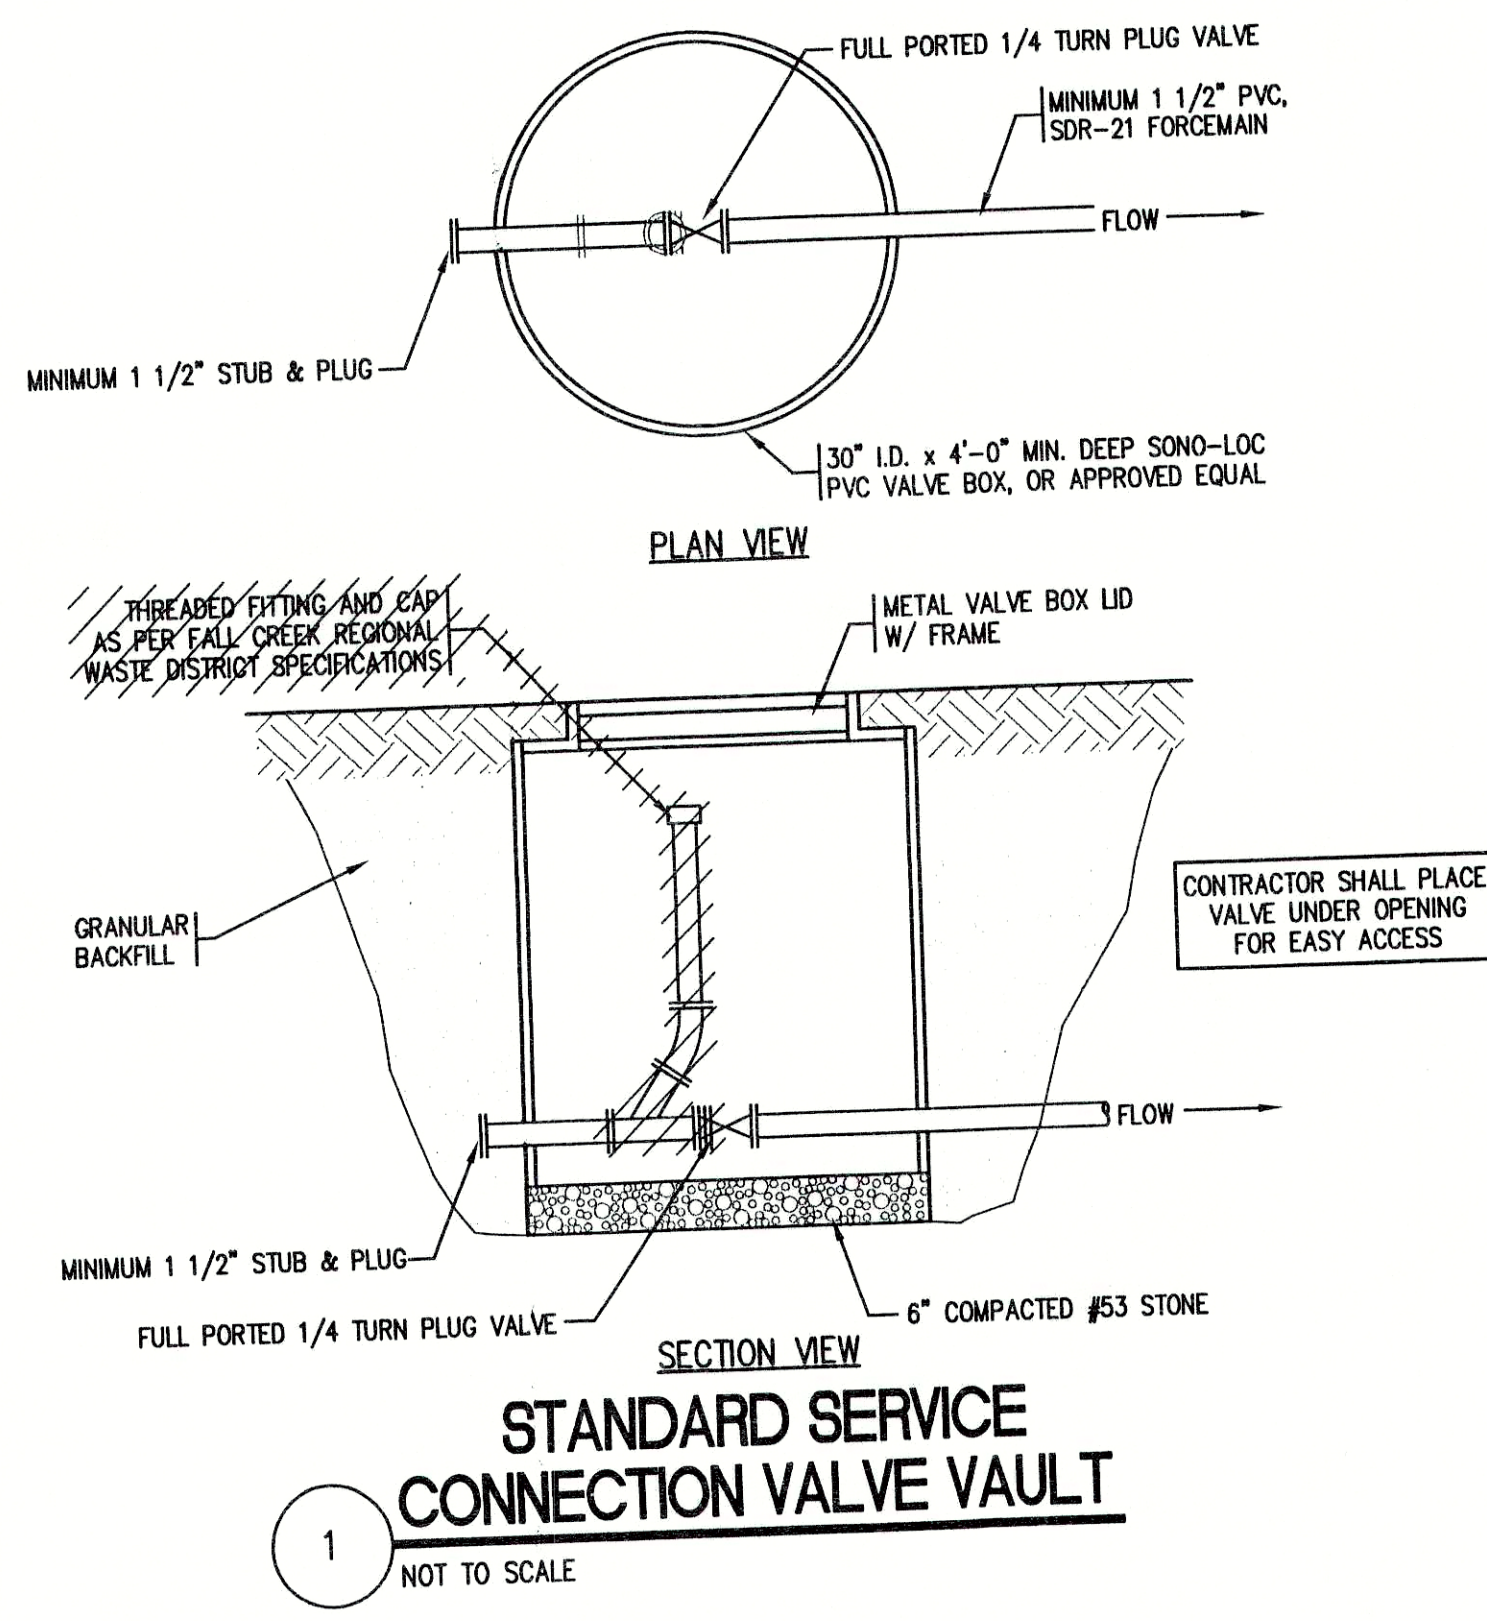

|                        |  |                 |                  |
|------------------------|--|-----------------|------------------|
| FILE NAME: WHTOK_D2-RD |  | PLOT SCALE: 1=1 | PLOT DATE: 11/15 |
|                        |  |                 |                  |
|                        |  |                 |                  |
**TRIAD ASSOCIATES INC.**  
INDIANAPOLIS, INDIANA

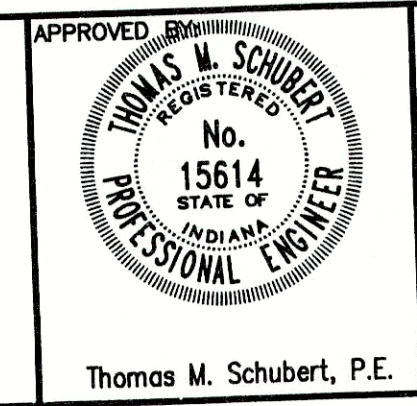

|                                                              |                                   |                                    |                     |
|--------------------------------------------------------------|-----------------------------------|------------------------------------|---------------------|
| WHITE OAKS SUBDIVISION<br>FALL CREEK REGIONAL WASTE DISTRICT |                                   |                                    |                     |
| STANDARD SANITARY SEWER DETAILS                              |                                   |                                    |                     |
| DRAWN BY: DAP                                                | DATE: 04/12/96<br>SCALE: AS NOTED | PROJECT No.: 98008A                | SHEET No.: 11 OF 11 |
| DESIGNED BY: D.A. Pauling                                    |                                   | CHECKED BY: James W. Frazell, P.E. |                     |