

# WOODED RIDGE ADDITION SANITARY SEWER PROJECT

## FOR THE FALL CREEK REGIONAL WASTE DISTRICT MADISON CO., IN.

1999

SRF PROJECT NO. CS 18207701


DIVISION II

CONTRACT 'A-2'

JOE ROWLETT - GENERAL MANAGER


### SHEET INDEX

SHEET NO.	DESCRIPTION
1	TITLE SHEET AND INDEX
2	PROJECT BASE MAPS
3-15	PLAN AND PROFILES SHEETS
16	LIFT STATION DETAIL
17-18	STANDARD SANITARY DETAILS

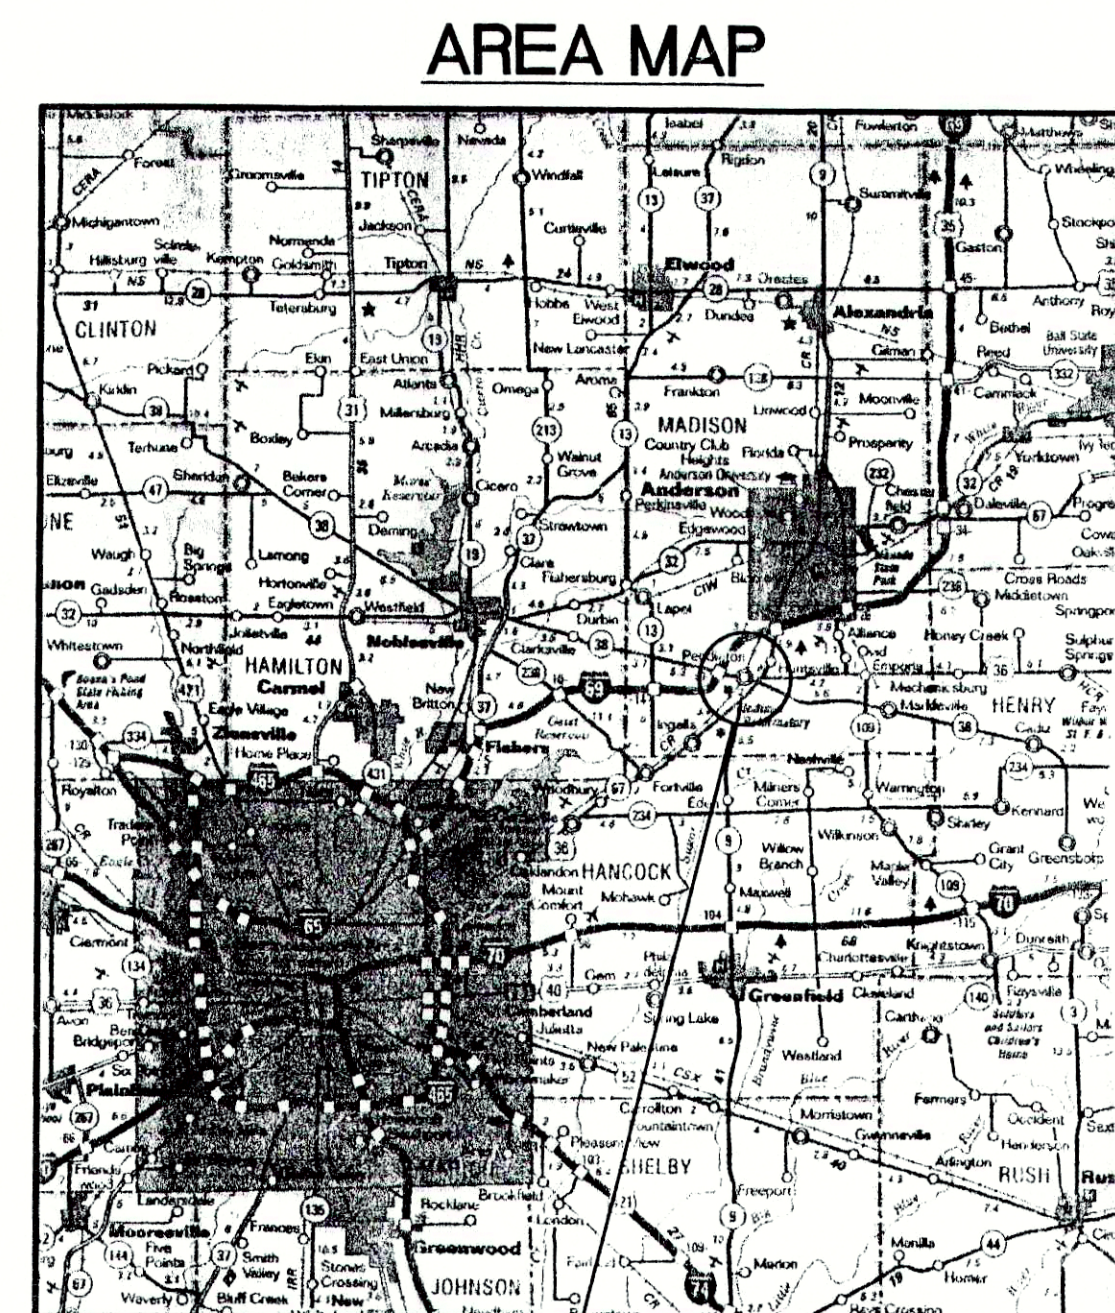

AREA  
LOCATION

LOCATION MAP

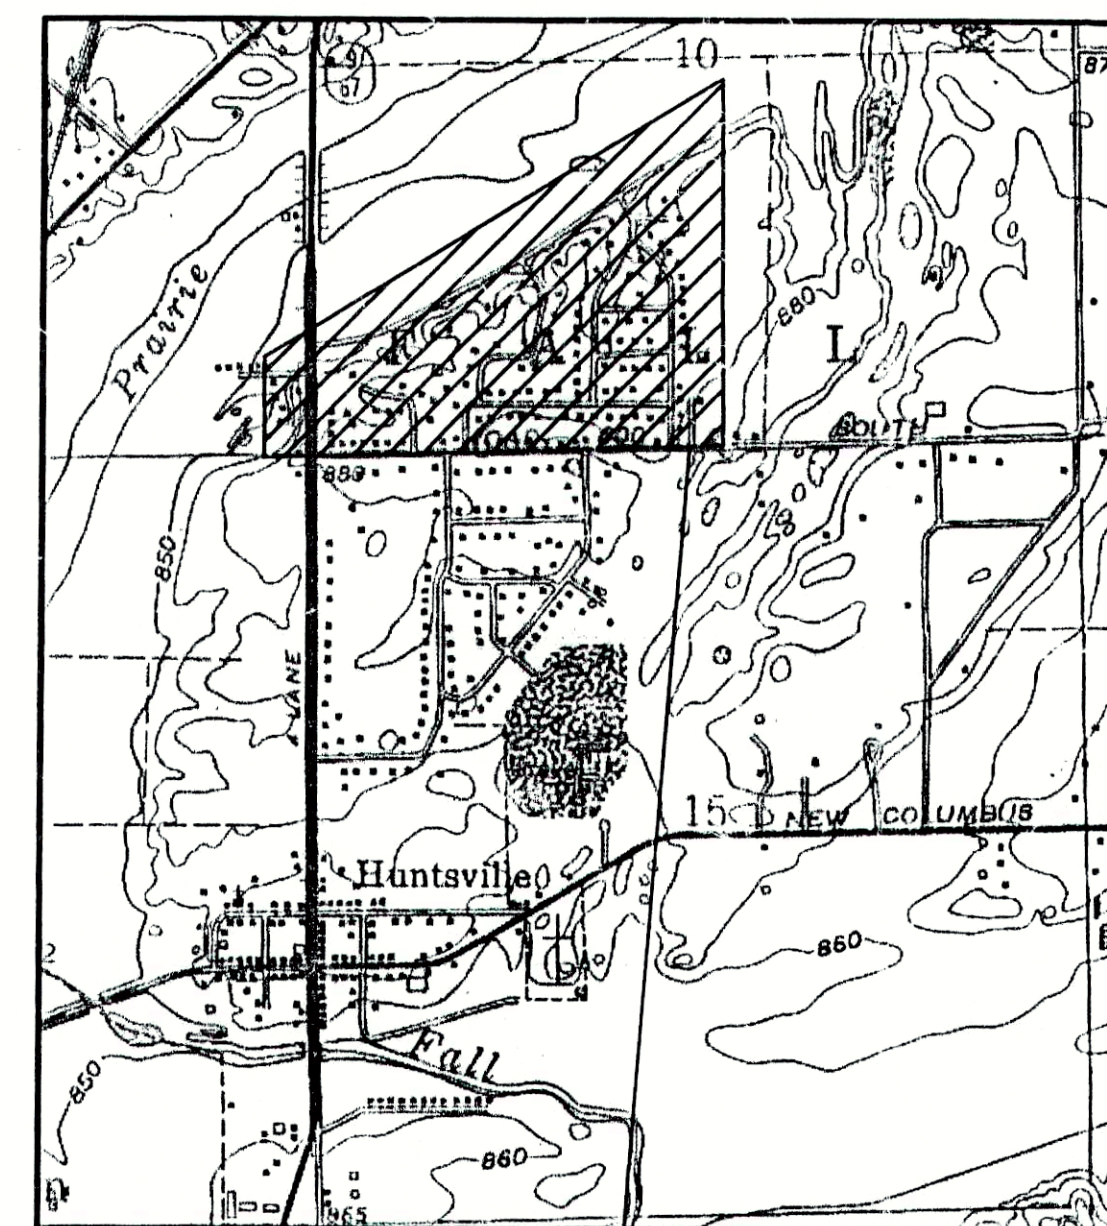

PROJECT  
LOCATION

### FALL CREEK REGIONAL WASTE DISTRICT BOARD

Mr. William Clark - President  
Mr. Morris McCurdy - Member  
Mr. Doug McGee - Member  
Mr. Mark Jablonski - Member  
Mr. Agon Tolbert - Member  
Mr. Dallas Foster - Member  
Mr. Jack Kasdorf - Member  
Mr. Timothy Green - Member  
Mr. John Ellingwood - Member  
Mr. Joe Rowlett - General Manager

### ATTORNEY

Mr. Randall Sorrell

### PLANS PREPARED BY:

**TRIAD  
ASSOCIATES  
INC.**  
INDIANAPOLIS, INDIANA

NOTE:  
ADDITIONAL RIGHT-OF-WAY OR EASEMENTS MAY  
NEED TO BE ACQUIRED FOR INSTALLATION OF SEWER.



DON'T DIG BLIND  
CALL BEFORE YOU DIG  
1-800-382-5544  
1-800-428-5200

PER INDIANA STATE L'W 15-69-1991, IT IS  
AGAINST THE LAW TO EXCAVATE WITHOUT  
NOTIFYING THE UNDERGROUND LOCATION SERVICE  
TWO (2) WORKING DAYS BEFORE COMMENCING WORK.  
NOTE: CONTRACTOR TO VERIFY ALL UTILITY LOCATIONS  
PRIOR TO THE START OF CONSTRUCTION

### THESE PLANS CERTIFIED BY:

James W. Frazell, Professional Engineer

**RECORD DRAWING**

February 15, 2001

Thomas M. Schubert, Professional Engineer

