

STRUCTURE No. WR-057

MATCH LINE - SEE BOTTOM RIGHT

STRUCTURE No. WR-056

STRUCTURE No. WR-055

STRUCTURE No. WR-054

STRUCTURE No. WR-053

STRUCTURE No. WR-052

STRUCTURE No. WR-051

TBM INFORMATION

- WO-TBM #1 - FIRE HYDRANT IN FRONT OF LACO IN HUNTSVILLE
FIRE HYDRANT BOLT UNDER LETTER "Y"
IN KENNEDY ELEV. - 871.16
- WR-TBM #1a - NORTHWEST CORNER OF HEADWALL AT THE NORTH
SIDE OF THE ROAD AT RIDGE LANE AND
STATE ROAD No. 9 ELEV. - 851.81
- WR-TBM #2 - NORTHWEST CORNER OF WINGWALL AT
DOUGLASS AVENUE AND RIDGE LANE
ELEV. - 855.35

UTILITIES

ANDERSON LIGHT AND POWER
550 BAXTER ROAD
ANDERSON, INDIANA 46016
1 (765) 648-6187

CYNERGY/PSI
100 S. MILL CREEK ROAD
NOBLESVILLE, INDIANA 46060
1 (800) 521-2232

PENDLETON MUNICIPAL WATER UTILITY
P.O. BOX 230
PENDLETON, INDIANA 46064
1 (765) 778-2173

GTE
P.O. BOX 1406
RICHMOND, INDIANA 47375
1 (800) 483-5600

INDIANA GAS COMPANY, INC.
2001 LOUISE STREET
ANDERSON, INDIANA 46016
1 (800) 777-2060

TCI OF CENTRAL INDIANA
335 E. 10th STREET
ANDERSON, INDIANA 46016
1 (765) 649-0407

LEGEND

4 - SHEET DESIGNATION

NOTE:


ADDITIONAL RIGHT-OF-WAY OR EASEMENTS MAY
NEED TO BE ACQUIRED FOR INSTALLATION OF SEWER.



DON'T DIG BLIND
CALL BEFORE YOU DIG
TOLL FREE
1-800-382-5544
OR
1-800-428-5200

PER INDIANA STATE LAW IS-69-1991, IT IS
AGAINST THE LAW TO EXCAVATE WITHOUT
NOTIFYING THE UNDERGROUND LOCATION SERVICE
TWO (2) WORKING DAYS BEFORE COMMENCING WORK.

NOTE: CONTRACTOR TO VERIFY ALL UTILITY LOCATIONS
PRIOR TO THE START OF CONSTRUCTION

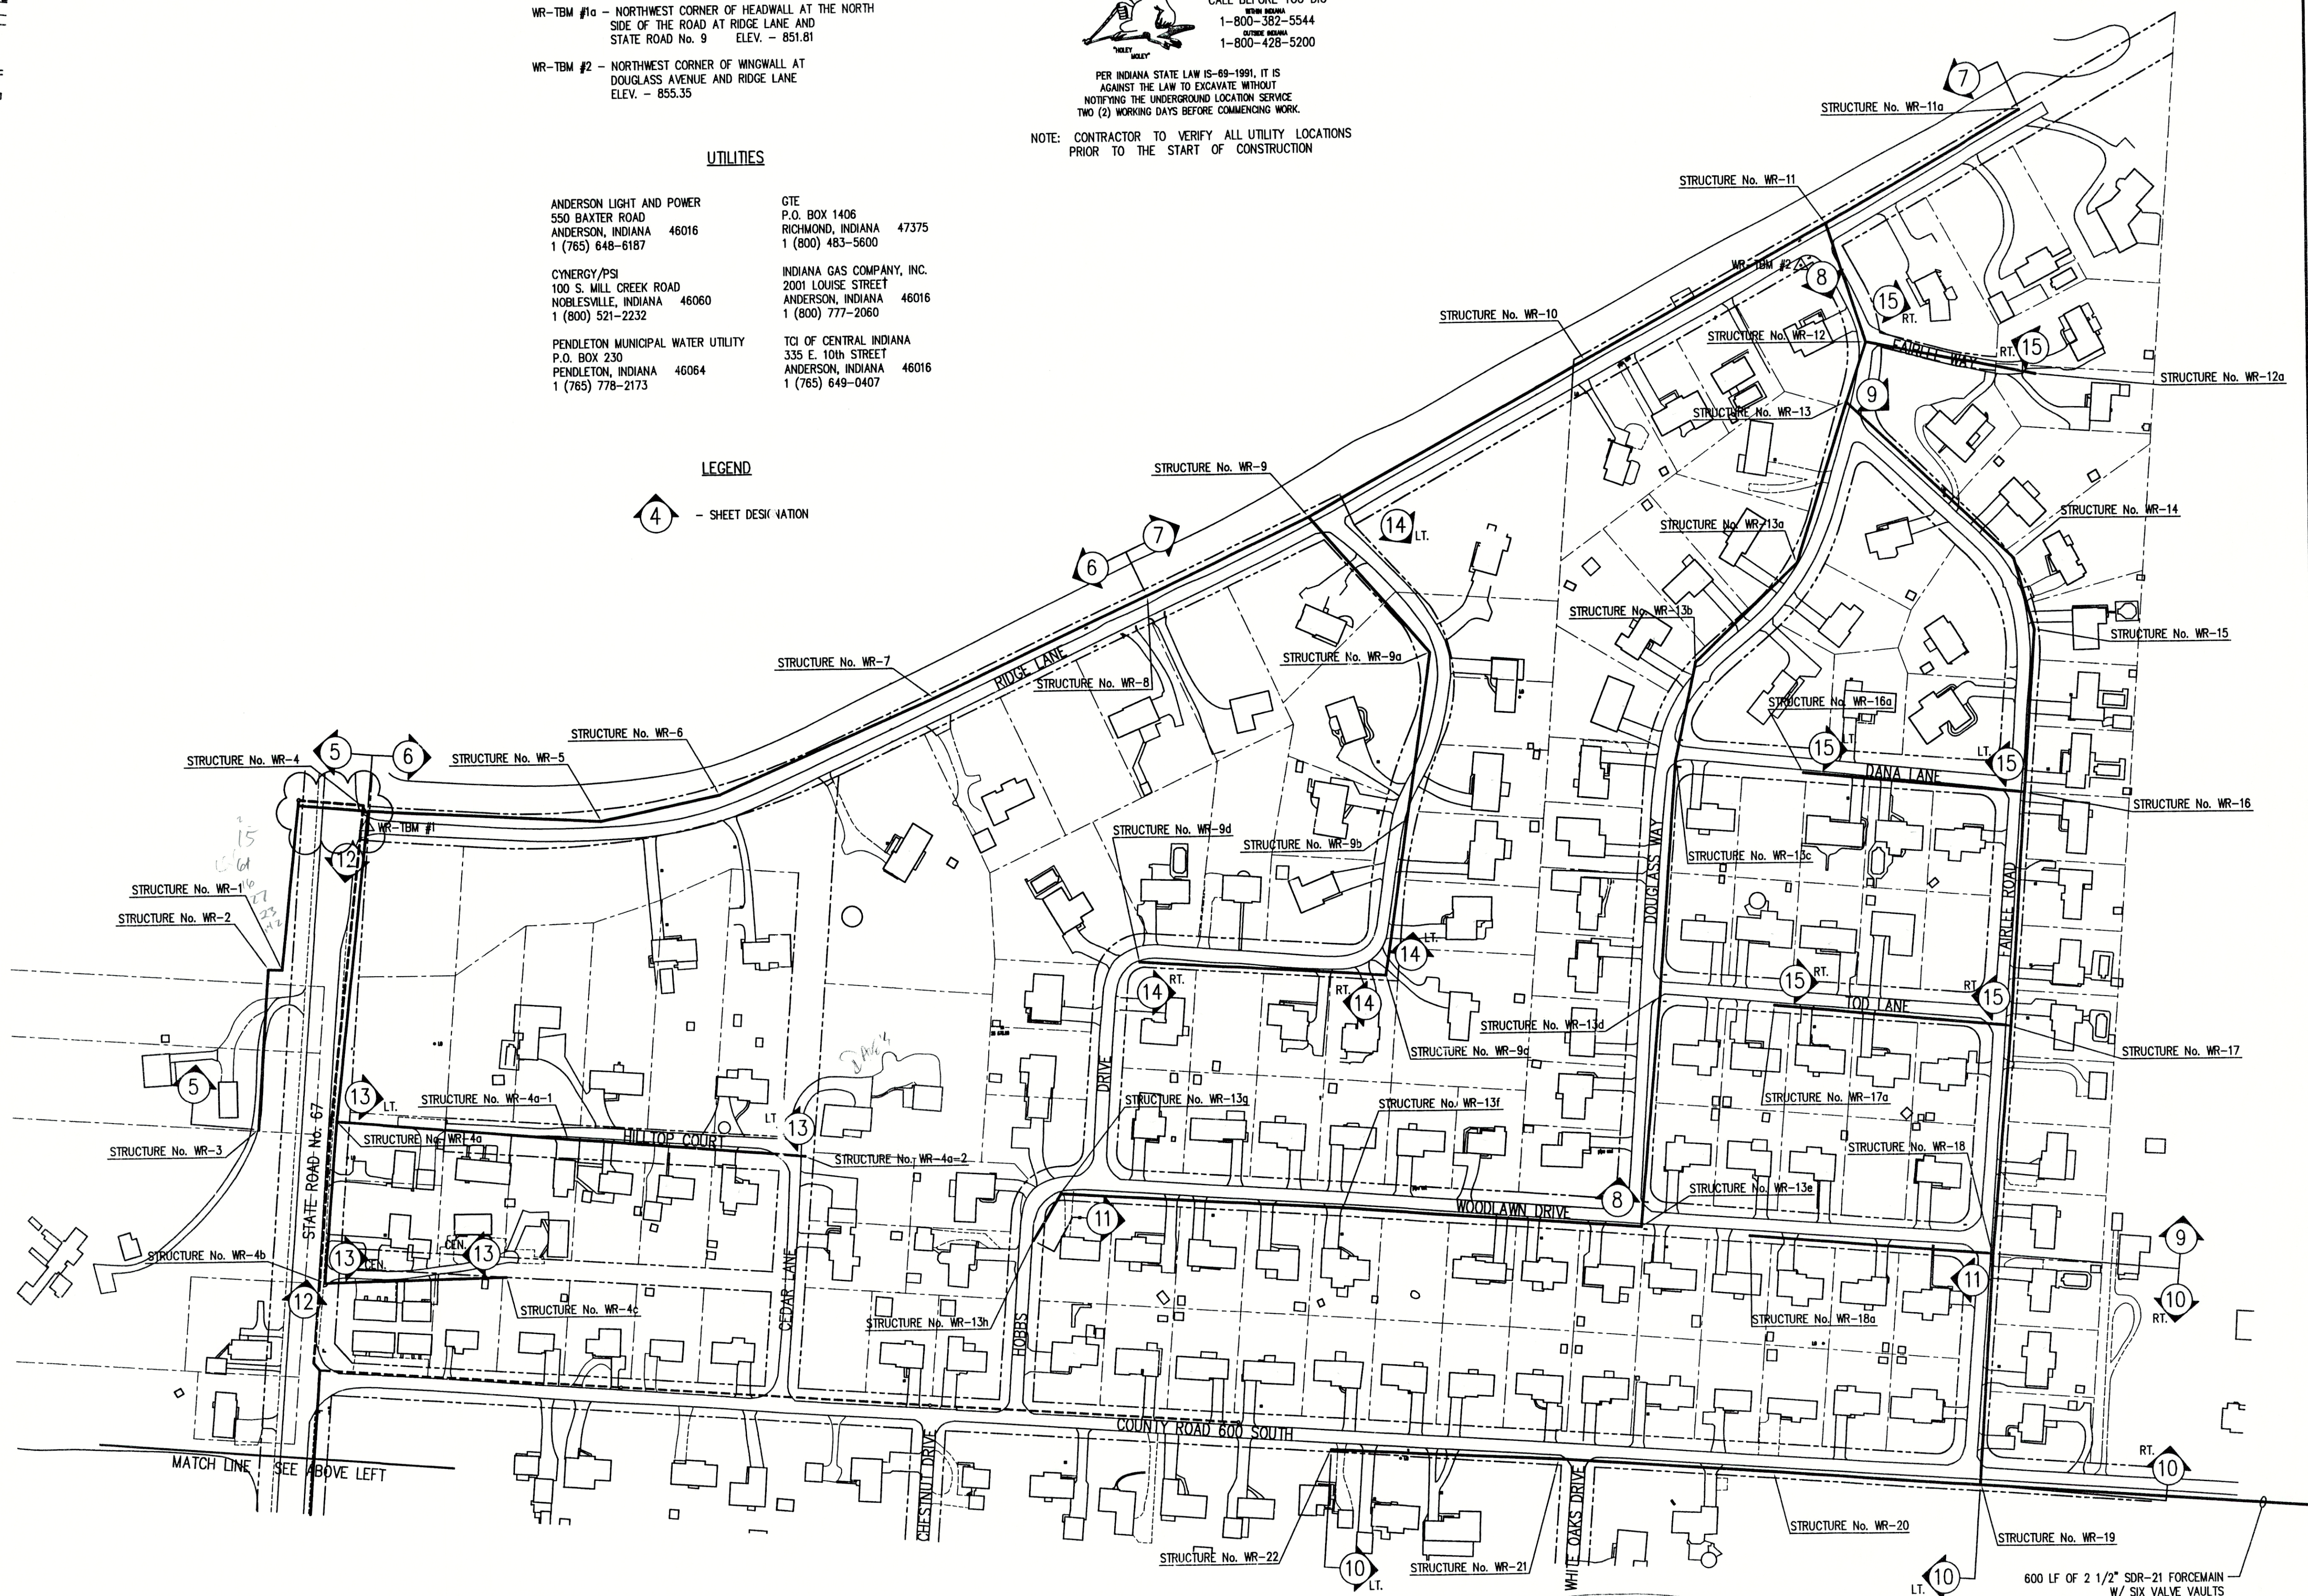

RECORD DRAWING

February 15, 2001


AREA BASE MAP
NOT TO SCALE



FILE NAME: WORDGBAS-RD PLOT SCALE: 1=125 PLOT DATE: 12/6

NO.	DATE	DESCRIPTION	BY

TRIAD
ASSOCIATES
INC.
INDIANAPOLIS, INDIANA

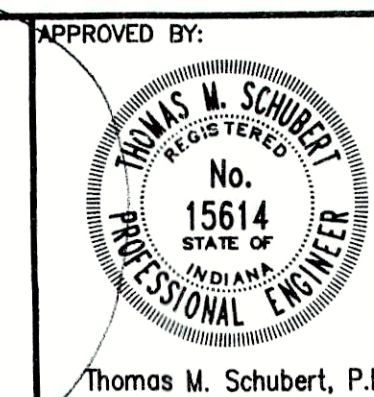

WOODED RIDGE SUBDIVISION FALL CREEK REGIONAL WASTE DISTRICT			
PROJECT BASE MAP			
DRAWN BY:	DATE	PROJECT No.	SHEET No.
DAP	04/12/98	98008A	2
DESIGNED BY:	SCALE	AS NOTED	18
CHECKED BY:			