
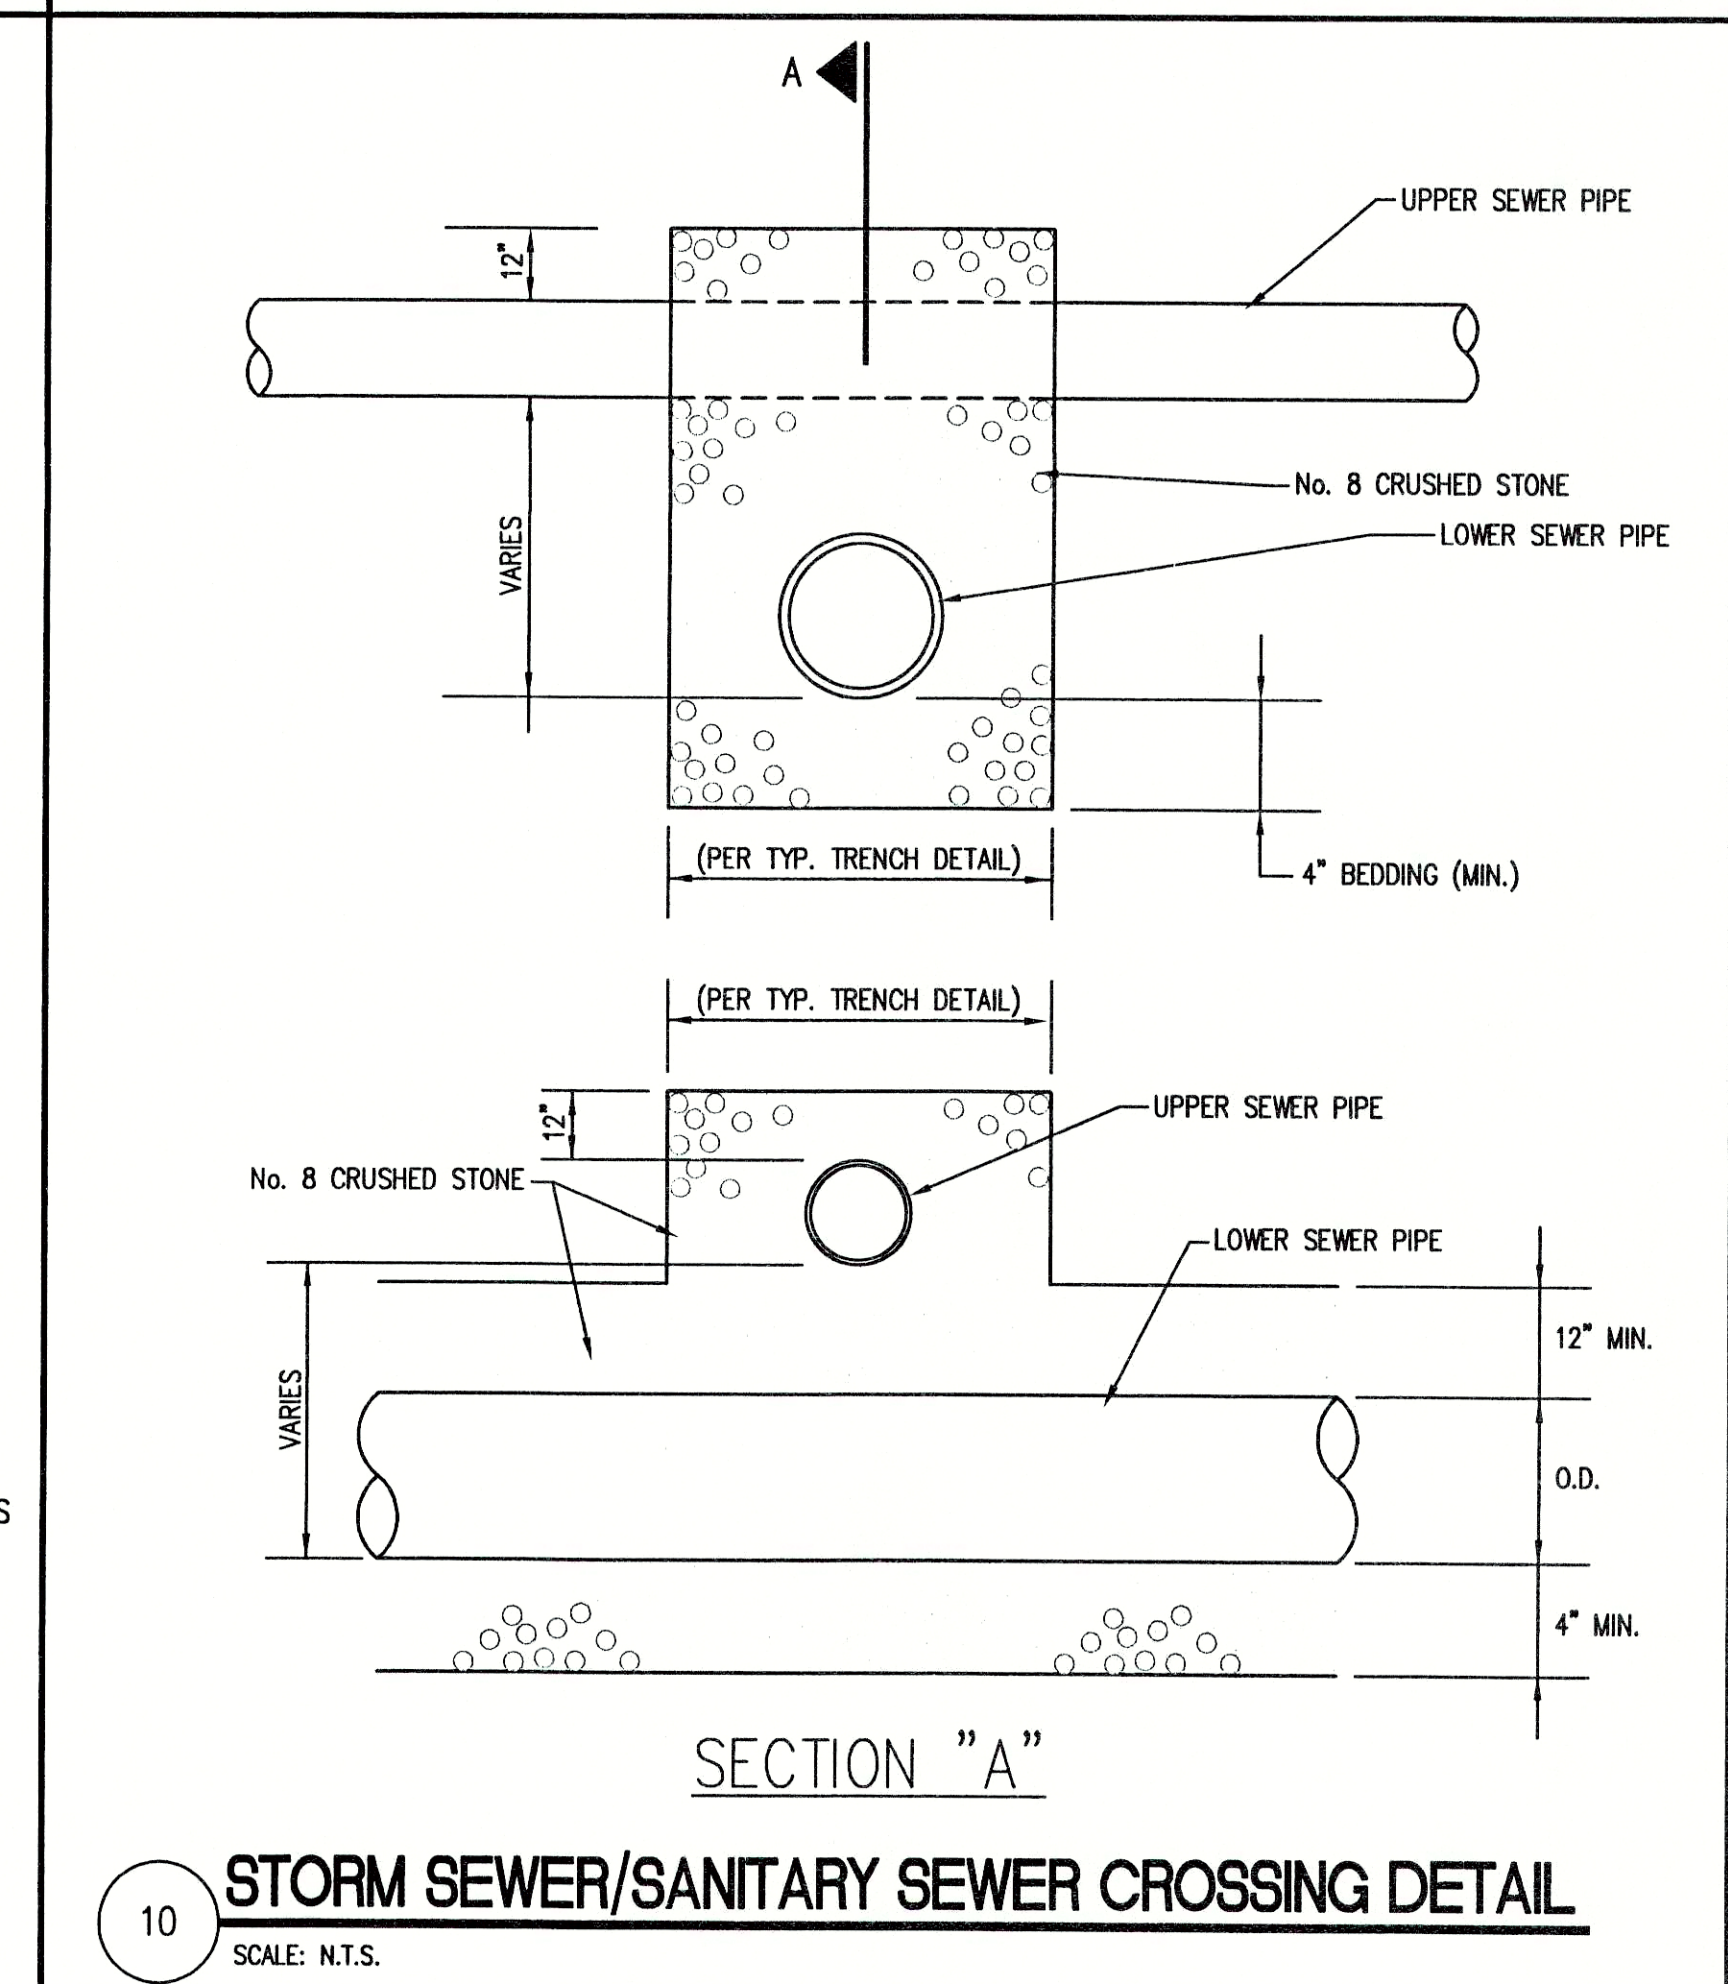
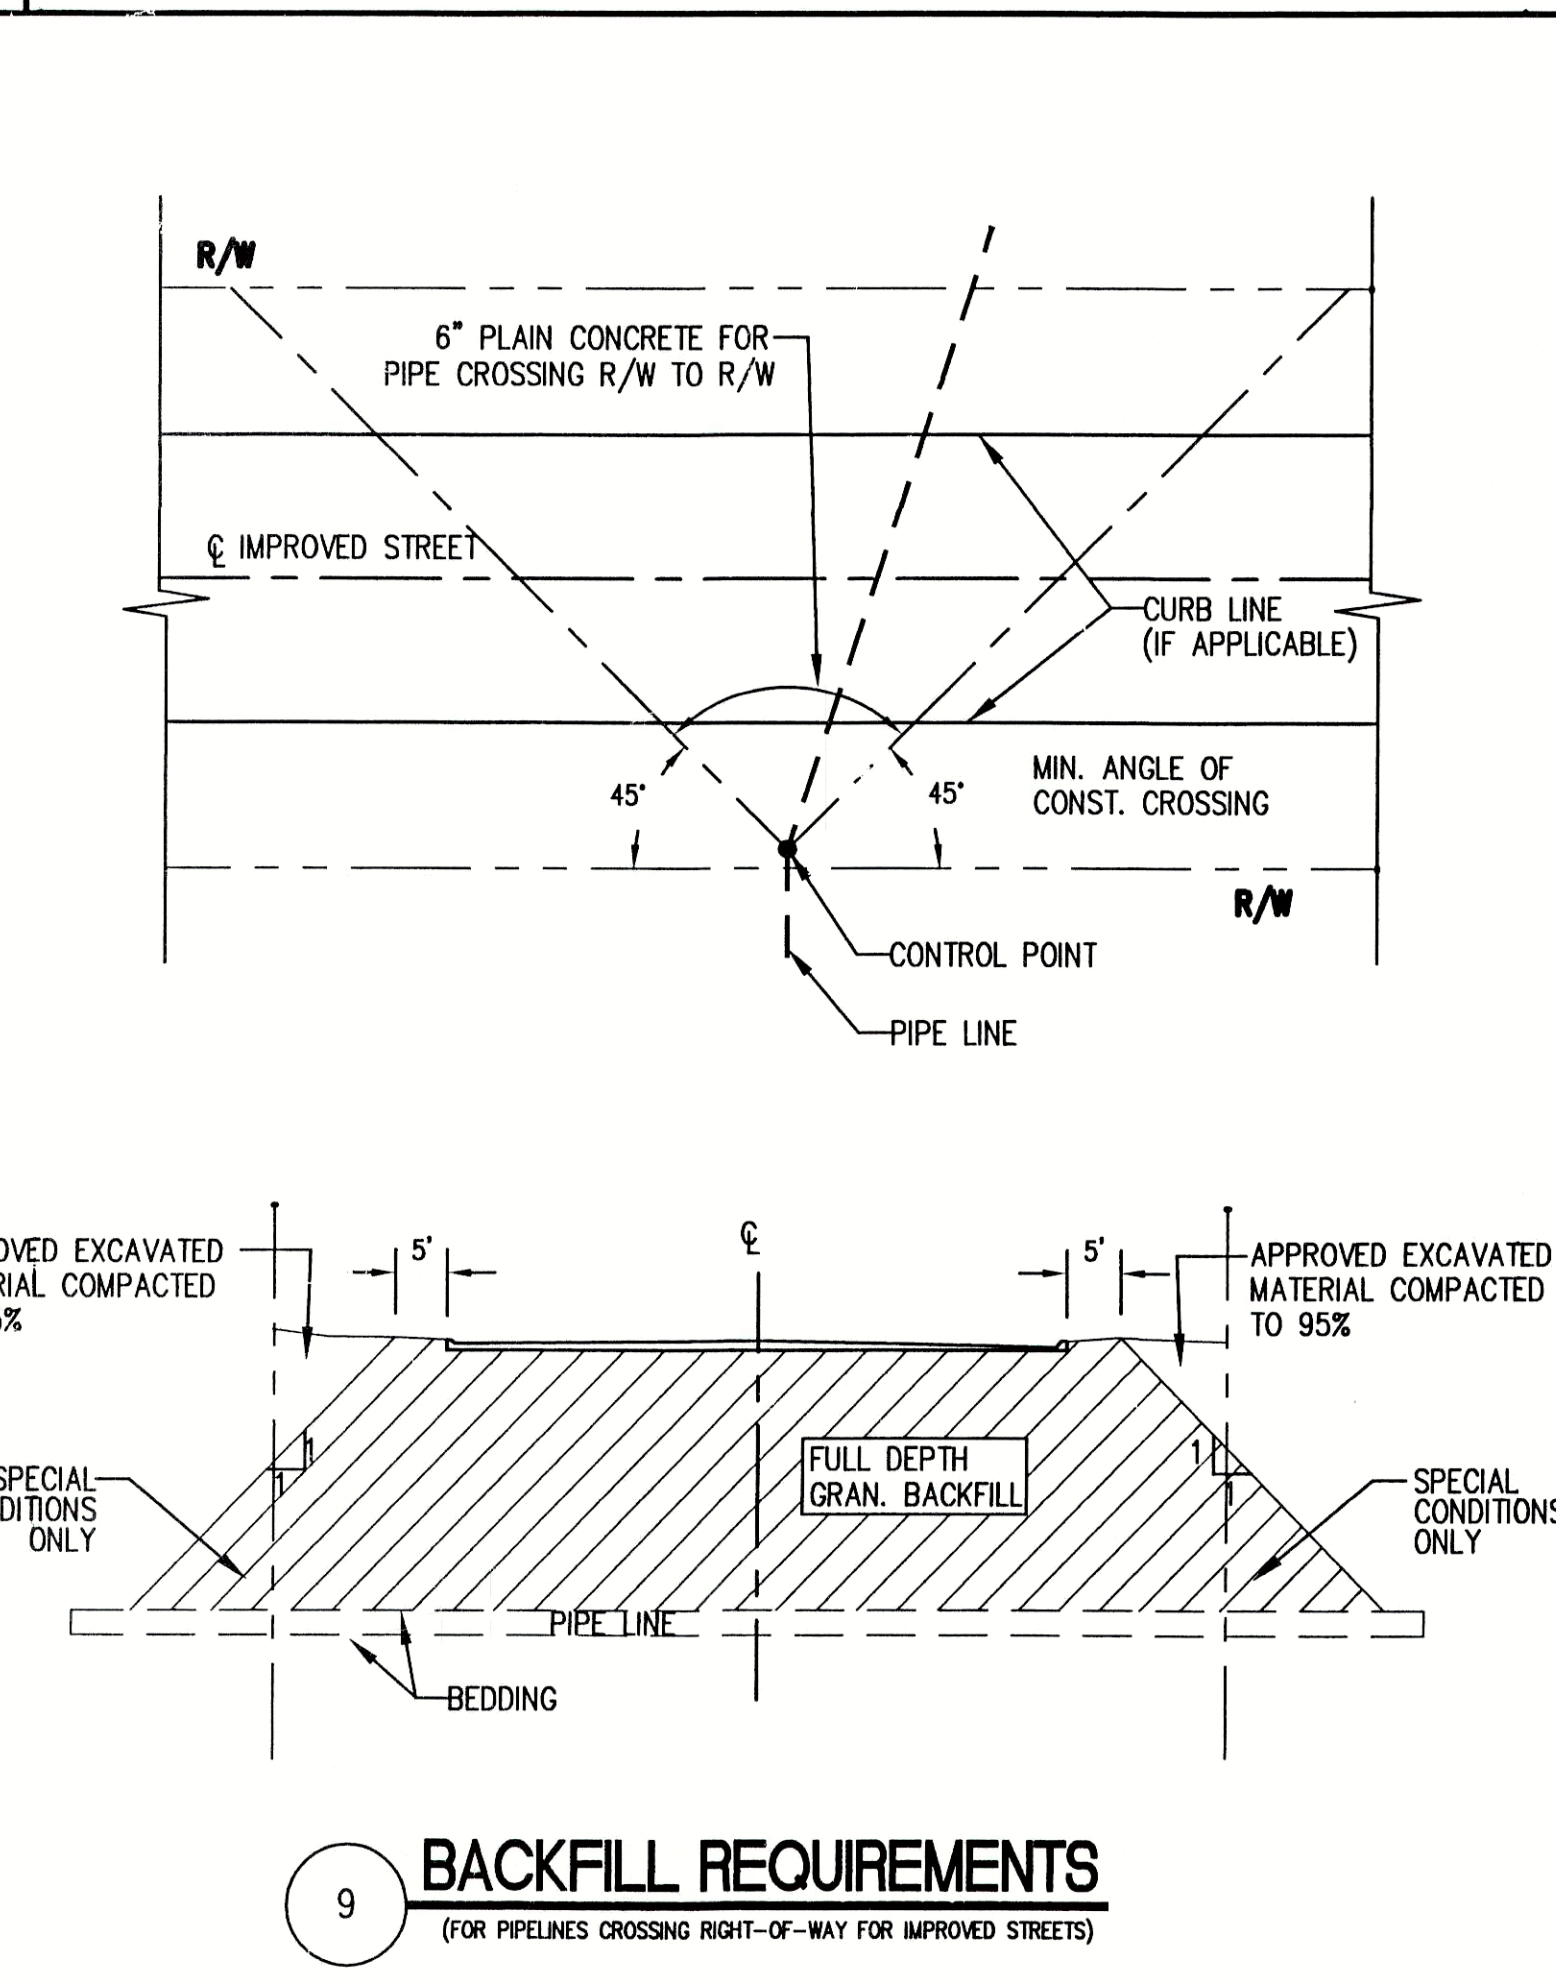
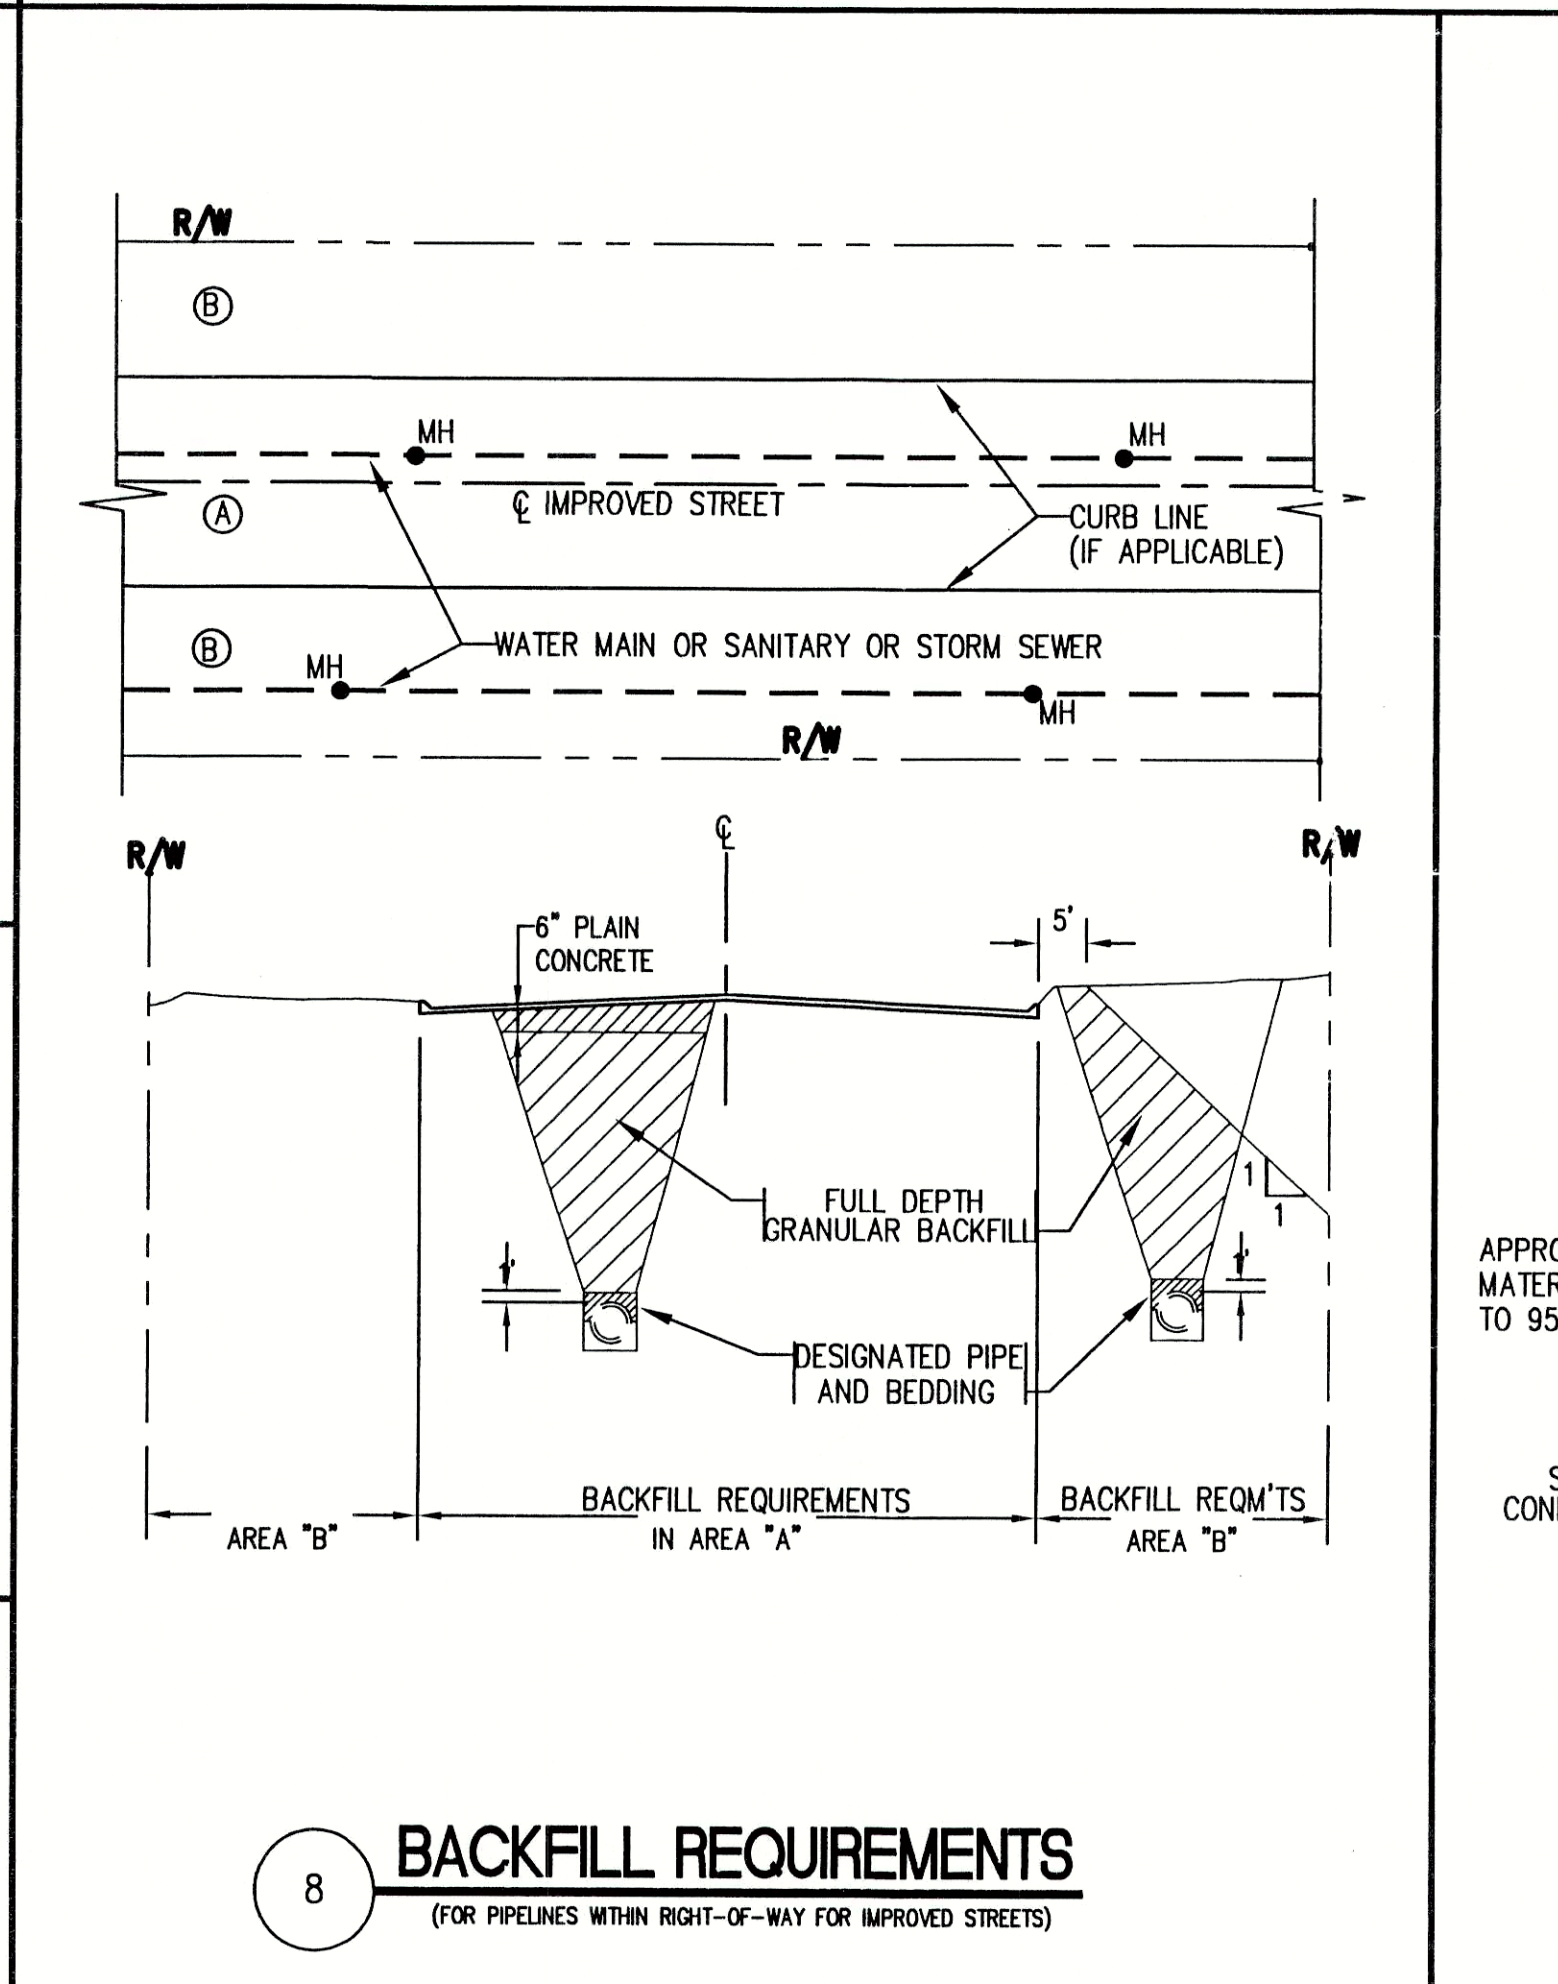
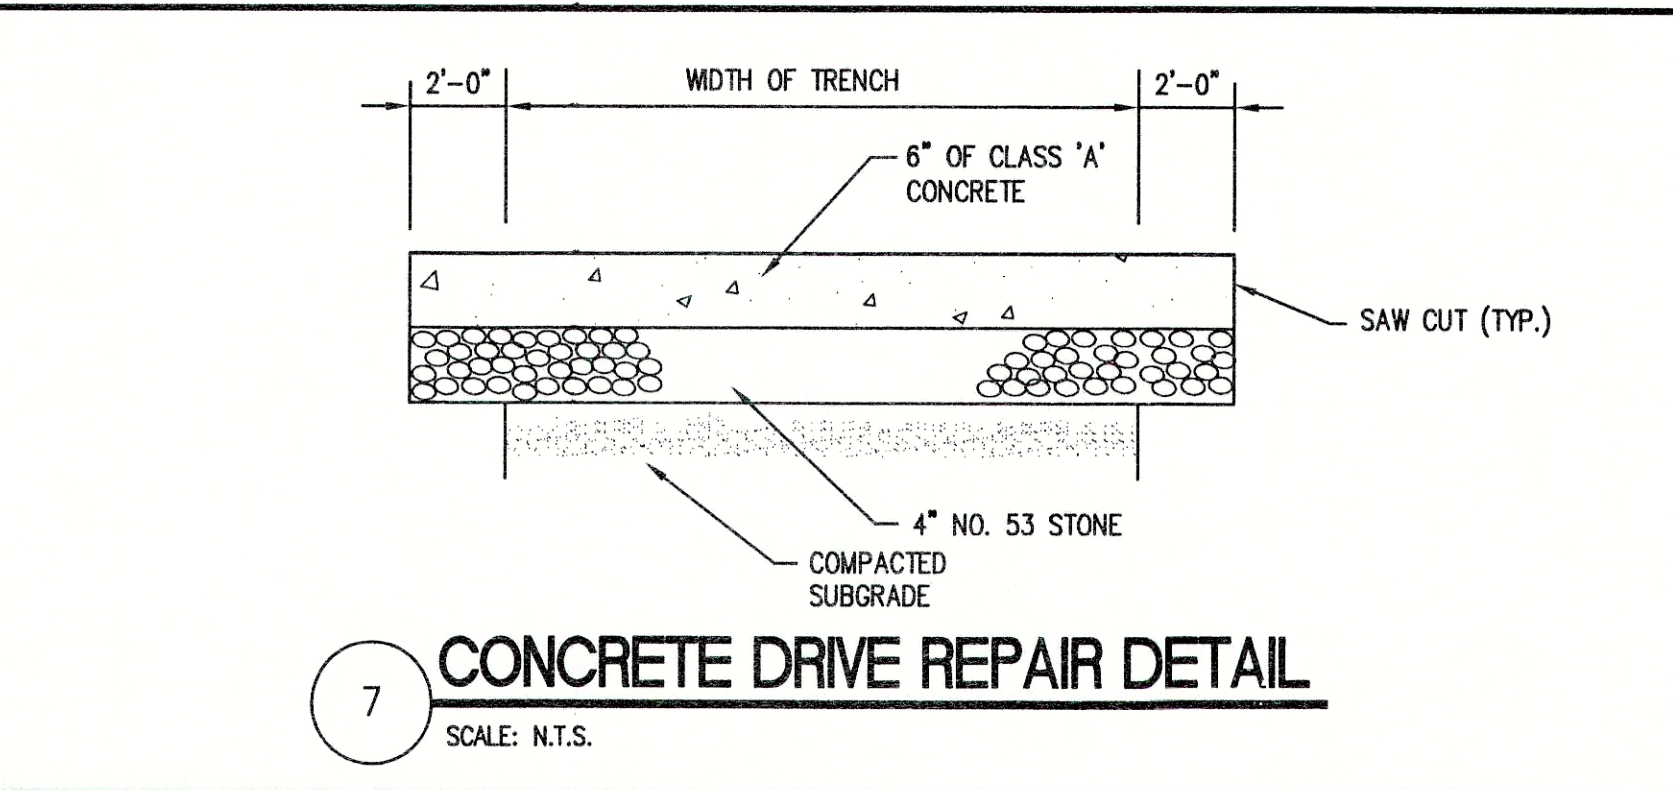
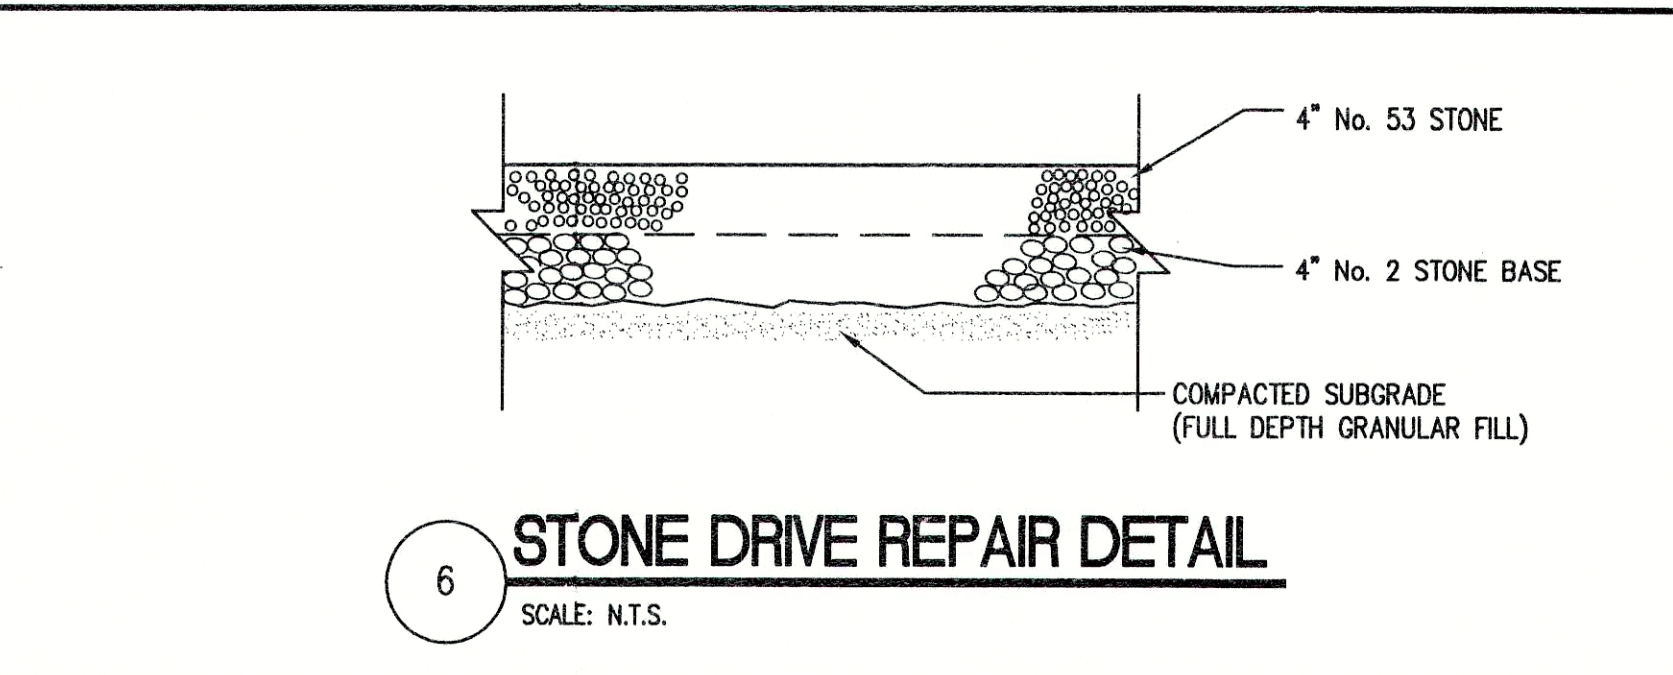
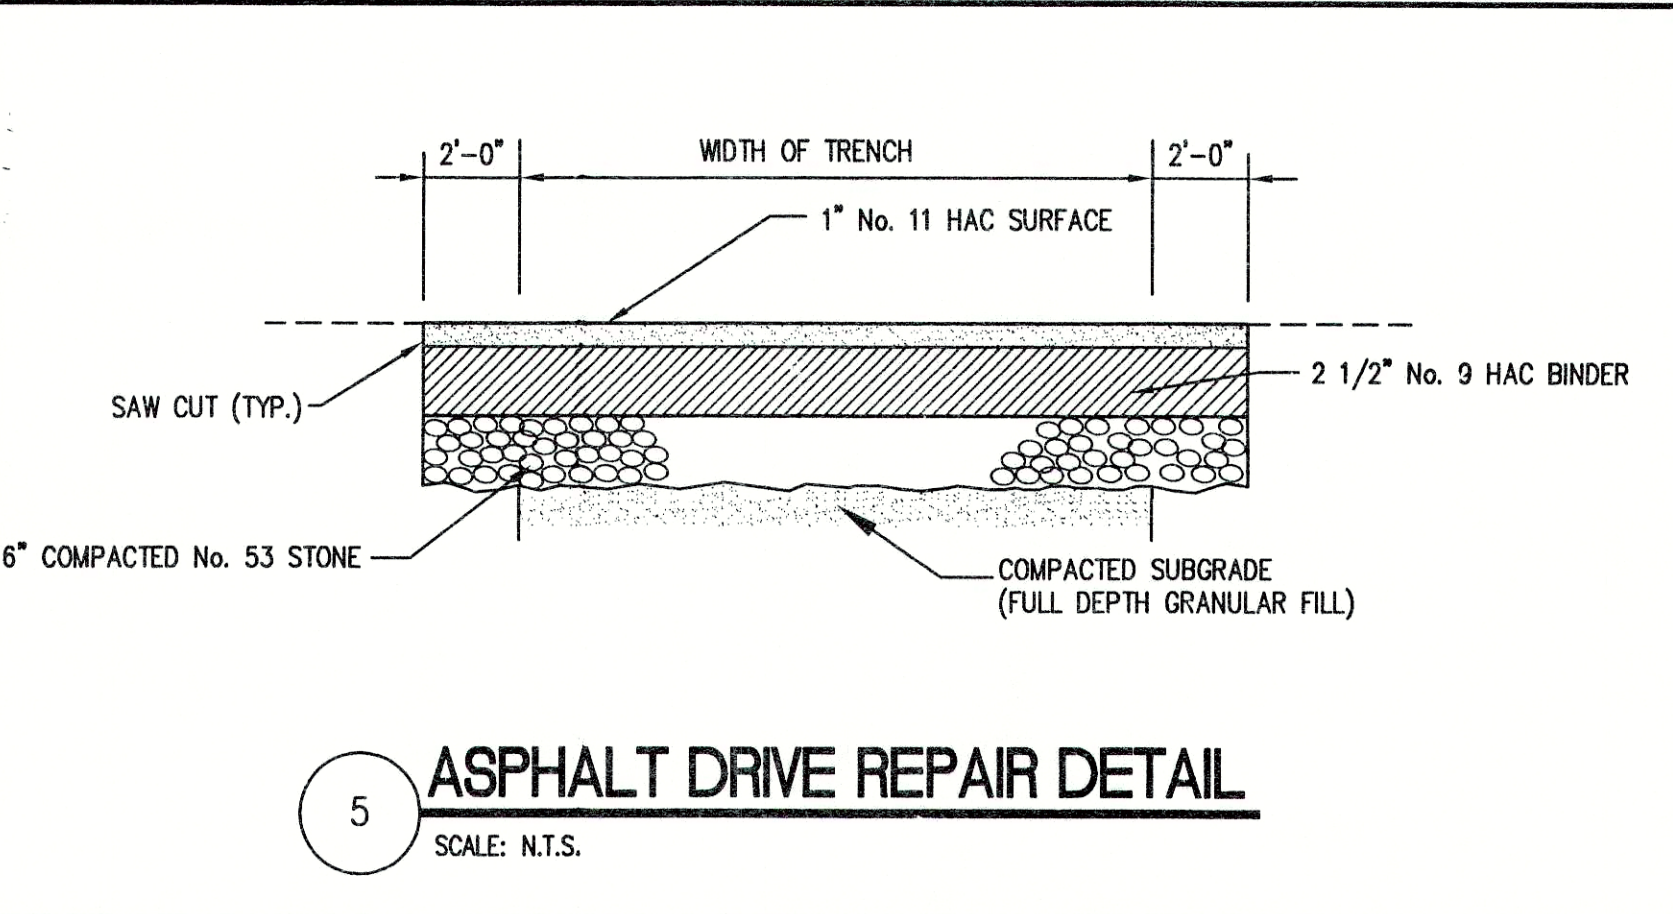
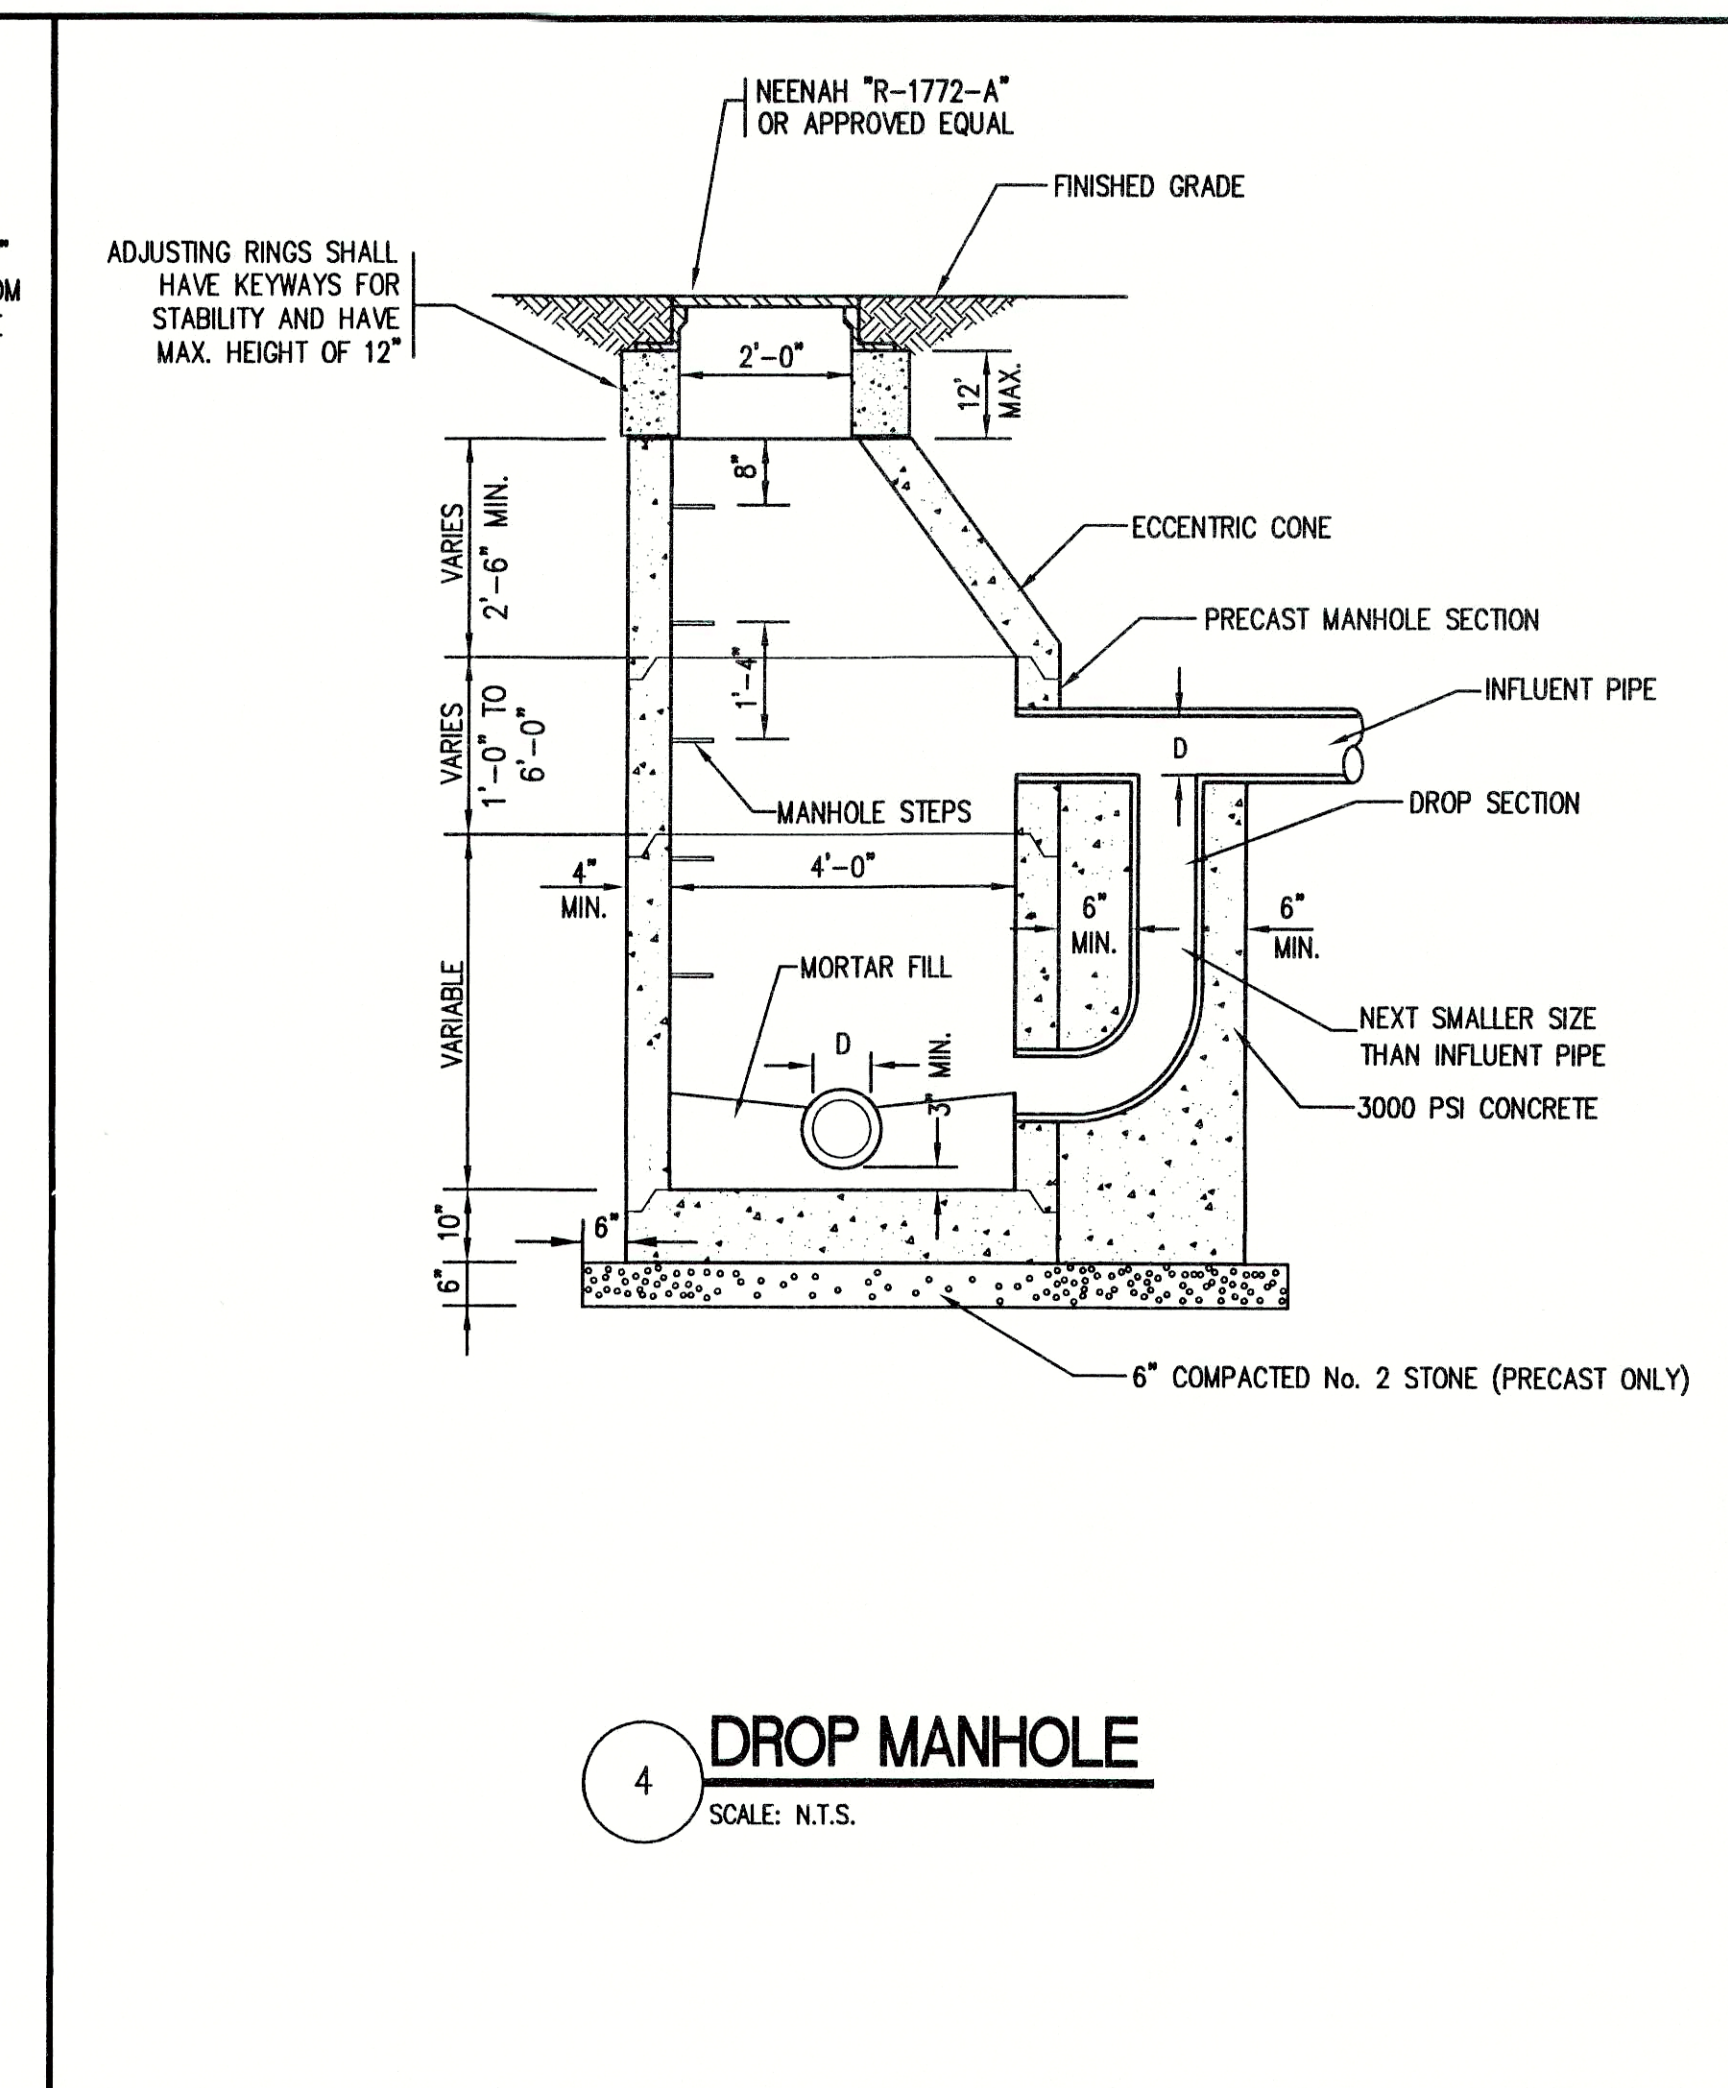
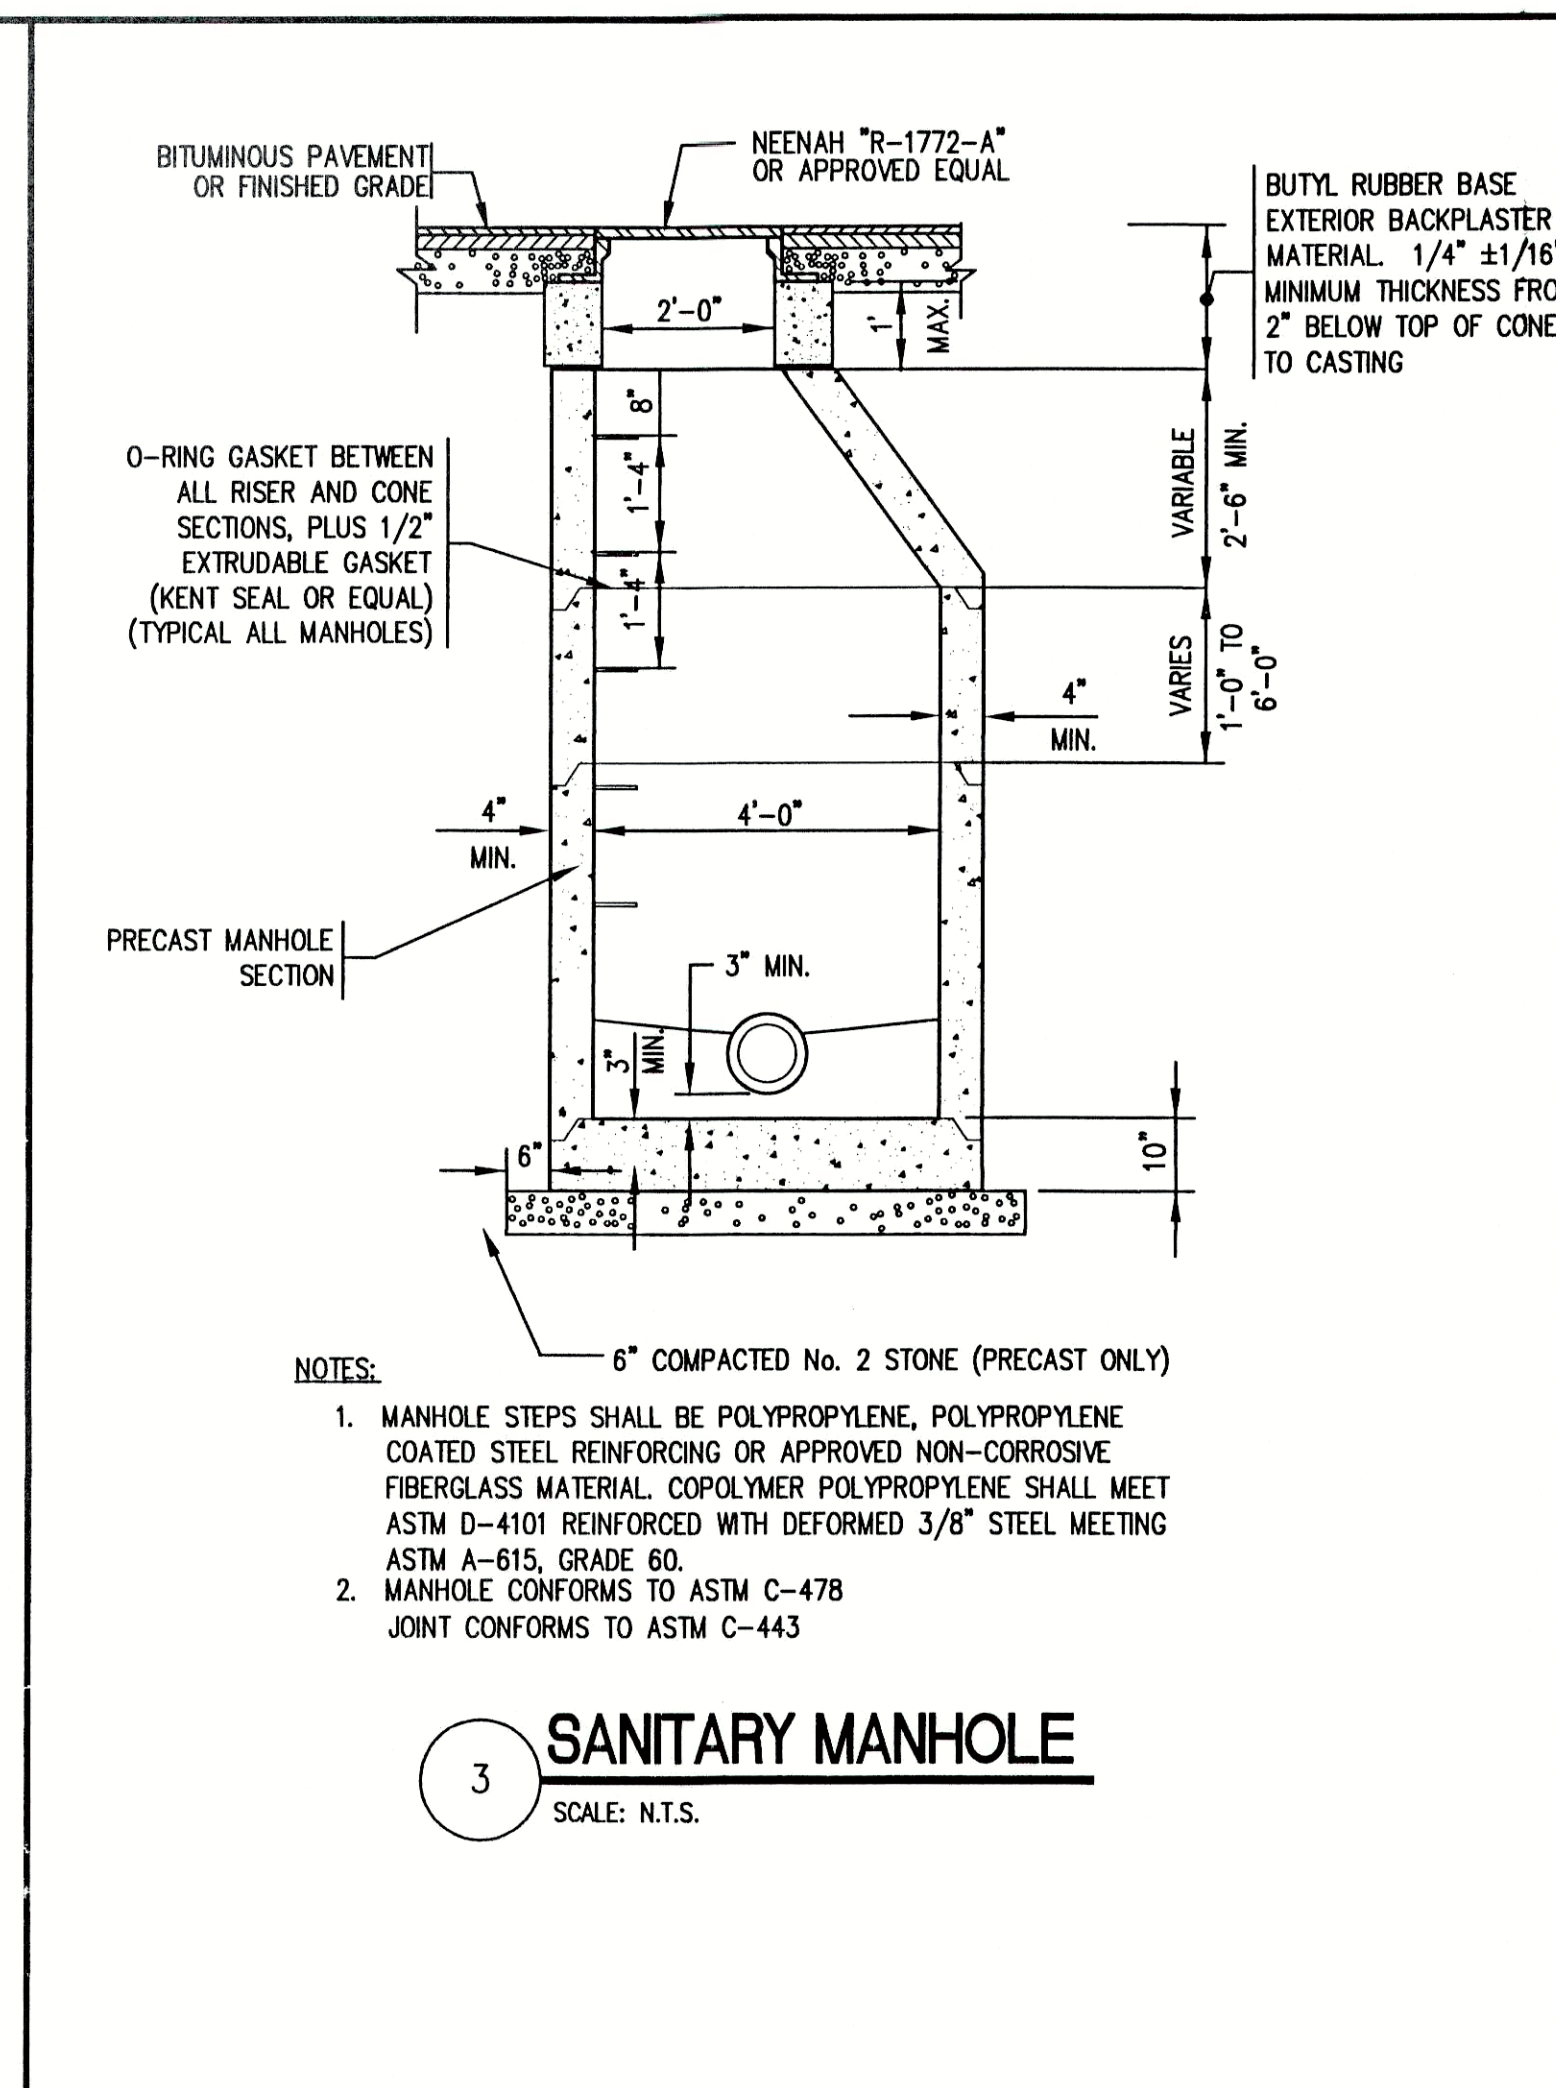
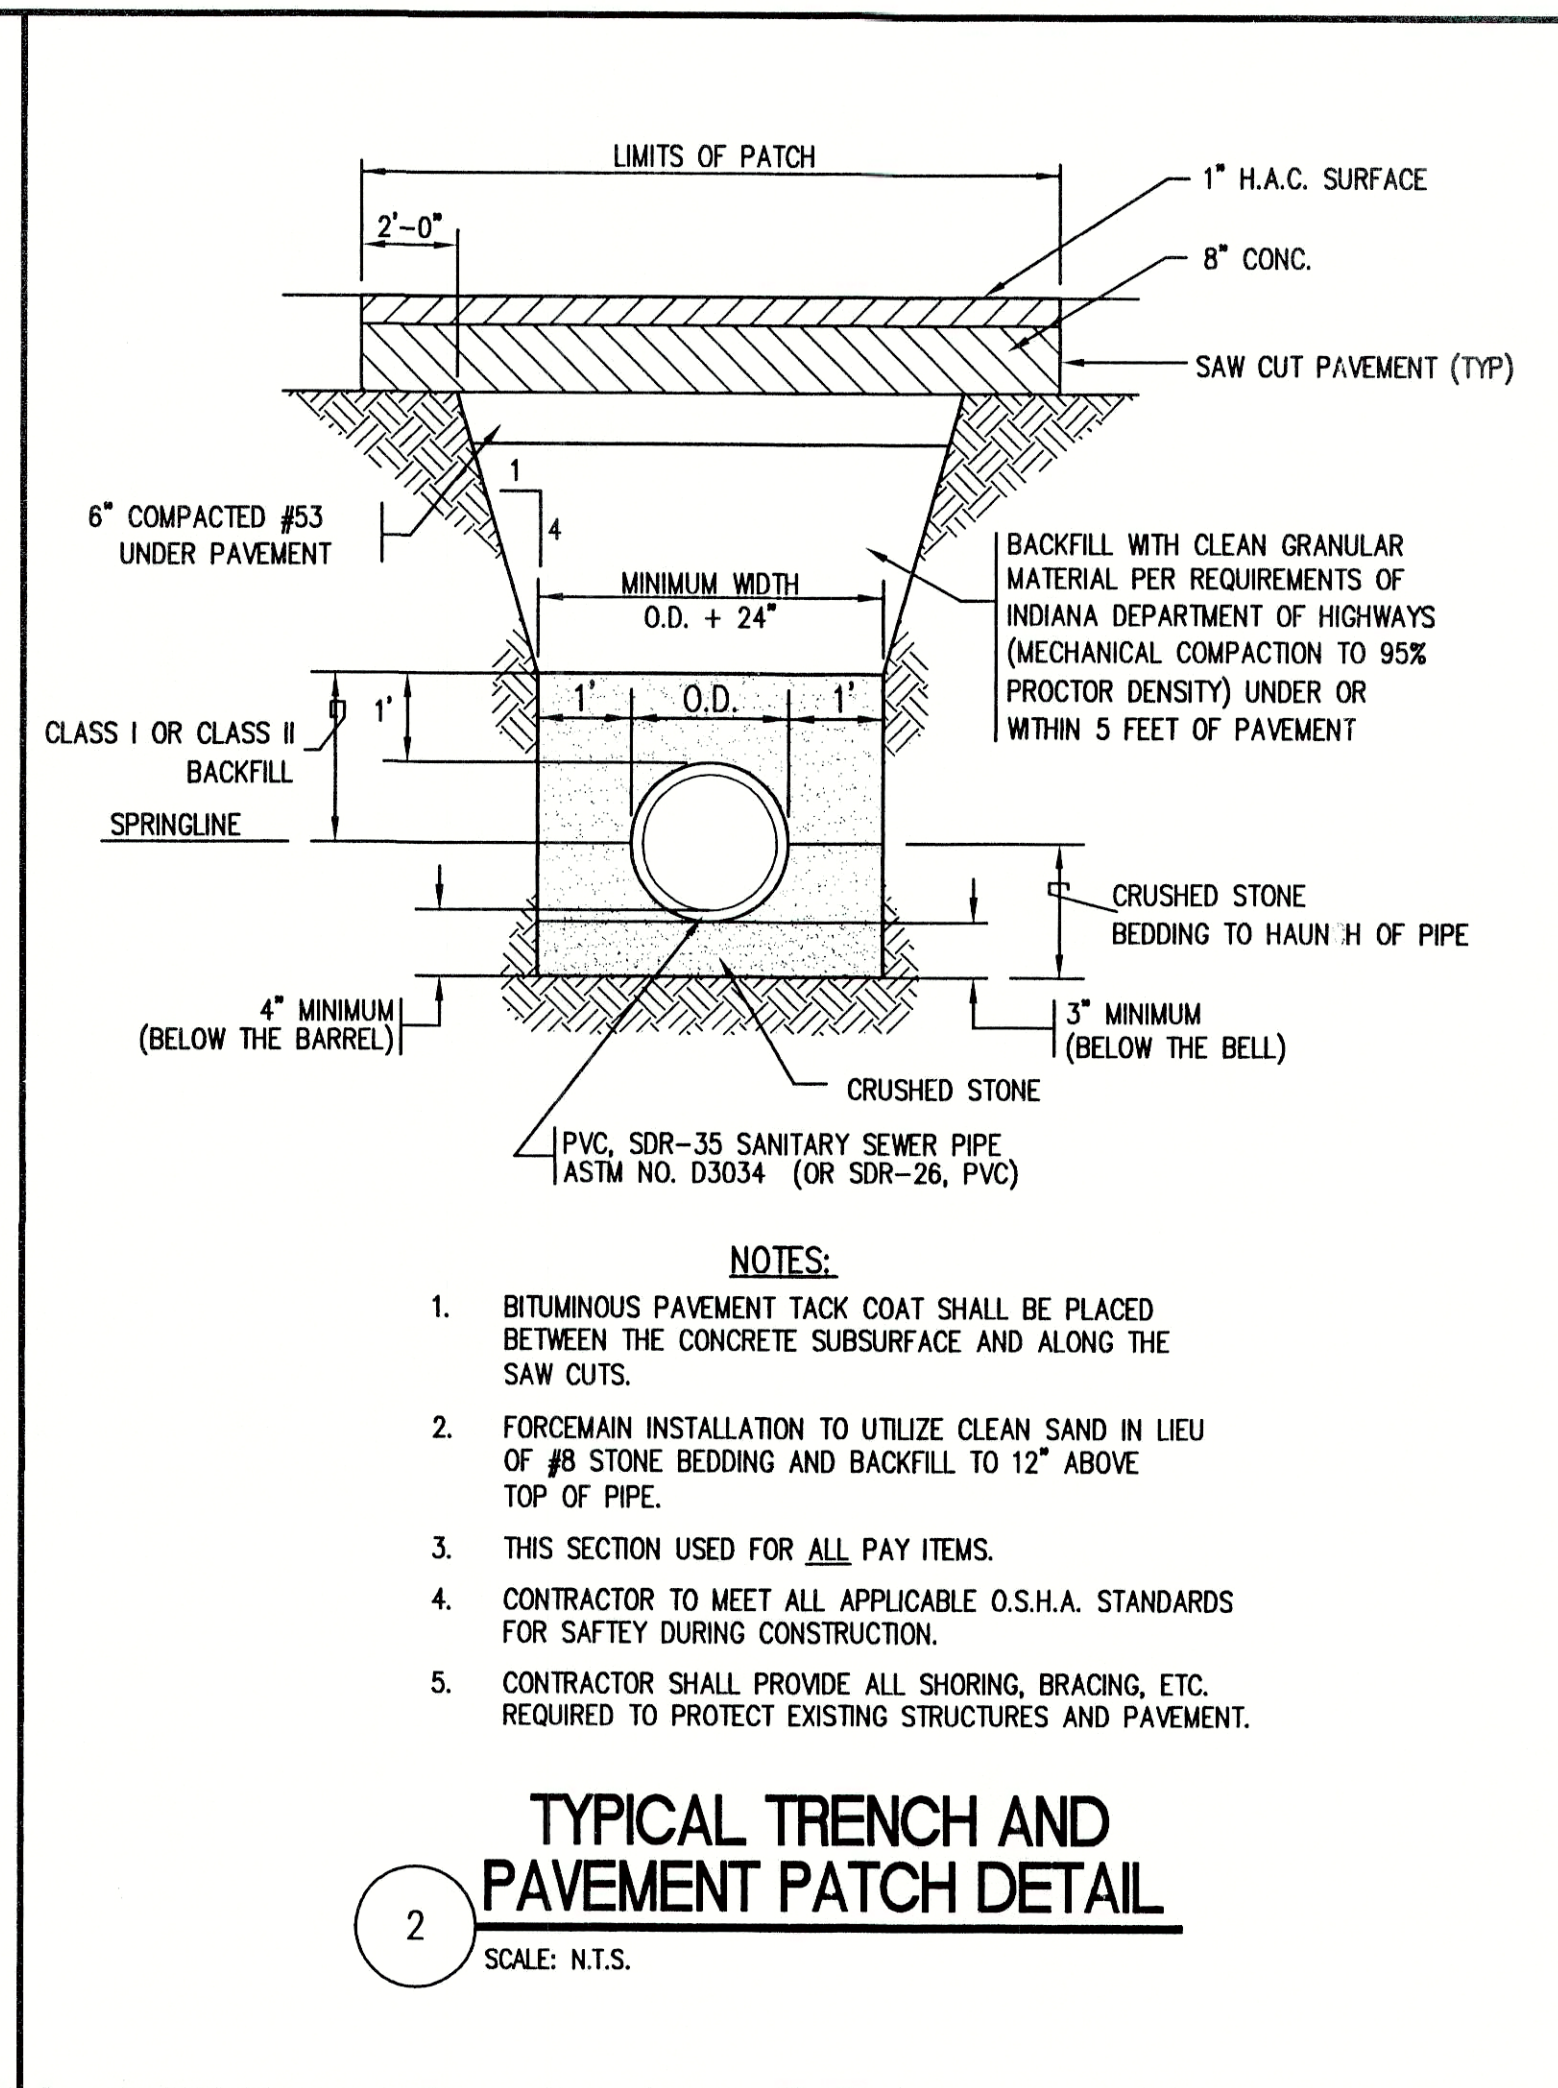


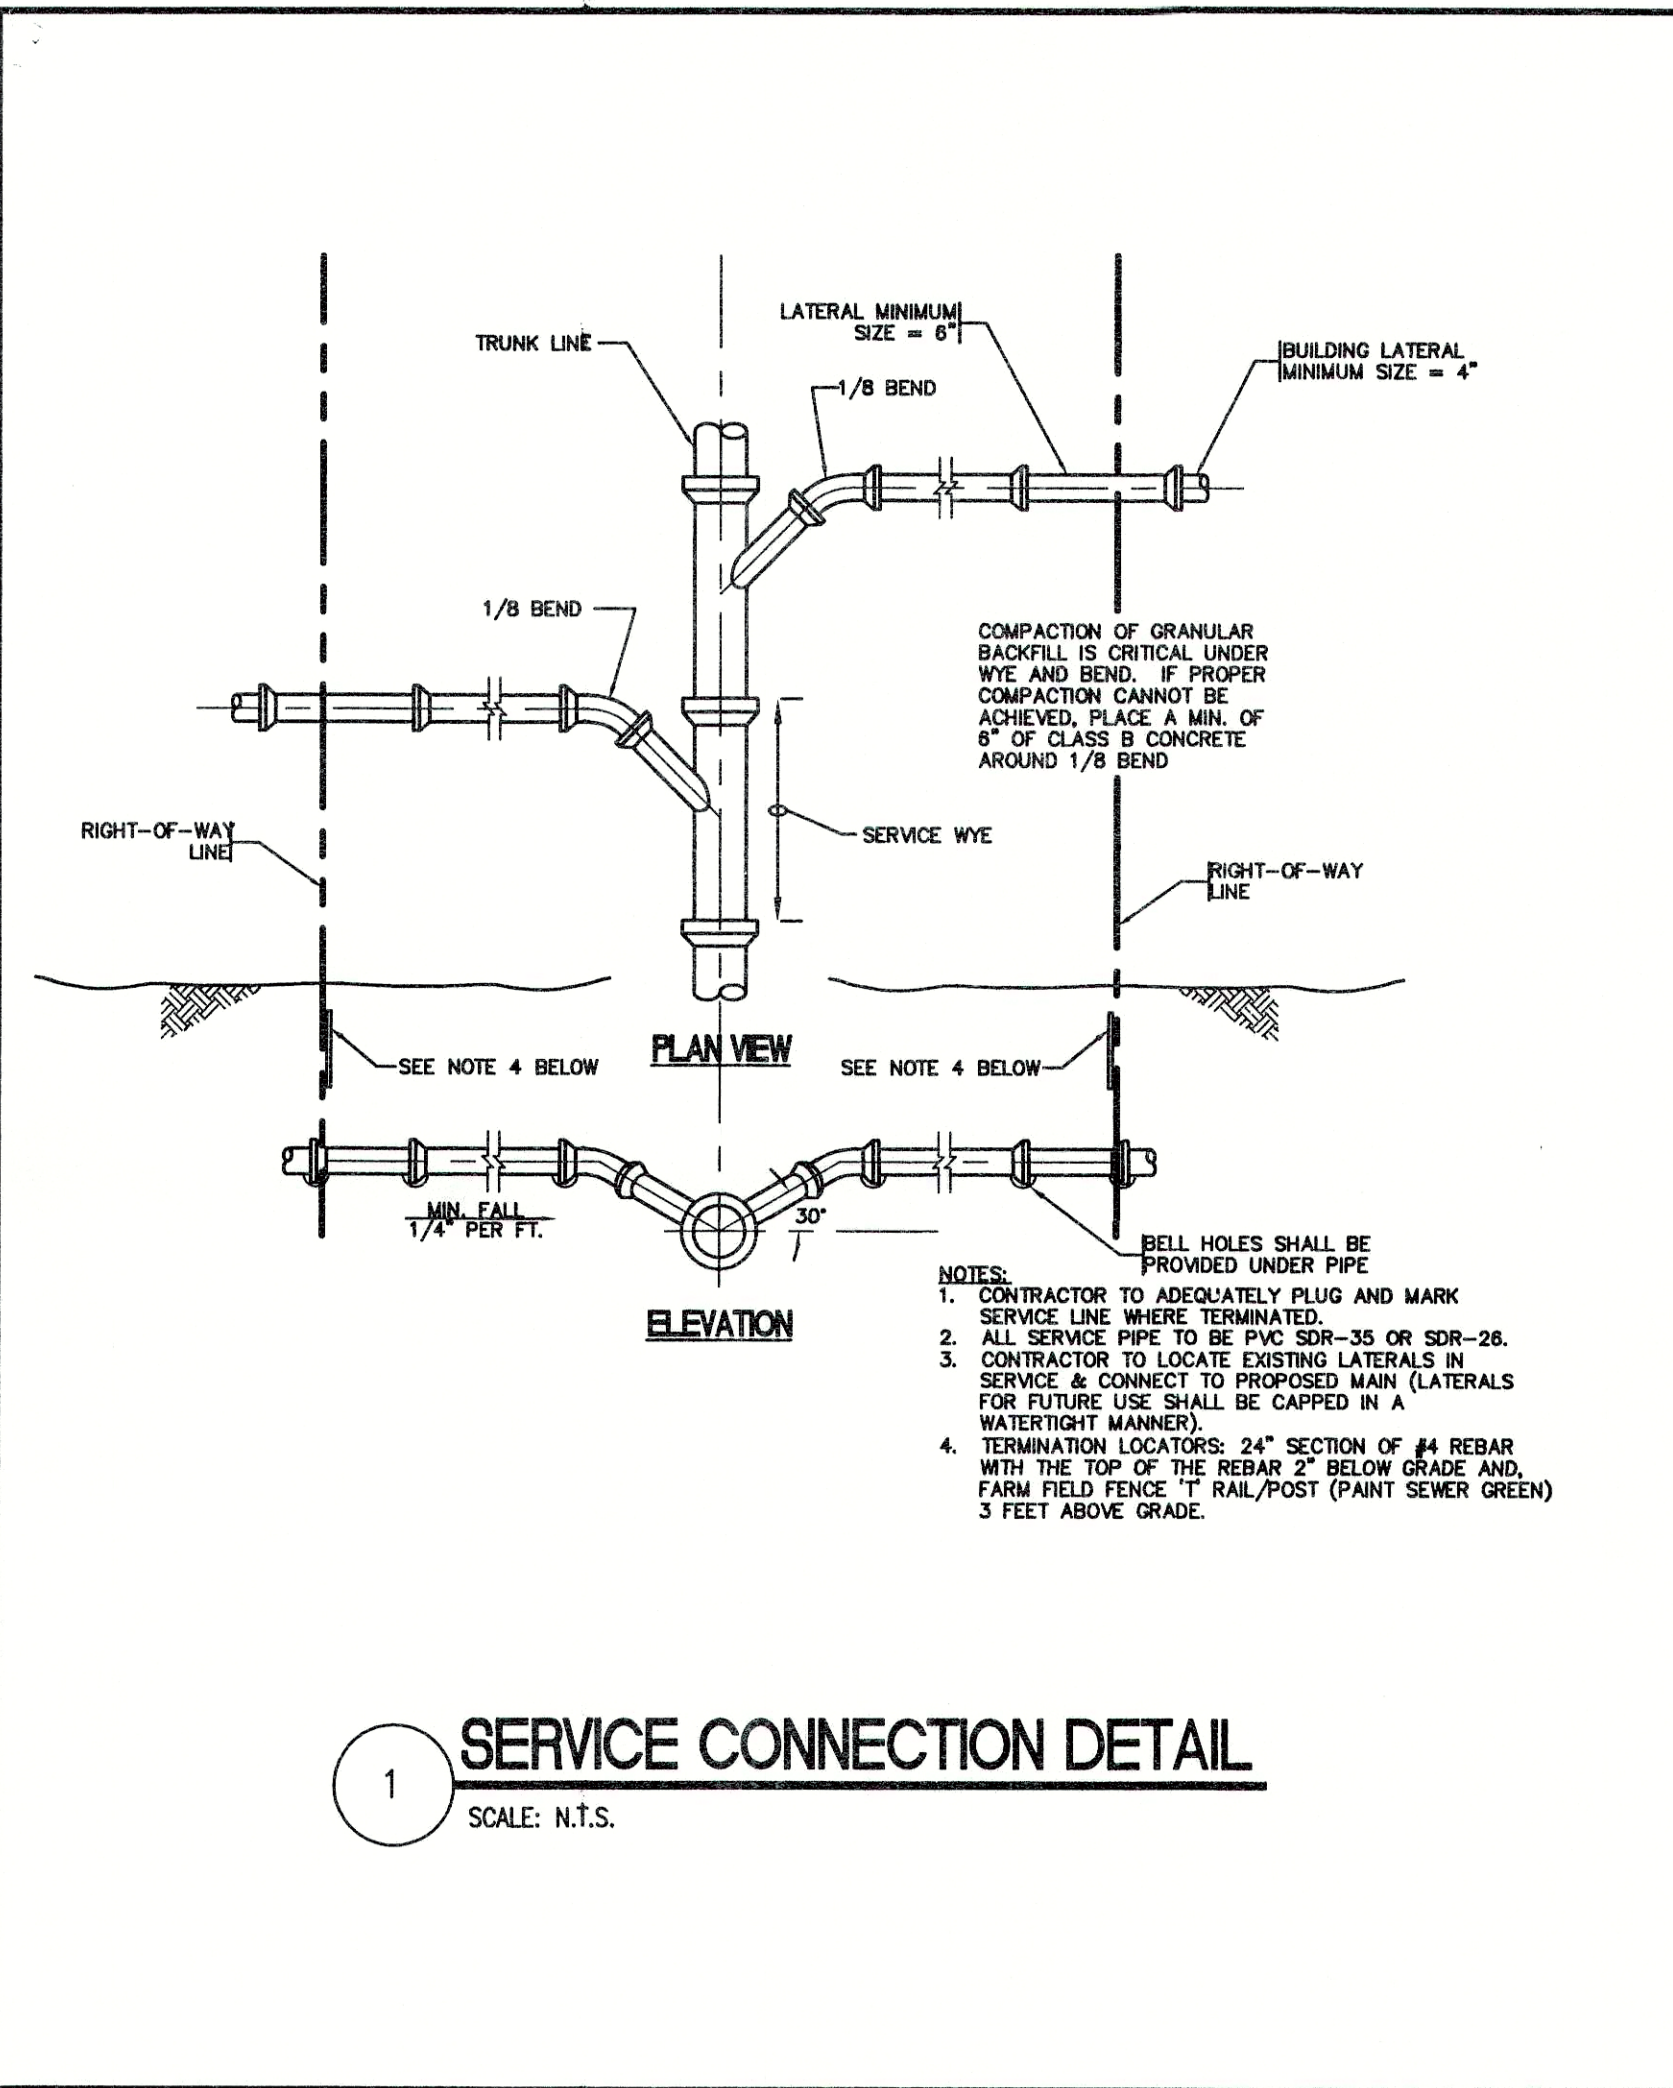

RECORD DRAWING
February 15, 2001

FILE NAME: WDRDG_D1-RD		PLOT SCALE: 1=1	PLOT DATE: 11/19
NO.	DATE	DESCRIPTION	BY

TRIAD ASSOCIATES INC.
INDIANAPOLIS, INDIANA

APPROVED BY: Thomas M. Schubert, P.E.

WOODED RIDGE SUBDIVISION
FALL CREEK REGIONAL WASTE DISTRICT
STANDARD SANITARY SEWER DETAILS

DRAWN BY: DAP
DESIGNED BY: D.A. Pauling
CHECKED BY: James W. Frazell, P.E.

DATE: 04/12/98
SCALE: AS NOTED
PROJECT No.: 98008A
SHEET No.: 17 OF 18