
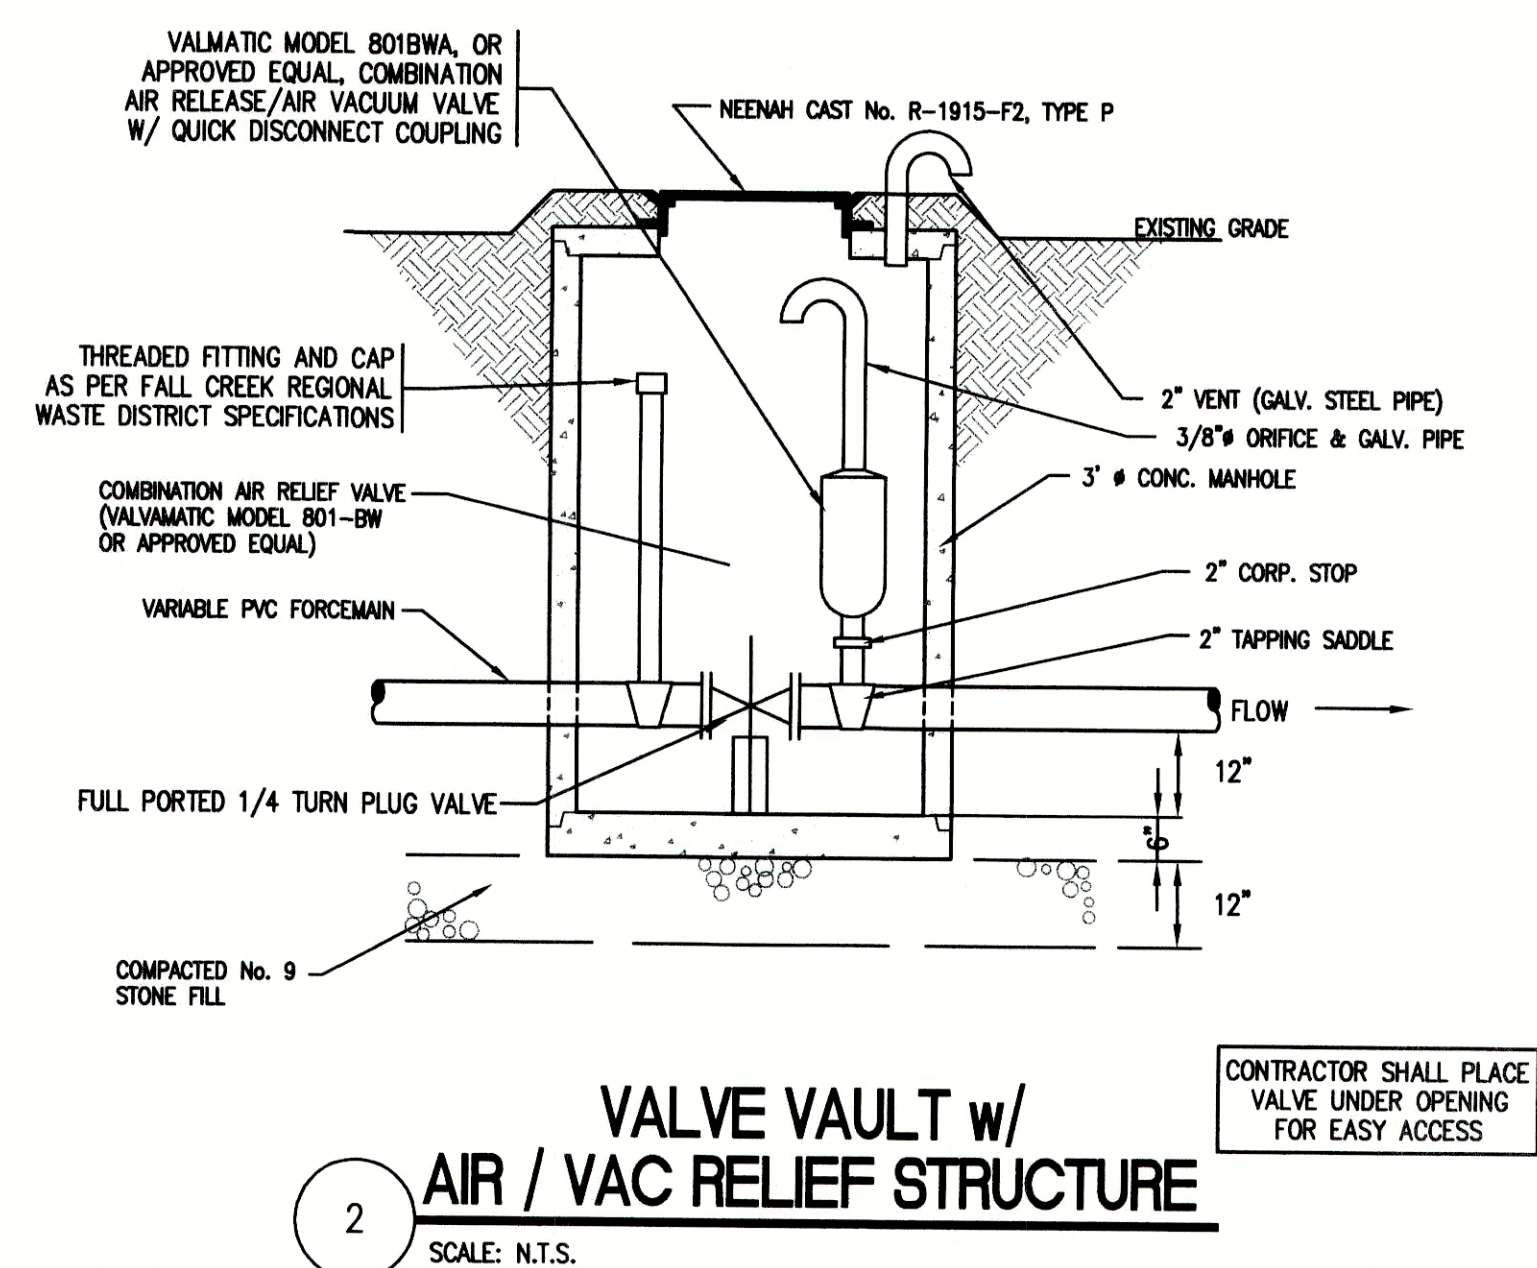


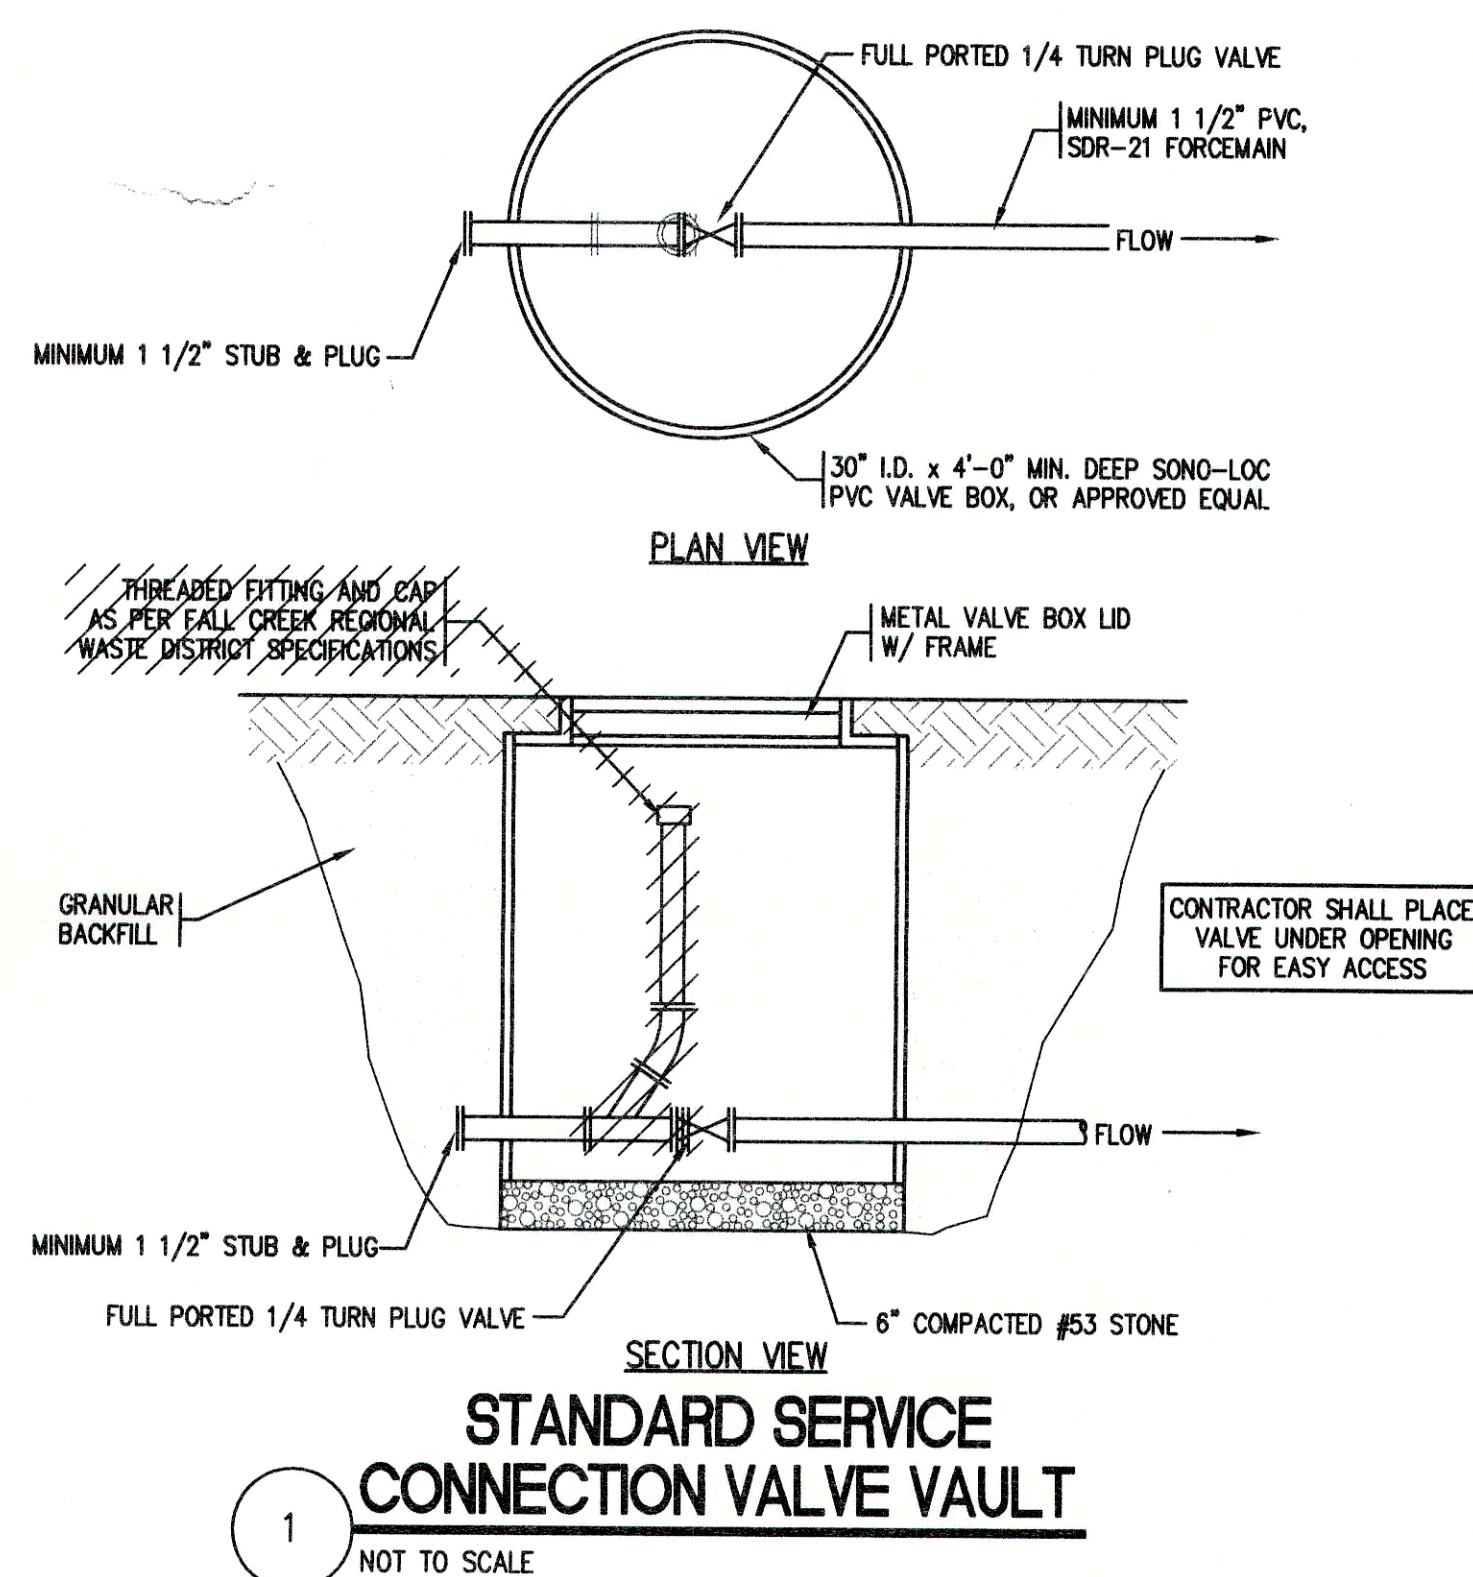

RECORD DRAWING
February 15, 2001

FILE NAME: WORDG_D2-RD		PLOT SCALE: 1=1	PLOT DATE: 12/6
NO.	DATE	DESCRIPTION	BY

TRIAD ASSOCIATES INC.
INDIANAPOLIS, INDIANA

APPROVED BY:
THOMAS M. SCHUBERT
No. 15614
STATE OF INDIANA
REGISTERED PROFESSIONAL ENGINEER

WOODED RIDGE SUBDIVISION
FALL CREEK REGIONAL WASTE DISTRICT
STANDARD SANITARY SEWER DETAILS

DRAWN BY: DAP	DATE: 04/12/98	PROJECT No. 98008A	SHEET No. 18
DESIGNED BY: D.A. Pauling	CHECKED BY: James W. Frazell, P.E.	OF 18	