



FALL CREEK REGIONAL WASTE DISTRICT

Box 44, Pendleton, Indiana 46064

2-0000320.00

This house
is in on Aram
Booth address
R4 is owner's
add.

2-0005490.00

Nº 000453

APPLICATION FOR SEWER PERMIT

Permit No. _____ Date 10-30-85
 Permit Void 90 days from Date of Issuance
 Owner Name ROBERT BILBY home
 Property Address R4 Box 264 B - Porter Cda
 Lot # _____ P.O. Box 7316 S. Woodrow Dr.
 Town PENDLETON, IN Zip Code 46064-9171
 Phone 778-2528 Water Meter _____
 \$ 150.00 Tap on Fee Paid Service address
 \$ 25.00 Inspection fee paid RR4 Box 20
Pendleton

Application is hereby made for connection to the Fall Creek Regional Waste District Sewer System for the above listed property - Permit Type: Residential ☒ Commercial _____, Industrial _____, or Governmental/Institutional _____. User Information _____.

All workmanship and materials shall conform to the standards of the District Ordinance as described in Ordinance 84-2 and 84-3 as amended. Acceptance and approval must be made by the District inspector or his duly authorized representative before backfilling and final connection is made to the main sewer lines. Any violation of applicable regulations will cause all lines and appurtenances in violation to be removed and replaced at the owners expense.

The Fall Creek Regional Waste District is responsible for the inspection, approval of materials, and installation techniques only. All costs for materials and installation and any liabilities resulting from same is the sole responsibility of the property owner.

I have read and fully understand the above provisions and agree to comply by said provisions.

Carol Bilby

APPLICANT(S) SIGNATURE

INSPECTOR DargDate inspected 11/5/85 Approved ☒ Rejected _____


Reason for rejection _____

Date reinspected _____ Approved _____ Rejected _____

Notes:

Size Pipe 6 "Type Pipe P.V.C.Basement Yes _____ No ☒Sump Pump Yes _____ No ☒Downspout to Ground Yes ☒ No _____Septic Tank Pumped & filled Yes ☒ No _____Contractor A-A BACKHOE

Special Conditions _____

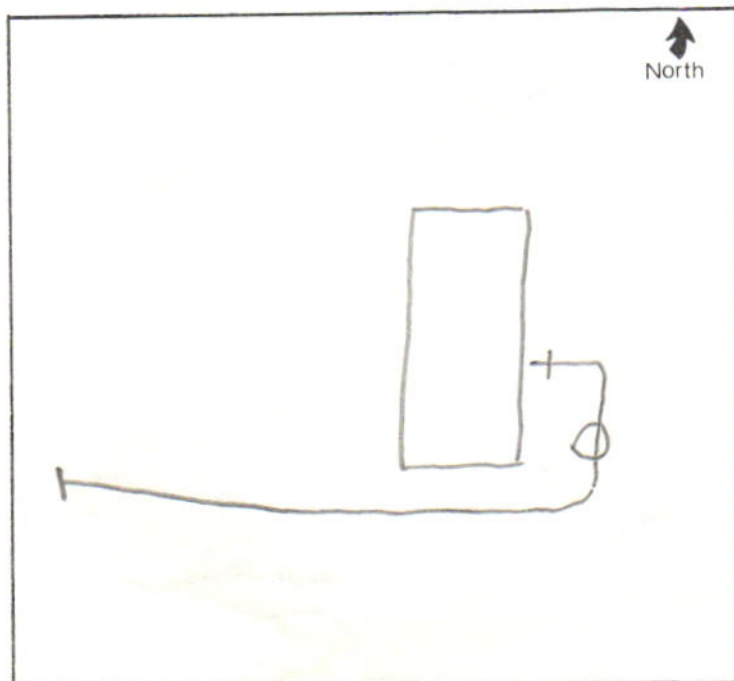

Can't find road