

FALL CREEK REGIONAL WASTE DISTRICT

9378 S. 650 West PO Box 59
Pendleton, IN 46064-0059 778-7544

26-01972.00

APPLICATION FOR SEWER PERMIT

Nº 2787

Date 5-31-00

Permit Void 90 days from Date of Issuance

Owner Name Janice & GREG STAMPER

Property Address 1000 York Drive

Lot # _____ P.O. Box _____

Town Pendleton, IN Zip Code 46064

Phone 765-778-2493 City Water Well ☒

\$ 2556.00 Tap on Fee Paid

\$ _____ ~~Inspection fee paid~~

+ grader unit - pd
contractor - Fredericks Inc.

Application is hereby made for connection to the Fall Creek Regional Waste District Sewer System for the above listed property - Permit Type: Residential X, Commercial _____, Industrial _____, or Governmental/Institutional _____. User Information _____.

All workmanship and materials shall conform to the District Ordinance as described herein. The work shall be subject to the acceptance and approval of the City Engineer or his authorized representative before the work is accepted. All lines and appurtenances shall be installed in accordance with the plans and specifications to the main sewer lines. All work shall be done at the owners expense.

TANK NOT
PUMPED?

the standards of the
d 84-3 as amended.
inspector or his duly
al connection is made
regulations will
removed and replaced

The Fall Creek Regional [redacted] responsible for the inspection, approval of materials, and installation techniques only. All costs for materials and installation and any liabilities resulting from same is the sole responsibility of the property owner.

I have read and fully understand the above provisions and agree to comply by said provisions.

Janice Slamper
APPLI

APPLICANT(S) SIGNATURE

Date inspected 24/11/2018 Approved ✓ Rejected ○

Reason for rejection _____

Date reinspected	Approved	Rejected

Notes: 4" DC

Type Pipe 1 1/2 160 PSI

Basement Yes No ☒

Sump Pump Yes No ☒

Downspout to Ground Yes / No


Septic Tank ~~pumped~~ & filled/Yes No

Contractor Jim Mercer (FREDRICKS)

Special Conditions

Existing Home ✓

New Construction

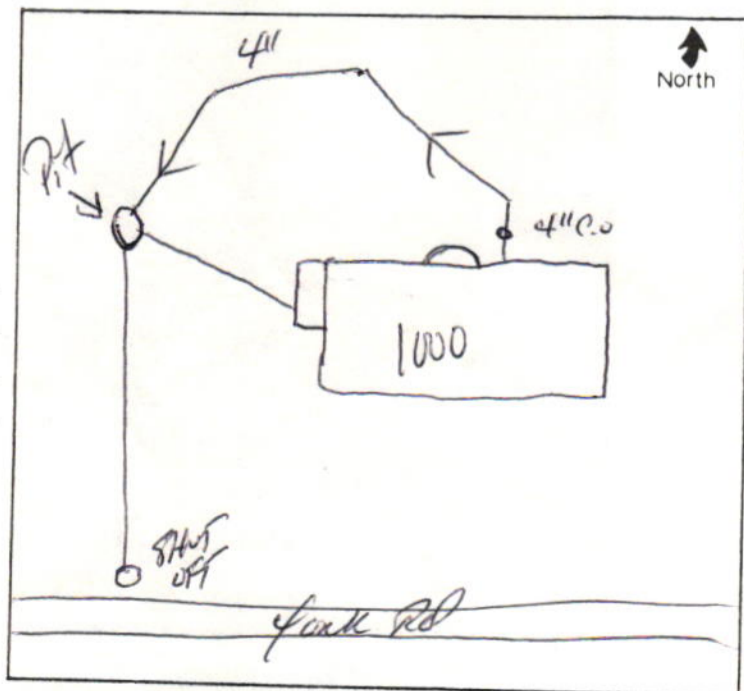

9378 S. CR 650 W.
P.O. Box 59
Pendleton, IN 46064
Phone: 765-778-7544

INVOICE

Customer		Project Area # E	
Name	Gregory Stamper	Acct #	26-01972.00
Address	1000 York Drive		W.O. #
City	Pendleton	State	IN
Phone		Zip	46064
			Due Date 90 days

DATE	PAYMENT	CHECK NUMBER	AMOUNT
	less payment of interim bill		\$382.90
	as of 5/24/00		
		Sub-Total	\$382.90

Cut here

Customer					
Name	Gregory Stamper	Acct #	26-01972.00	Project Area #	E
Address	1000 York Drive			W.O. #	
City	Pendleton	State	IN	Zip	46064
Phone				Due Date	90 days
			0		
				Amount Due	\$2,173.10