



FALL CREEK REGIONAL WASTE DISTRICT

9378 S. 650 West PO Box 59
Pendleton, IN 46064-0059 778-7544

add order
on file
26-01976.00

APPLICATION FOR SEWER PERMIT

Nº 2861

Date Aug 8th, 2000

Permit Void 90 days from Date of Issuance

Owner Name Ivan Wagner

Property Address 1003 YORK DRIVE, Pendleton

Lot # _____ P.O. Box _____

Town _____, IN Zip Code 46064

Phone 778-4804 City Water _____ Well ☒

\$ 2556 Tap on Fee Paid

\$ _____ ~~Inspection fee~~ paid

grinder unit pd.
Mahurin - Contractor

Application is hereby made for connection to the Fall Creek Regional Waste District Sewer System for the above listed property - Permit Type: Residential ☒, Commercial _____, Industrial _____, or Governmental/Institutional _____. User Information _____.

All workmanship and materials shall conform to the standards of the District Ordinance as described in 84-3 as amended. Acceptance and approval must be given by the inspector or his duly authorized representative before connection is made to the main sewer lines. All regulations will be removed and replaced at the owners expense.

The Fall Creek Regional Waste District is responsible for the inspection, approval of materials, and installation only. All costs for materials and installation and any liability resulting from same is the sole responsibility of the property owner.

I have read and fully understand the above provisions and agree to comply by said provisions.

Ivan Wagner
APPLICANT(S) SIGNATURE

INSPECTOR [Signature]

Date inspected 8-22-00 Approved ☒ Rejected _____

Reason for rejection _____

Date reinspected _____ Approved _____ Rejected _____

Notes: 1 1/2" PM / 4" LMS

Size Pipe 160 / PC35

Type Pipe _____

Basement Yes _____ No ☒

Sump Pump Yes _____ No ☒

Downspout to Ground Yes ☒ No _____


Septic Tank Pumped & filled Yes _____ No ☒

Contractor ONE SOURCE DRIVING

Special Conditions (BORE 1 1/2" PM)


Existing Home _____

New Construction _____

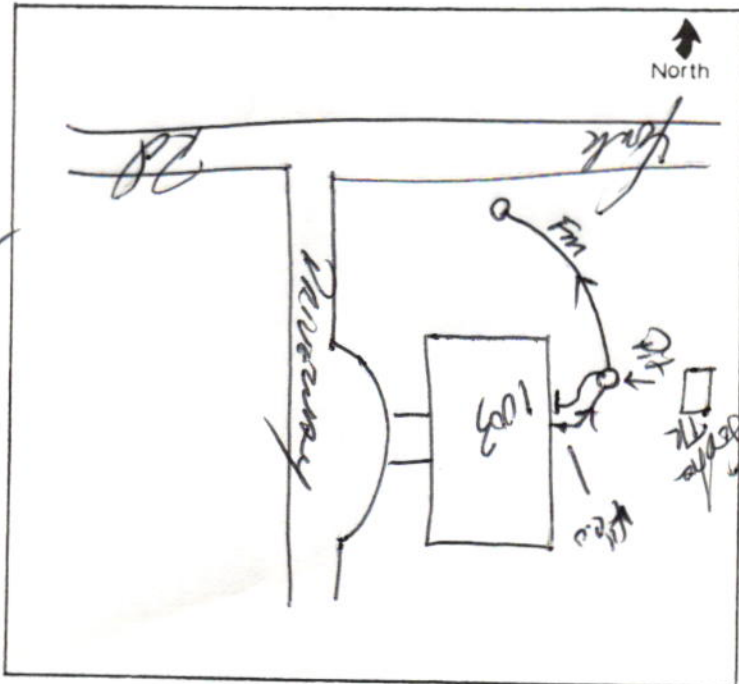

2630

IVAN D. & JUDITH E. WAGNER 8-87
1003 YORK DR PH 765-778-4804
PENDLETON, IN 46064

DATE Aug. 8, 200071-553/749
BRANCH 0PAY TO THE ORDER OF Fall Creek Regional Waste District \$3,143²⁰Three thousand, one hundred forty-three ²⁰/₁₀₀ — DOLLARS  Security features included. Details on back.Madison
Community BankThe
CLASSICFOR Drum Pump & fees

⑆074905539⑆

Judith E. Wagner ^{MR}
2630

© HARLAND 1995

9378 S. CR 650 W.
P.O. Box 59
Pendleton, IN 46064
Phone: 765-778-7544

INVOICE

Name	Ivan Wagner	Acct #	26-01976.00
Address	1003 York Drive		
City	Pendleton	State	IN Zip 46064
Phone			

QTY	DESCRIPTION	UNIT PRICE	TOTAL
1	tap fee	\$400.00	\$400.00
1	capacity fee	\$2,156.00	\$2,156.00
		Sub-Total	\$2,556.00

DATE	PAYMENT	CHECK NUMBER	AMOUNT
	less payment of interim bill		
	as of 5/24/00		437.60
		Sub-Total	\$0.00

Detach bottom portion and return with payment

Cut here

Name	Ivan Wagner	Acct #	26-01976.00
Address	1003 York Drive		
City	Pendleton	State	IN Zip 46064
Phone	0		

Project Area # E
W.O. #
Due Date 90 days

Amount Due	\$2,556.00
------------	------------