

9378 S 650 WEST, P.O. BOX 59, PENDLETON, IN 46064

765-778-7544

## AGREEMENT FOR SANITARY SEWER SERVICE

This Agreement made and entered into this 24 day of 11/14, 2006 between FALL CREEK REGIONAL WASTE DISTRICT ("District") and Hallmark Homes, Inc. ("Applicant") regarding the provision of sanitary sewer service, and the assignment of capacity in, and connection to, the District's facilities for the premises located at Hickory Hills 10+26.

**NOW THEREFORE**, the parties, in consideration of the mutual promises set out in this Agreement, the receipt and sufficiency of which is hereby acknowledged, agree as follows:

1. The Applicant agrees that all workmanship and materials shall conform to all District ordinances and the District's construction standards. District must accept and approve all work and materials before backfilling and final connection is made to the sewer mains. Any violation of this provision will cause all lines and appurtenances in violation to be removed and replaced at the Applicant's expense.
2. The District shall have the right to enter upon the Applicant's premises at all reasonable times to inspect, repair, or replace any equipment used in connection with the District's service or which has an impact on said service.
3. The Applicant shall be responsible for all monthly user rates, capacity charges, and tap fees. The failure to pay any rate charge or fee may result in a lien against the property and/or the termination of service to the property, the cost of which will be borne by Applicant, including, but not limited to, all attorney's fees and collection costs.
4. The District shall not be responsible for any damages as a result of any failure to supply service unless said damages are due to default, neglect or culpability on the part of the District.
5. If there is an available sanitary sewer within three hundred (300) feet of the property line, the property owner shall be required to connect to the District's sanitary sewer system.
6. The Applicant and District agree that the provision of sanitary sewer service touches and concerns the property and the terms of this Agreement bind the District and Applicant and their heirs, executors, administrators, personal representatives, successors, agents, attorneys, assigns, designees, and transferees.

The parties hereto have read and fully understand the above provisions and agree to comply with said provisions.

FALL CREEK REGIONAL WASTE DISTRICT  
*Robert Wilson*  
 Signature

APPLICANT  
Signature Fullmark Homes Lilly Wilson

STATE OF INDIANA )  
 ) SS:  
COUNTY OF MADISON)

SUBSCRIBED and sworn to before me this 24 day of May, 2006

My Commission Expires: \_\_\_\_\_

My Commission Expires:  
2-20-2008

Signature

Printed

Notary Public  
Resident of Madison County

INSPECTOR T DATE INSPECTED 9-15-06 APPROVED — REJECTED —

REASON FOR REJECTION

DATE REINSPECTED	APPROVED	REJECTED
------------------	----------	----------

NOTES:

SIZE PIPE 6" TYPE PIPE SDR 35

BASEMENT YES NO ☒

SUMP PUMP YES NO ☒

DOWNSPOUT TO GROUND YES ☒ NO


SEPTIC TANK PUMPED &amp; FILLED YES NO

CONTRACTOR Itall Mark

SPECIAL CONDITIONS

## EXISTING HOME

NEW CONSTRUCTION

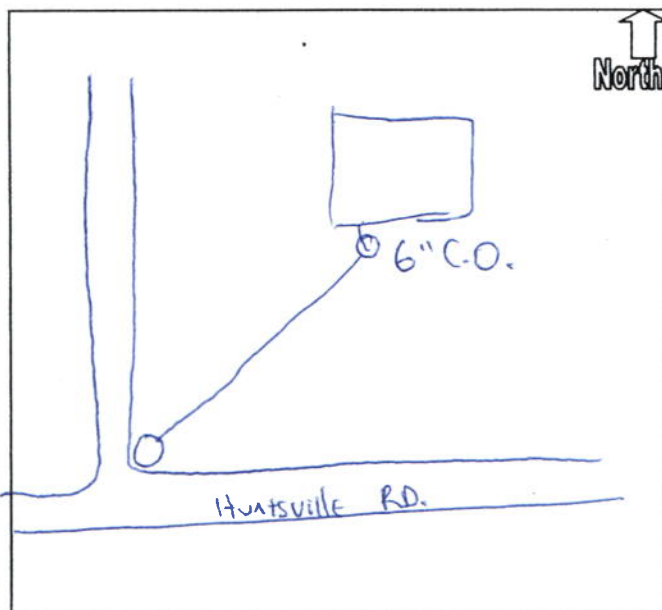

HALLMARK HOMES, INC.  
433 E. 53RD STREET  
ANDERSON, IN 46013  
(765) 644-6566

STAR FINANCIAL BANK  
INDIANAPOLIS, IN 46255  
71-167749

87928


5/23/2006

PAY TO THE ORDER OF Fall Creek Regional Waste

\$ \*\*2,635.00

Two Thousand Six Hundred Thirty-Five and 00/100\*\*\*\*\* DOLLARS

Fall Creek Regional Waste

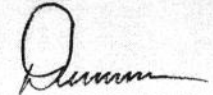

MEMO

⑈087928⑈ ⑆074901672⑆

⑈11038097⑈

HALLMARK HOMES, INC.

Fall Creek Regional Waste

COST OF SALES:SITE IMPROVEMENTS:8020 Huntzinger sewer tap

5/23/2006

87928

2,635.00

Hallmark Homes Inc.- Star

2,635.00